


of

a subdivision recorded September 18, 1972 in Vol. 17 of Plats of Walworth County on Page 6 as Document Number 654824 and located in the Southeast 1/4 of the Southeast 1/4 of Section 34, Town 4 North, Range 16 East, Town of LaGrange, Walworth County, Wisconsin.

Bearings referenced to the plat of Cool Hill Park Addition No. 2 as shown on prior surveys.

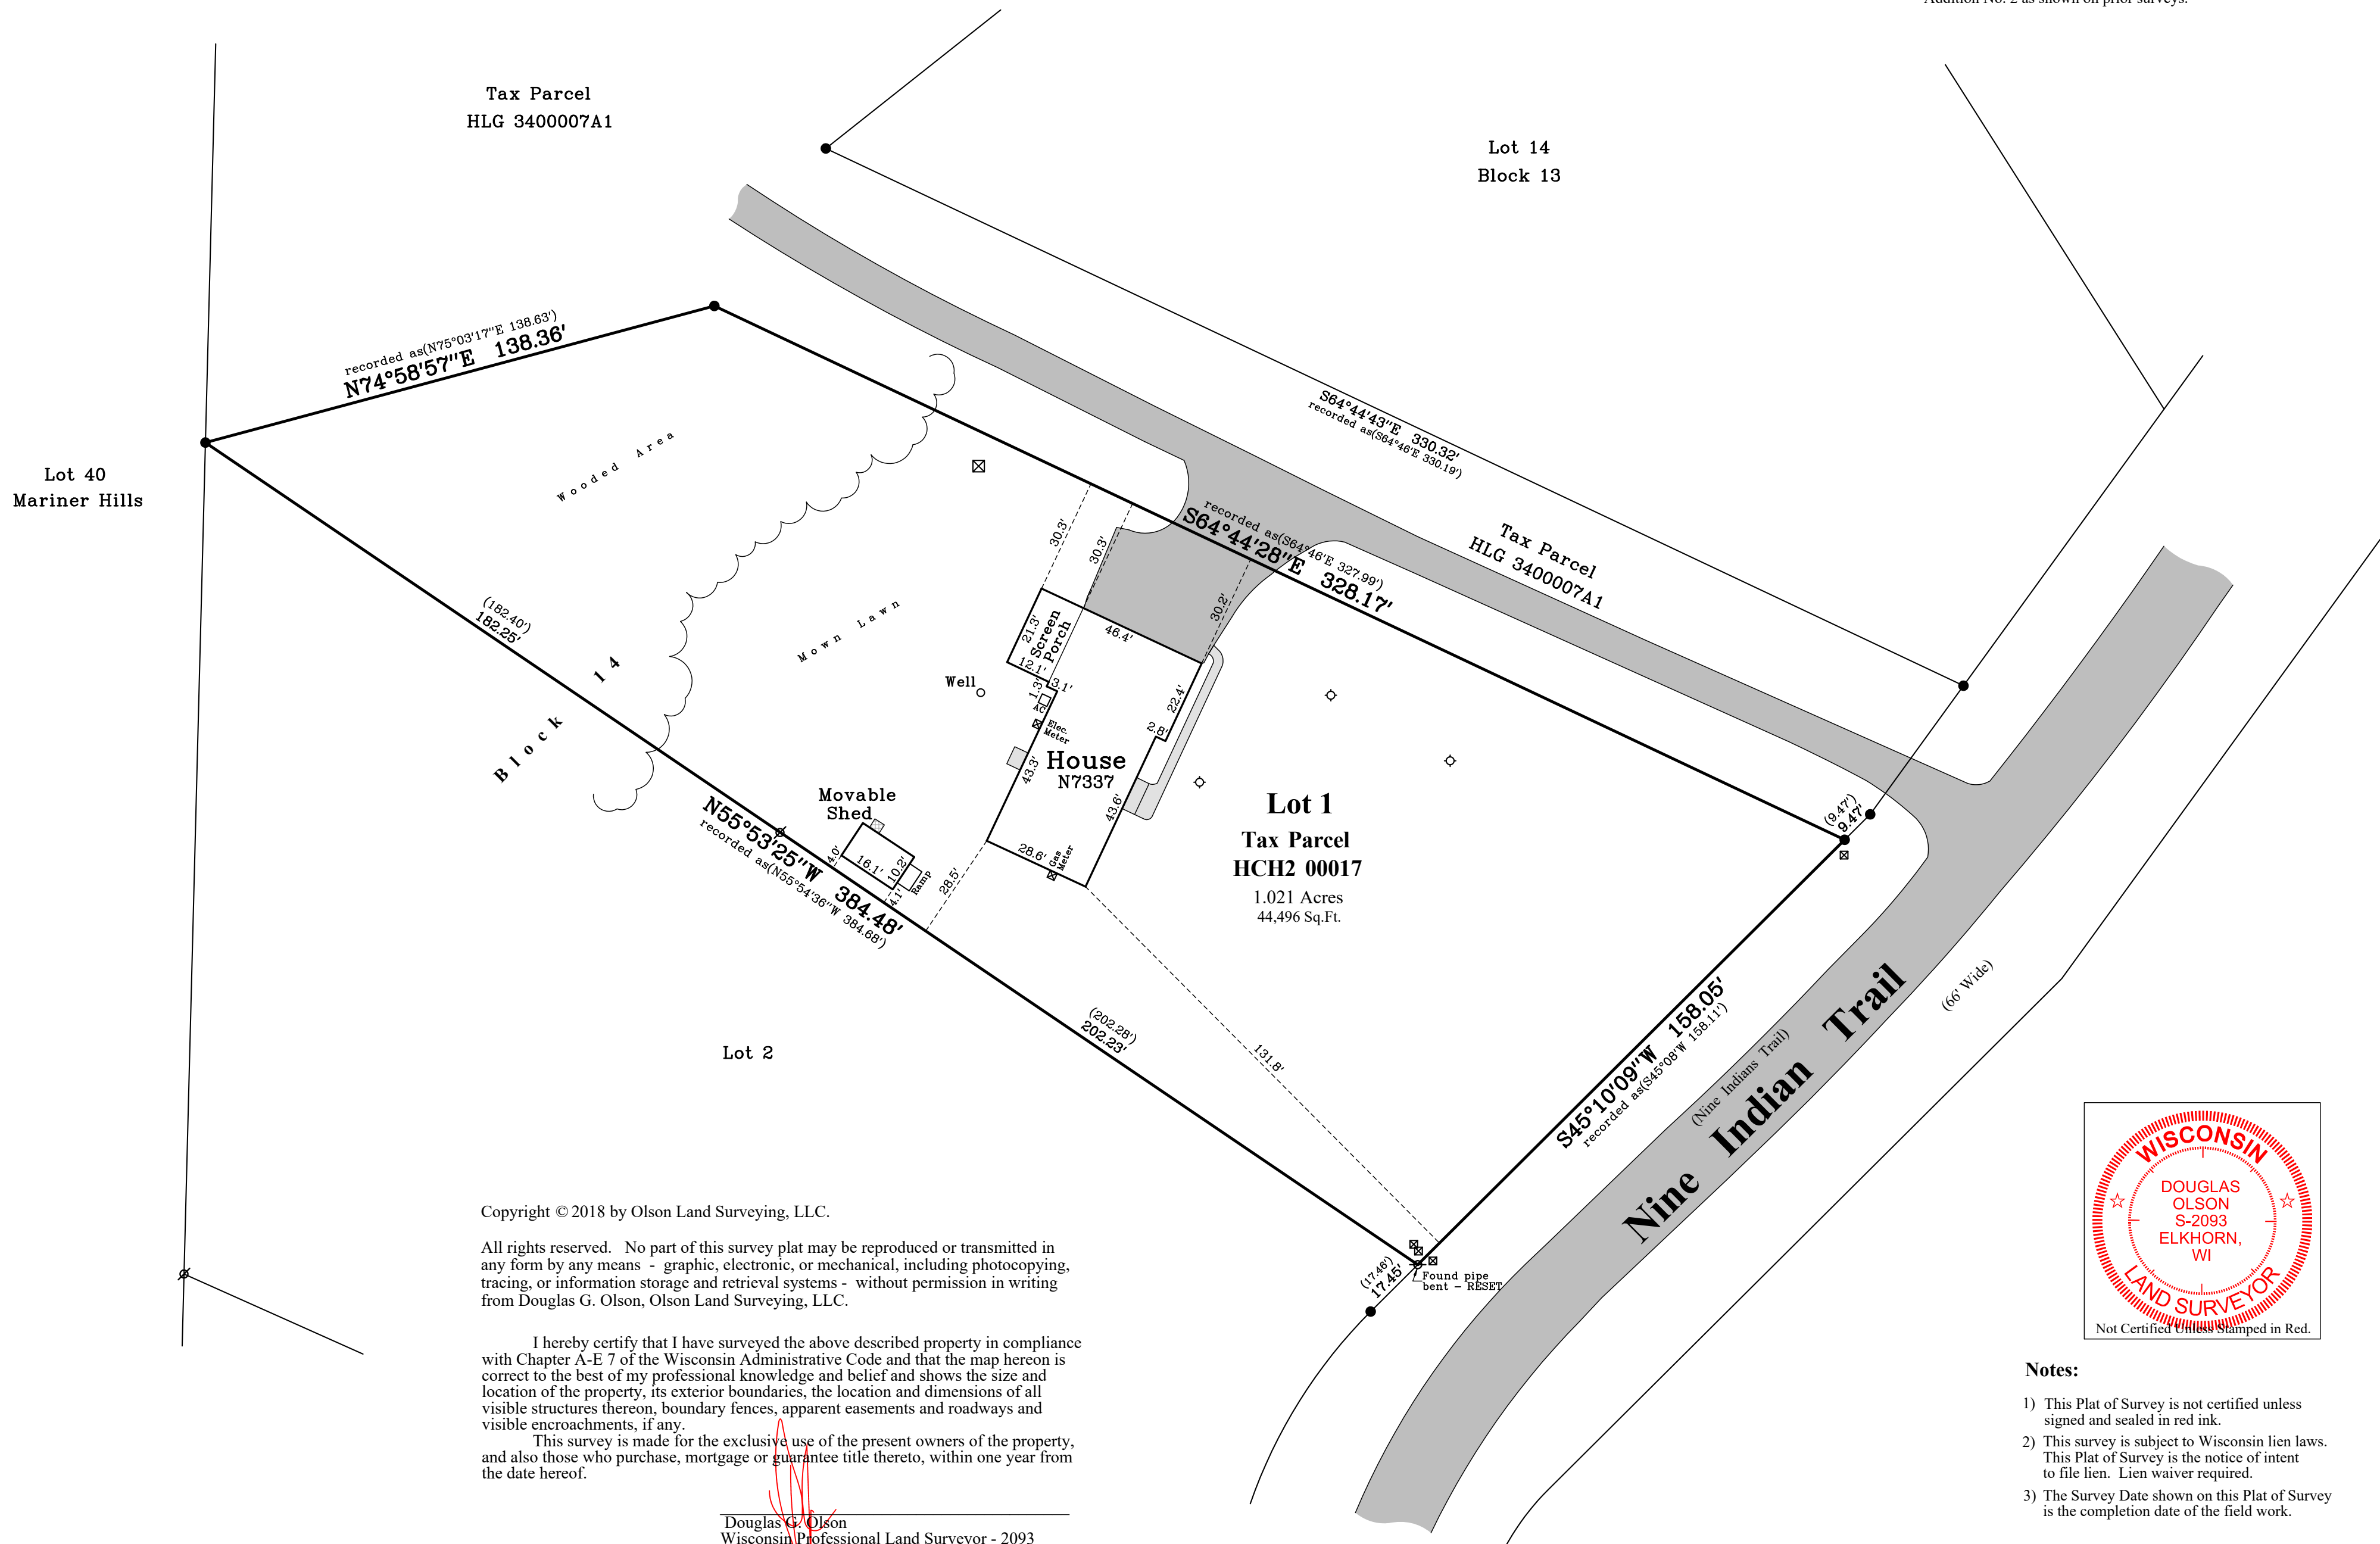

Copyright © 2018 by Olson Land Surveying, LLC.

All rights reserved. No part of this survey plat may be reproduced or transmitted in any form by any means - graphic, electronic, or mechanical, including photocopying, tracing, or information storage and retrieval systems - without permission in writing from Douglas G. Olson, Olson Land Surveying, LLC.

I hereby certify that I have surveyed the above described property in compliance with Chapter A-E 7 of the Wisconsin Administrative Code and that the map hereon is correct to the best of my professional knowledge and belief and shows the size and location of the property, its exterior boundaries, the location and dimensions of all visible structures thereon, boundary fences, apparent easements and roadways and visible encroachments, if any.

This survey is made for the exclusive use of the present owners of the property, and also those who purchase, mortgage or guarantee title thereto, within one year from the date hereof.

Douglas G. Olson
Wisconsin Professional Land Surveyor - 2093

Survey Date: July 2, 2018.


Revisions:	No. 1 – Proposed Porch Addition
	No. 2 – Proposed Shed
	No. 3 – Proposed Shed Moved
	No. 4 – As-Built Porch & Shed

Scale in Feet
1" = 30'



A horizontal graphic scale bar with alternating black and white segments. The segments are labeled from left to right: 0', 15', 30', 60', and 90'. The bar is divided into four equal segments, each representing 15 feet. The first segment (0' to 15') is white, the second (15' to 30') is black, the third (30' to 60') is white, and the fourth (60' to 90') is black.

45 South Wisconsin Street | P.O. Box 322
Elkhorn, Wisconsin. 53121
Telephone: (262) 723-3434
Facsimile: (262) 723-8044
Email: doug@olsonsurveying.com
Website: www.olsonsurveying.com

 

OLSON
LAND SURVEYING, LLC
Rural | Residential | Commercial

Legend		List of Symbols and Abbreviations	
Ø	Found Iron Pipe	N	North
○	Found Iron Pipe, 1-3/16" dia.	E	East
○	Set Iron Pipe, 1" dia.	W	West
○	Recorded Information	In	In Bearings
○	Utility Box or Pedestal	D	Degrees
○	Concrete Cover	"	Minutes
○	Septic Vent	"	Seconds
○	Asphalt Surface	In	In Distances
○	Concrete Surface	"	Feet
○	Brick Surface	"	Inches

Sheet 1 of 1 Sheets

Drawing Name:

Job Reference Number

2025.066

025.066

Notes:

- 1) This Plat of Survey is not certified unless signed and sealed in red ink.
- 2) This survey is subject to Wisconsin lien laws. This Plat of Survey is the notice of intent to file lien. Lien waiver required.
- 3) The Survey Date shown on this Plat of Survey is the completion date of the field work.