

PLAT OF SURVEY  
OF LOTS 3-5, DROUGHTVILLE PARK, BEING PART OF  
THE SW 1/4 OF THE SW 1/4 OF SECTION 25, T. 4 N., R. 16 E.,  
OF THE 4TH P.M., TOWN OF LAGRANGE, WALWORTH COUNTY, WISCONSIN.



*Kristin J. Belongia*

Kristin J. Belongia, P.L.S.  
Wisconsin Professional Land Surveyor S-2943

State of Wisconsin } ss  
County of Walworth }


I hereby certify that I have supervised the survey of the property described above and to the best of my knowledge and belief, the plat drawn hereon complies with Chapter A-E 7 of the State of Wisconsin Administrative Code, Minimum Standards for Property Surveys and correctly represents said survey and its location.  
Given under my hand and seal at Elkhorn, Wisconsin this 13th day of February, 2025.  
Last day of field work February 10th, 2025.  
Revised to show As-Built Residence Foundation November 18, 2025

If the surveyor's signature is not red in color, the plan is a copy that should be assumed to contain unauthorized alterations. The certification contained on this document shall not apply to any copies.

- LEGEND
- Existing Boundary Line
  - Existing Right-of-Way
  - Existing Adjacent Property
  - Existing Fence
  - Existing Overhead Power
  - Record Information
  - 3/4" Iron Rebar Found
  - Iron Pipe Found
  - Existing Mailbox
  - Existing Ground Light
  - Existing Utility Pole
  - Existing Guy Wire

SURVEY NOTES

- SURVEYED PROPERTY SUBJECT TO ANY AND ALL EASEMENTS AND AGREEMENTS RECORDED AND UNRECORDED.
- THIS SURVEY IS A RETRACEMENT OF A PLAT OF SURVEY PREPARED BY FARRIS, HANSEN & ASSOCIATES DATED JUNE 11, 2012.
- NO TREES HAVE BEEN LOCATED AS PART OF THIS SURVEY.

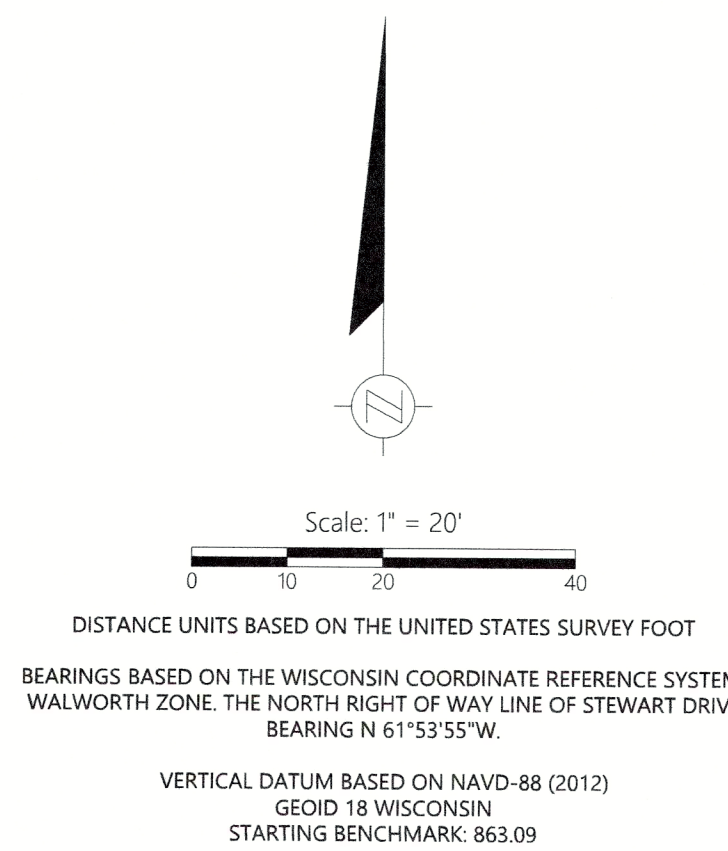

FOR THE EXCLUSIVE USE OF:  
Premier Homes 1, Inc.  
PO Box 15  
Elkhorn, WI 53121

ORDER NO. 35393A  
FIELD CREW: JPL / BMR  
DRAWN BY: JPL / BMR  
SHEET 1 OF 1

File Name: 135393A - 35393A.DWG - Premier Homes LOT 3-5 DRAINAGE.DWG  
Date: 1/13/25

PLAT OF SURVEY

**Batterman**  
engineers surveyors planners  
BELOIT | ELKHORN | JANESVILLE  
2857 S Bartels Dr., Beloit, WI 53511  
608.365.4464 | www.batterman.com

