
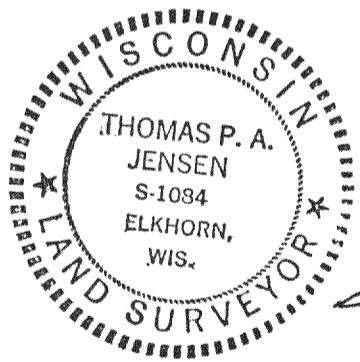


PLAT OF SURVEY

OF
 LOT 71 OF LAUNDERDALE HEIGHTS, A SUBDIVISION LOCATED
 IN SECTION 36, T4N R16E, WALKWORTH COUNTY, WISCONSIN.

Surveyed for
 SUE STASTROM
 COLONEY REALTY
 16 E. WALWORTH ST.
 ELKHORN, WISC. 53121

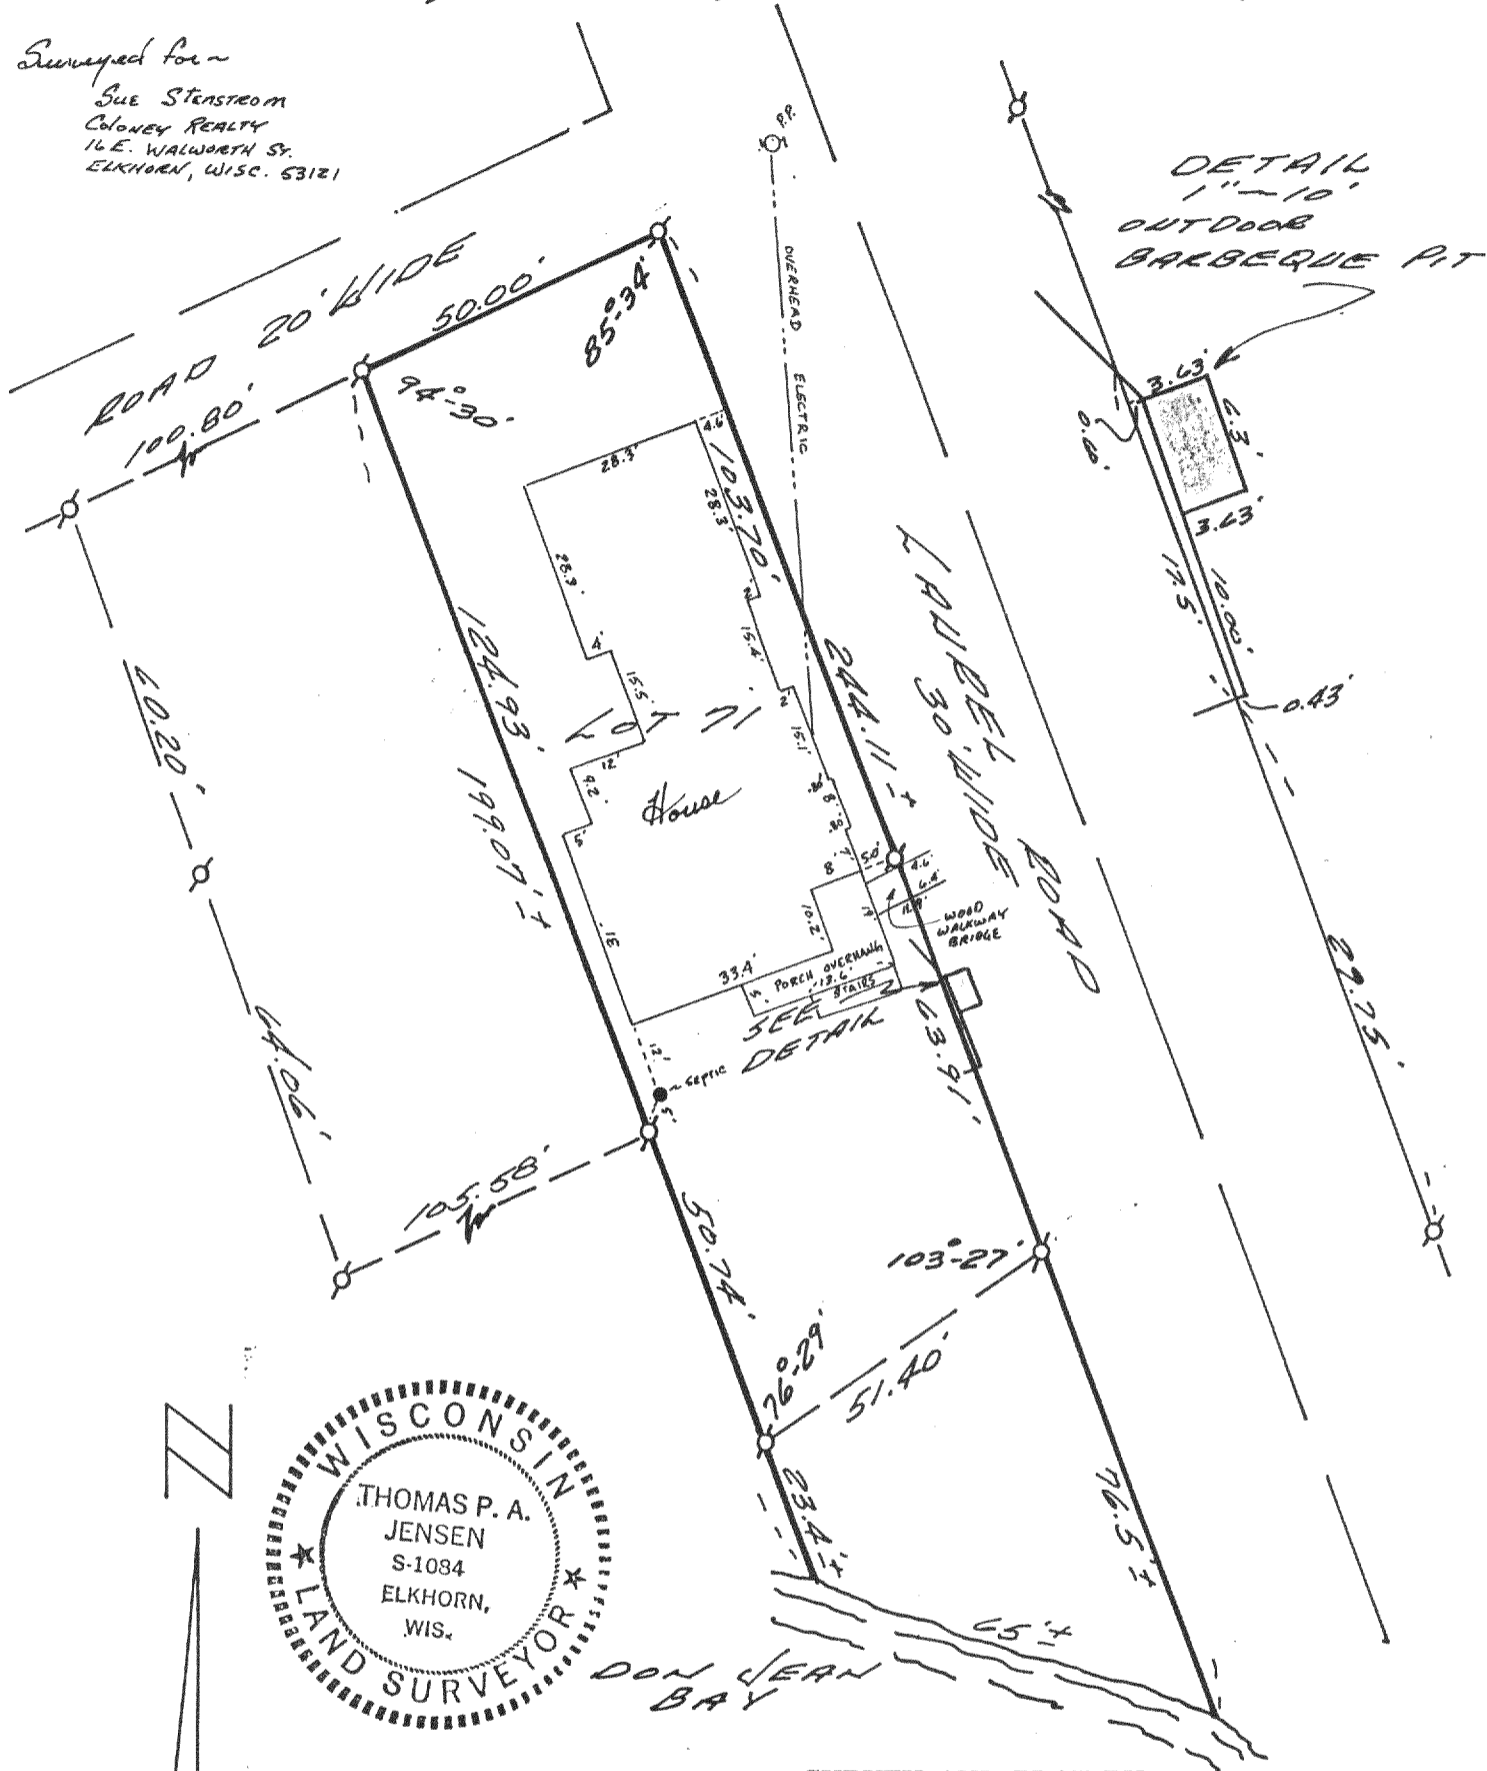

DON JEAN BAY

SURVEY AND PLAT BY

JENSEN SURVEYING & MAPPING S.C.

P.O. BOX 322

45 S. WISCONSIN ST.

Elkhorn, Wisconsin 53121

LEGEND

- — Iron Pipe SET
- — Concrete Monument

Scale 1" = 30'


⊕ — IRON PIPE FOUND

WE CERTIFY: That we have surveyed the above described property and that the plat shown hereon is an accurate survey and a true representation thereof and correctly shows the exterior boundary lines and all divisions of said property, ALL BUILDING HEREON.

Date AUGUST 20, 1985

Thomas P. A. Jensen

Wisconsin Registered Land Surveyor, S-1084

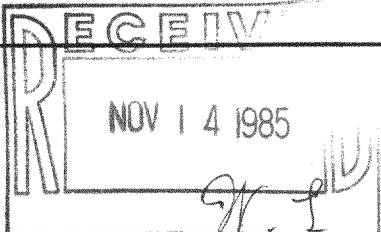

1985.070

416-361 ✓