


Plat of Survey

of


Lot 2 in Block 13 of Cool Hill Park Addition No. 2,

recorded September 18, 1972 in Vol. 17 of Plats of Walworth County on Page 6 as Document Number 654824 and located in the Southeast 1/4 of the Southeast 1/4 of Section 34, Town 4 North, Range 16 East, Town of LaGrange, Walworth County, Wisconsin.

Surveyed for: **Ralph Mispagel**
N7332 Nine Indian Trail
Elkhorn, Wisconsin. 53121

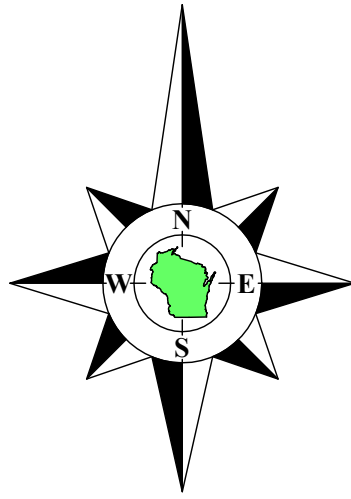

Bearings referenced to the plat of Cool Hill Park Addition No. 2 as shown on prior surveys.

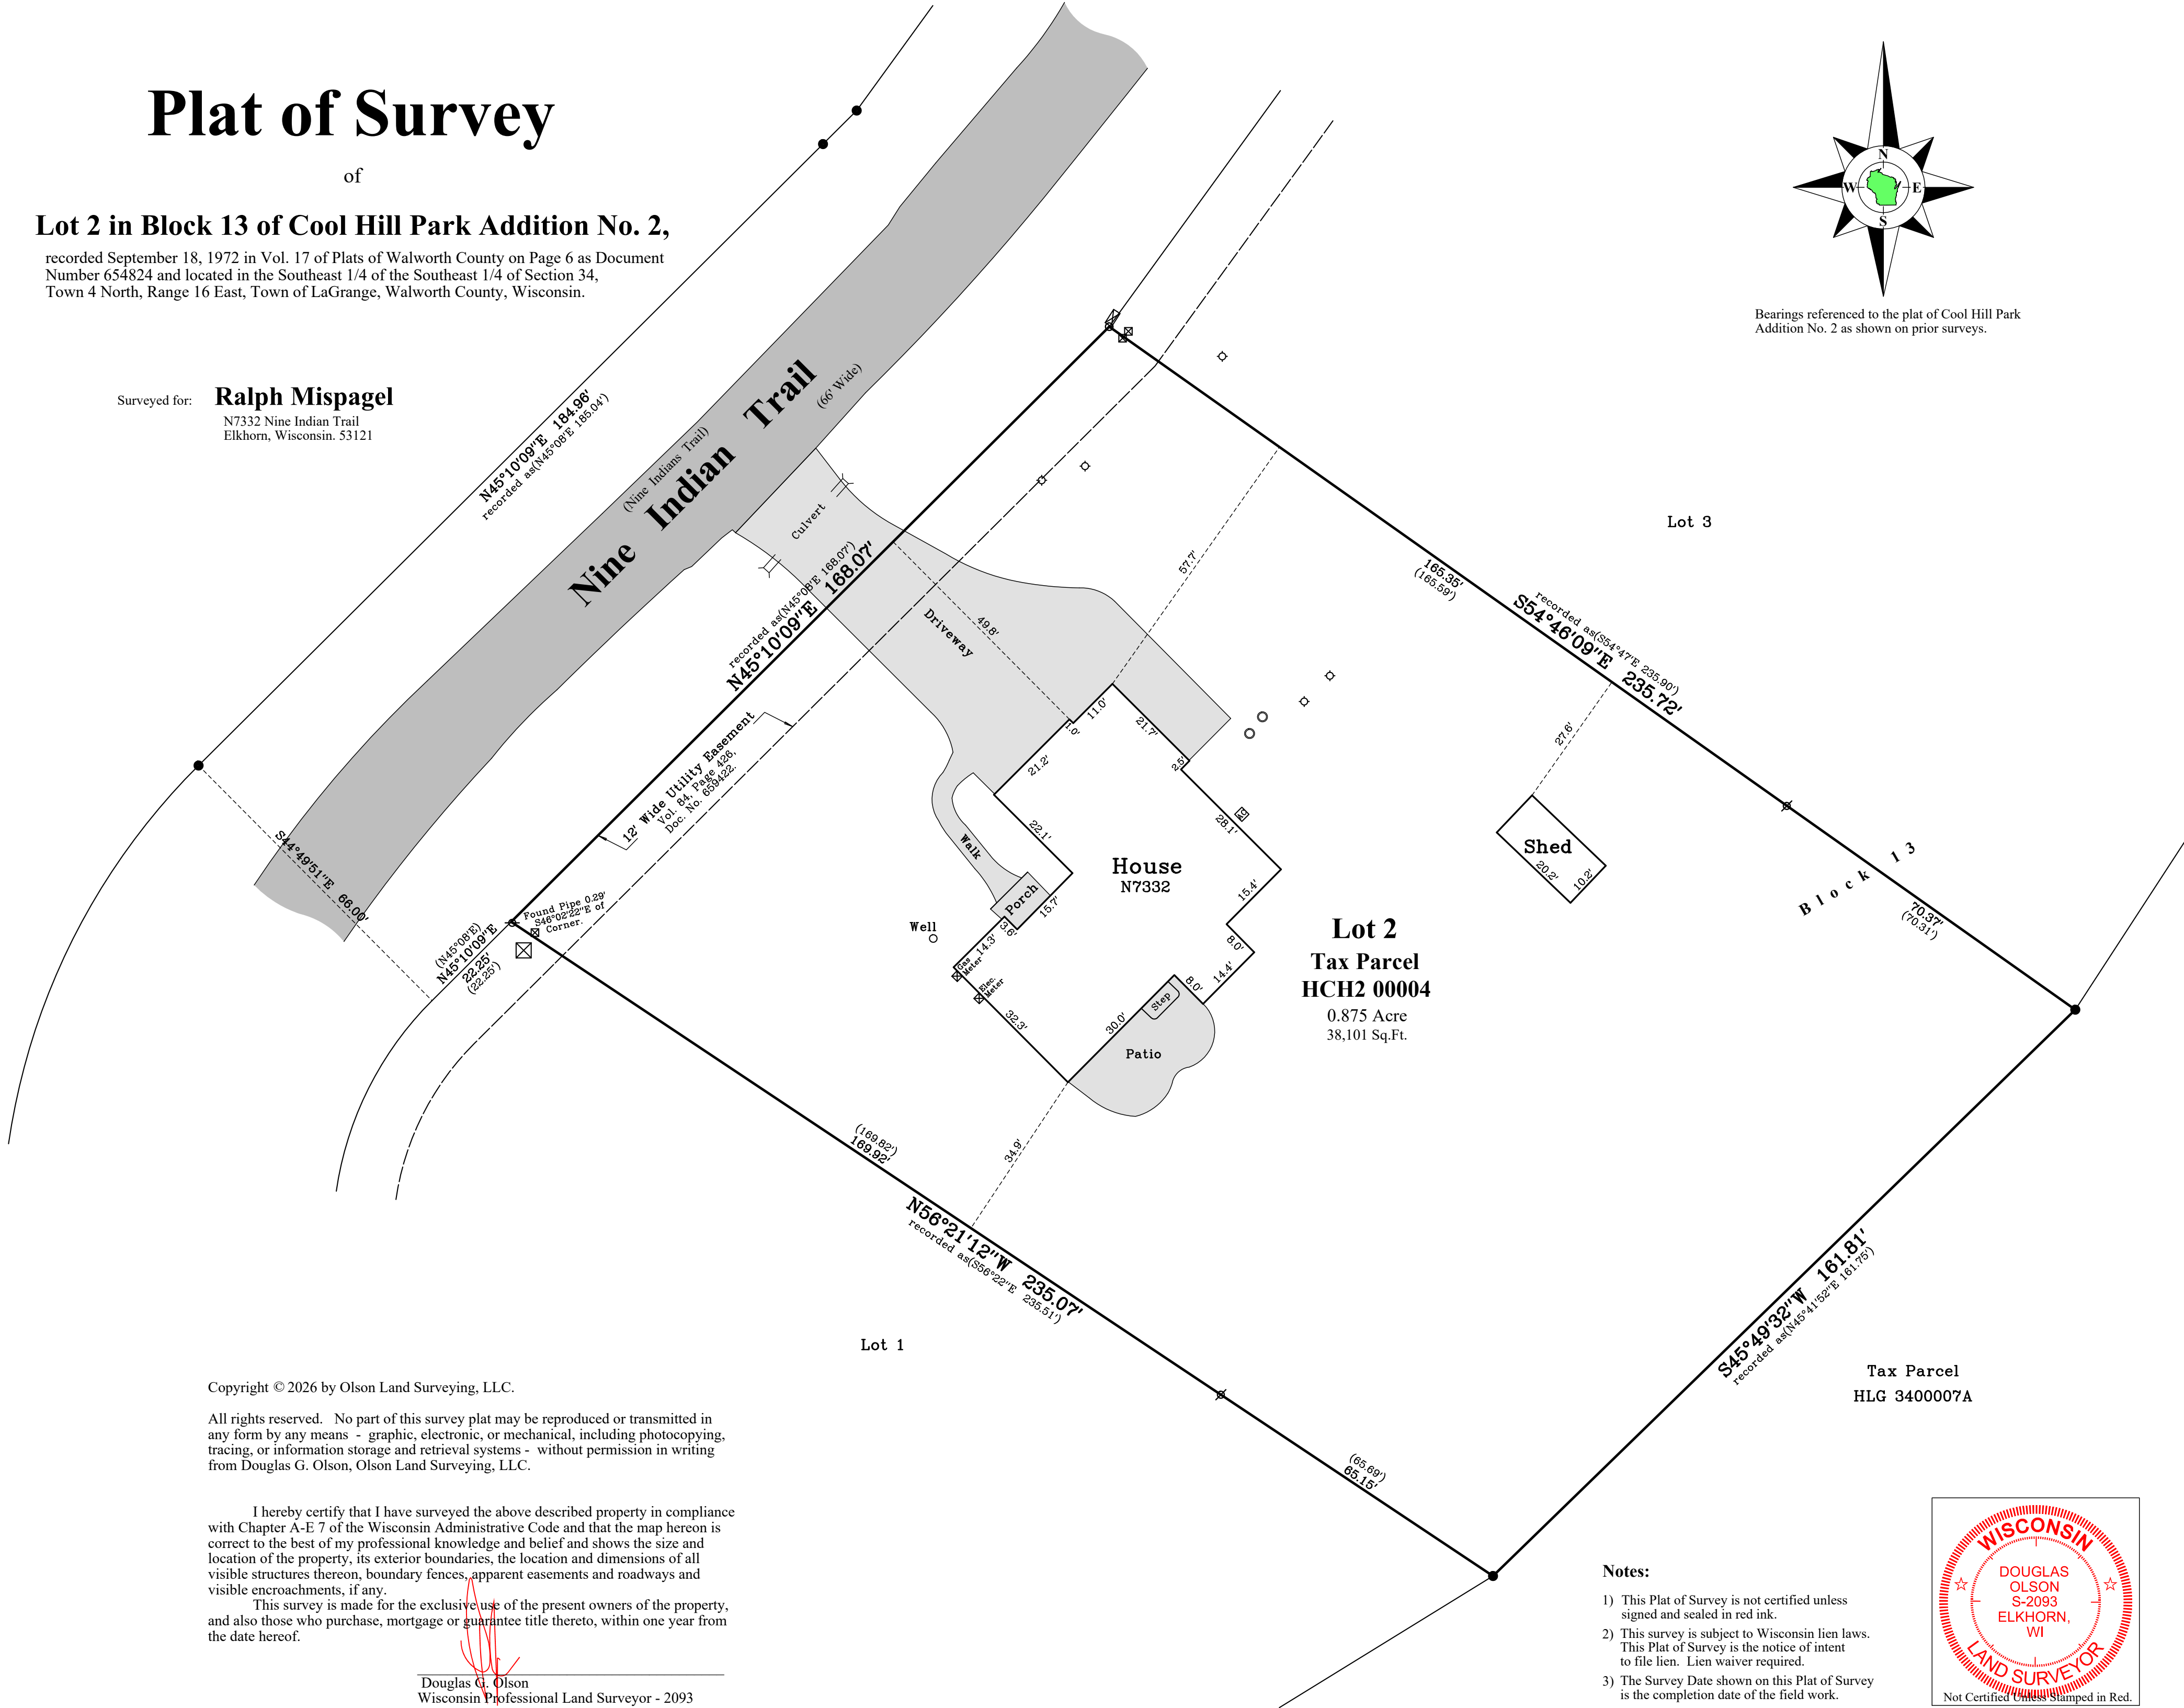

Copyright © 2026 by Olson Land Surveying, LLC.

All rights reserved. No part of this survey plat may be reproduced or transmitted in any form by any means - graphic, electronic, or mechanical, including photocopying, tracing, or information storage and retrieval systems - without permission in writing from Douglas G. Olson, Olson Land Surveying, LLC.


I hereby certify that I have surveyed the above described property in compliance with Chapter A-E 7 of the Wisconsin Administrative Code and that the map hereon is correct to the best of my professional knowledge and belief and shows the size and location of the property, its exterior boundaries, the location and dimensions of all visible structures thereon, boundary fences, apparent easements and roadways and visible encroachments, if any.

This survey is made for the exclusive use of the present owners of the property, and also those who purchase, mortgage or guarantee title thereto, within one year from the date hereof.


Douglas G. Olson
Wisconsin Professional Land Surveyor - 2093

Notes:

- 1) This Plat of Survey is not certified unless signed and sealed in red ink.
- 2) This survey is subject to Wisconsin lien laws. This Plat of Survey is the notice of intent to file lien. Lien waiver required.
- 3) The Survey Date shown on this Plat of Survey is the completion date of the field work.

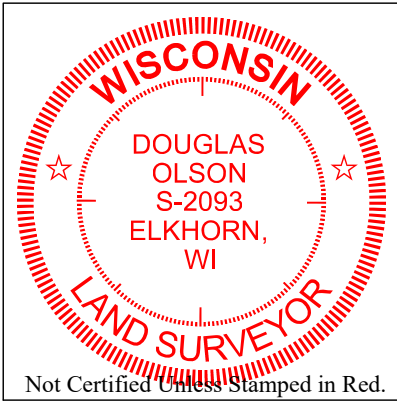

Survey Date: June 15, 2026.
Revisions:

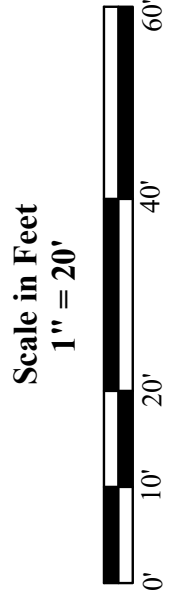

45 South Wisconsin Street | P.O. Box 322
Elkhorn, Wisconsin. 53121
Telephone: (262) 723-3434
Facsimile: (262) 723-8044
Email: doug@olsonsurveying.com
Website: www.olsonsurveying.com



Legend of Symbols & Abbreviations	
N	North
E	East
S	South
W	West
°	Degrees
'	Minutes
"	Seconds
ft	Feet
in	Inches
Found Iron Pipe	Found Iron Pipe
Set Iron Pipe, 1" dia.	Set Iron Pipe, 1" dia.
Recorded Information	Recorded Information
Utility Pedestal	Utility Pedestal
Concrete Cover	Concrete Cover
Septic Vent	Septic Vent
Concrete Surface	Concrete Surface

Sheet 1 of 1 Sheets
Drawing Name:
Job Reference Number
2026.031

2026.031