
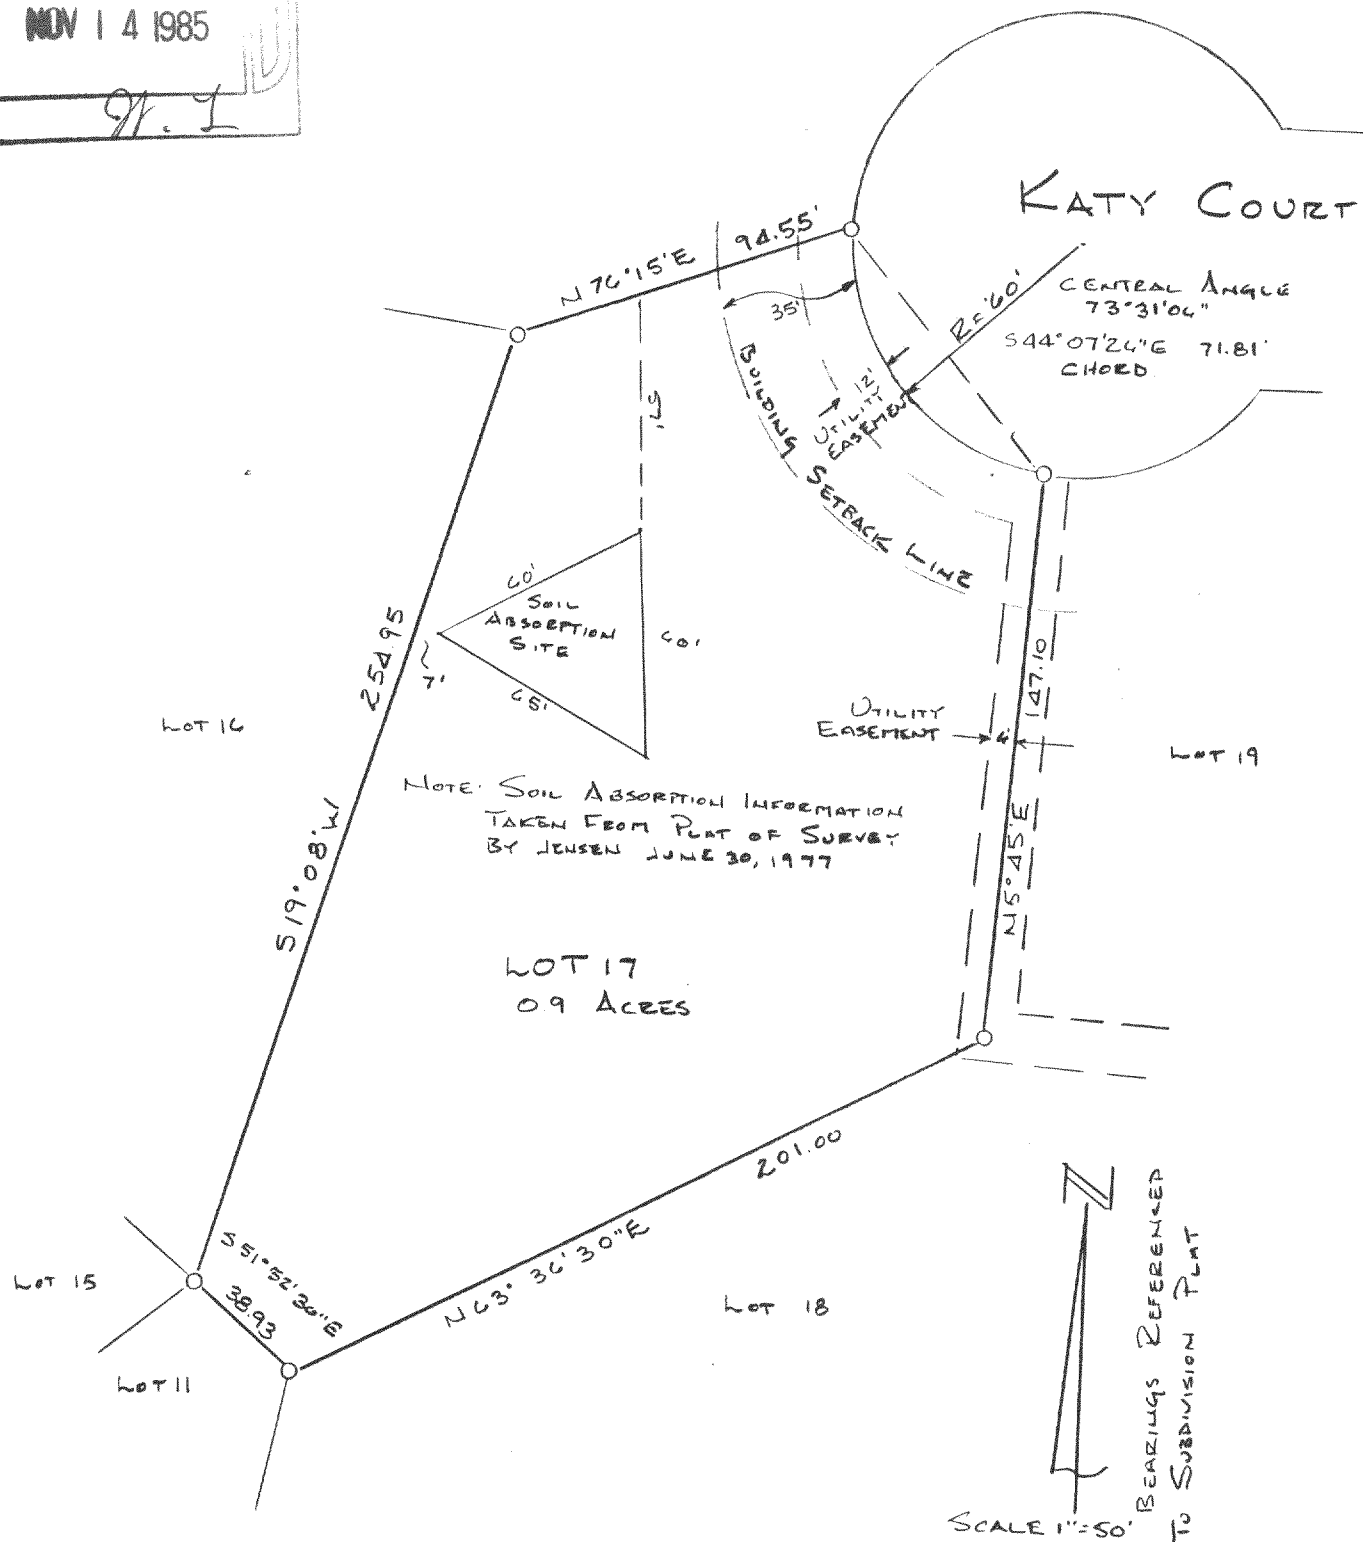


PLAT OF SURVEY OF LOT 17 OF SOUTHMOOR SUBDIVISION LOCATED IN THE S.E. $\frac{1}{4}$ OF THE S.W. $\frac{1}{4}$ AND THE S.W. $\frac{1}{4}$ OF THE S.W. $\frac{1}{4}$ OF SECTION 25, T4N, R16E, TCWN OF LA GRANGE, WALWORTH COUNTY, WISCONSIN

JENSEN SURVEYING & MAPPING S.C.
P.O. Box 322- Elkhorn, WI. - 53121

SURVEYED FOR: KENOSHA SAVINGS & LOAN
Broad St.
Lake Geneva, WI.
53147


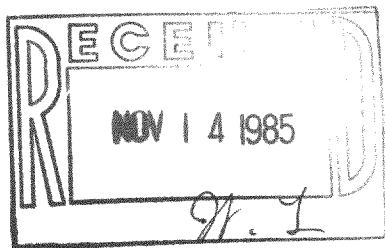


0 3/4" IRON BAR FOUND

I, Robert L. Meadows Jr., Wisconsin Registered Land Surveyor, do hereby certify that this survey was performed by me in full compliance with the owner's/agent's instructions and Chapter AE-5 of the Wisconsin Administrative Code "Minimum Standards for Property Surveys"; and that this map is an accurate representation thereof to the best of my knowledge and belief.

Robert L. Meadows Jr.
Robert L. Meadows Jr. S-1801
Mapping Date 10/30/85

1985.099

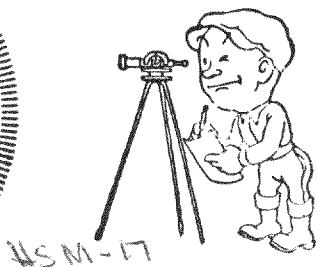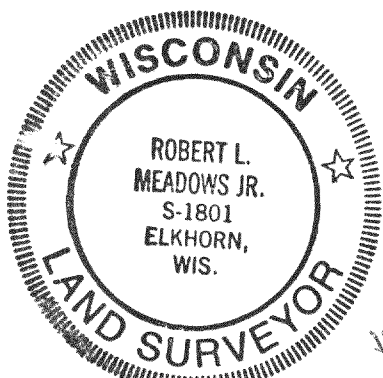

416-365 ✓