

RECEIVED  
AUG 19 1986  
G.T.

DUNHAM SURVEYING, S.C.  
SURVEYING & SUBDIVIDING  
DELAVAN, WISCONSIN 53115



Northeast corner of Lot 16,  
Block 2, Green Lake Park

Scale - 1" = 20'

○ = 1 1/2" Iron Pipe Found

● = 1" Iron Pipe Found


⊙ = 1/2" Iron Pipe Found

(0.00) = recorded distance and bearing

— = fence line

Bearings referenced to the recorded bearing of  
N73°13'E along the northerly line of property  
surveyed

Survey ordered by: Colony Realty  
16 E. Walworth  
Elkhorn, WI 53121

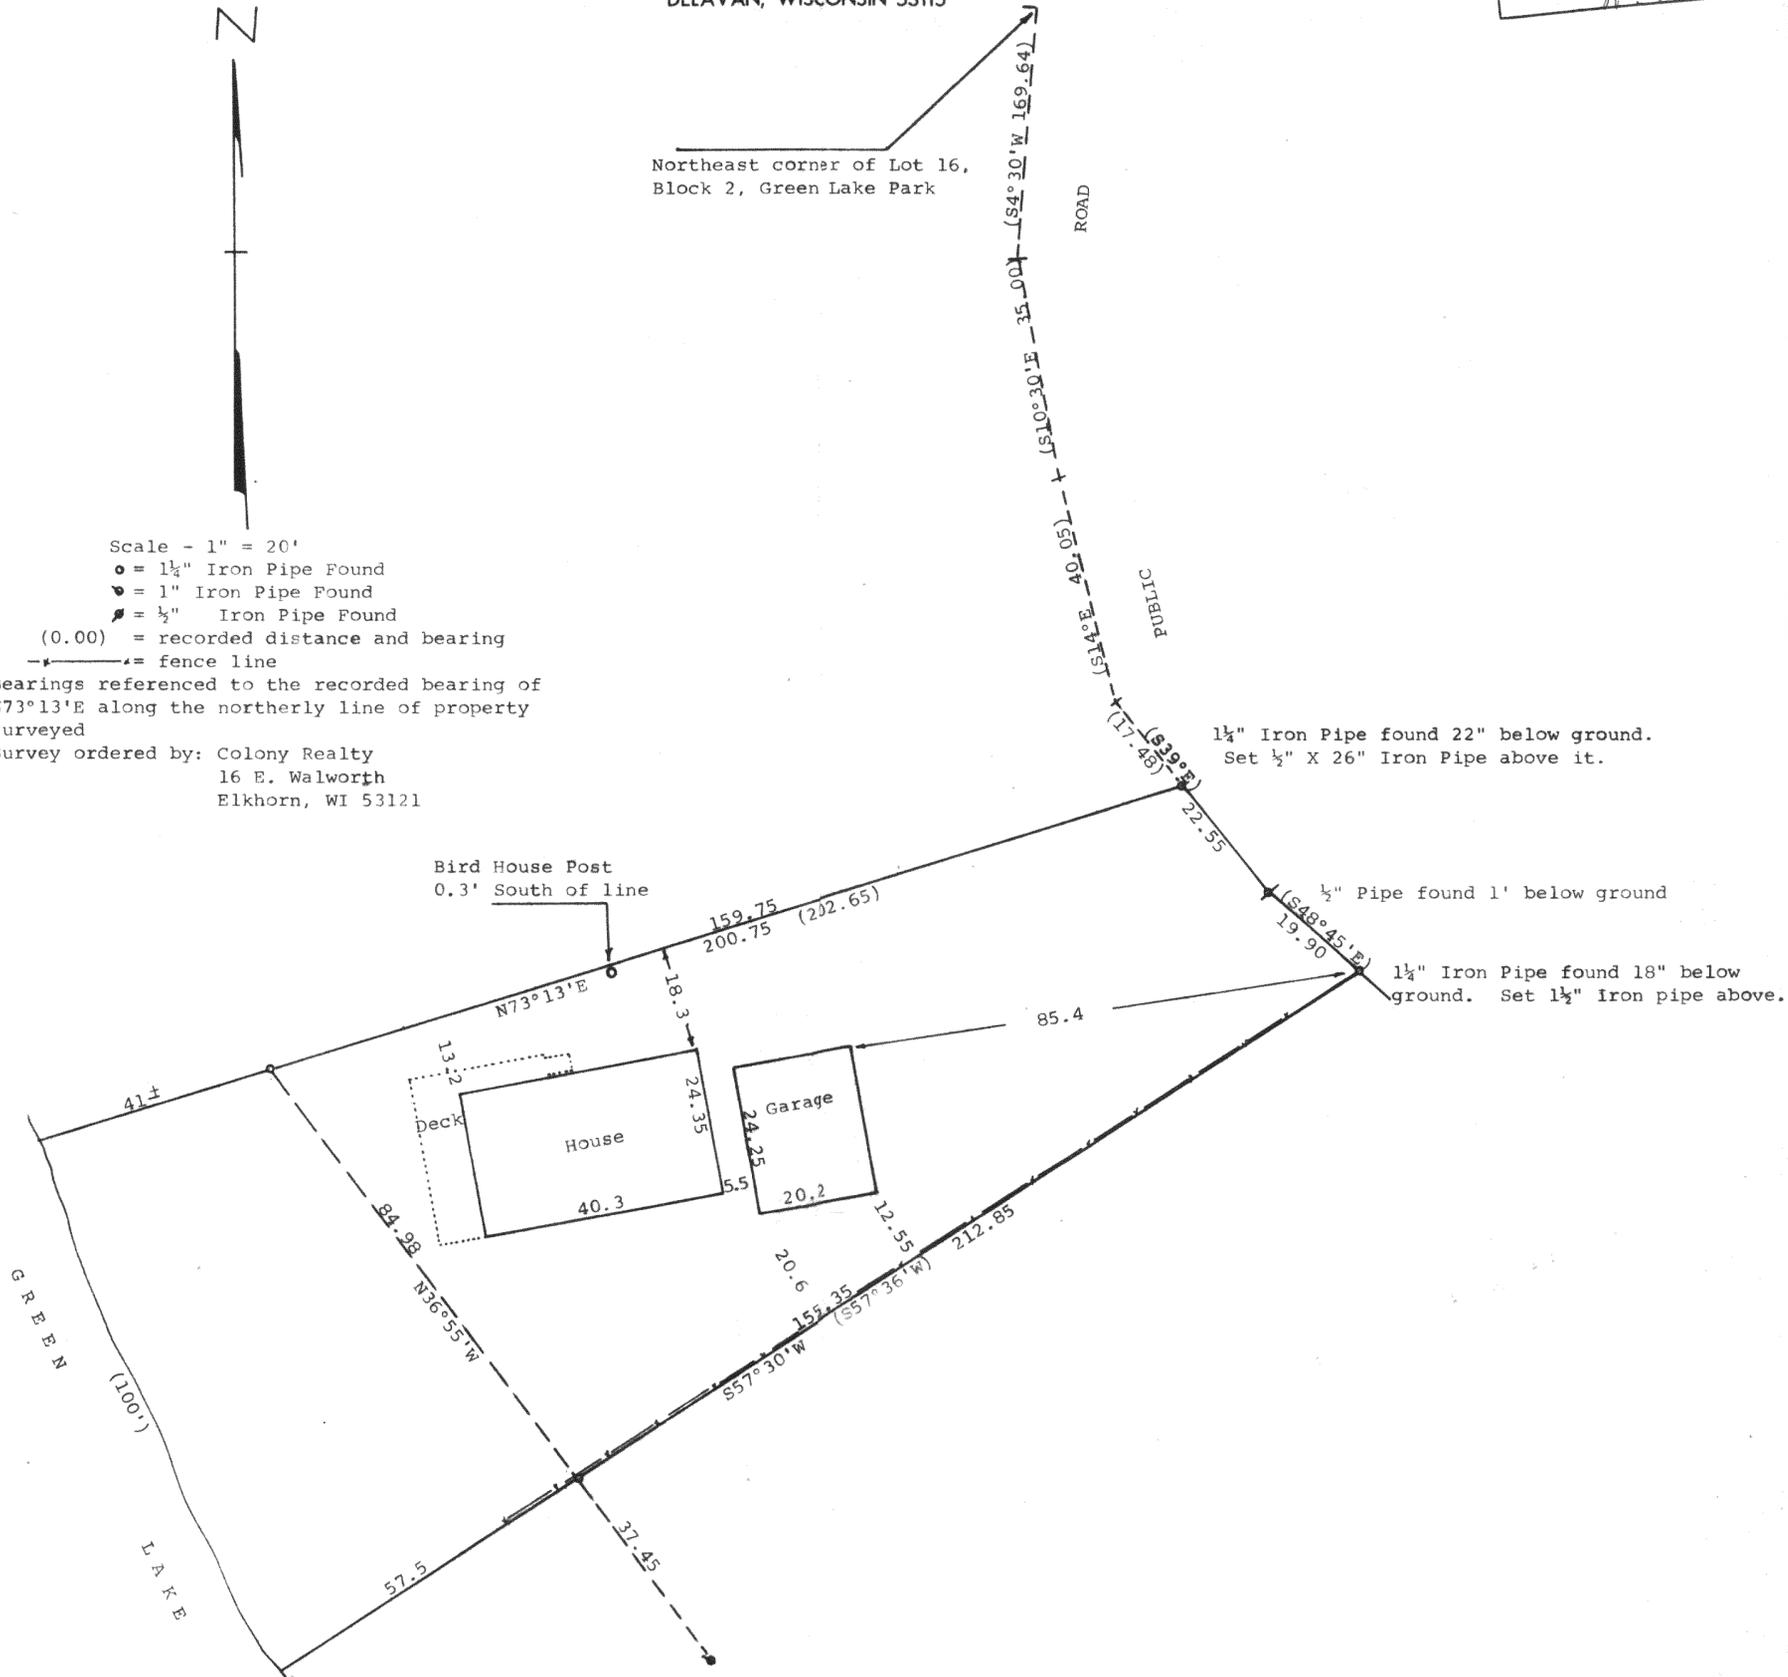

STATE OF WISCONSIN) SS  
COUNTY OF WALWORTH)

I, George T. Dunham, Surveyor, certify that I have surveyed the property described as follows:

A parcel of land being part of Lots 21 and 22, Block 2 and part of Block 3, Green Lake Park, a subdivision located in the Southwest 1/4 of Section 26, T 4 N, R 16 E, Walworth County, Wisconsin, described as follows: Commencing at the Northeast corner of Lot 16, Block 2; thence along the highway as follows: S4°30'W 169.64 feet; thence S10°30'E 35.00 feet; thence S14°E 40.05 feet; thence S39°E 17.48 feet to the place of beginning; thence continue S39°E 22.55 feet; thence S48°45'E 19.90 feet; thence S57°30'W (described as S57°36'W) 212.85 feet more or less to the shore of Green Lake; thence northwesterly 100.0 feet along said shore more or less to a point located S73°13'W 200.75 feet (described as 202.65 feet) from the place of beginning; thence N73°13'E 200.75 feet more or less to the place of beginning.

and that the plat shown above is a true representation thereof and shows the size and location of the property, its exterior boundaries, the location of all visible structures and dimensions of all principal buildings thereon, boundary fences, apparent easements, roadways and visible encroachments, if any, and that I have surveyed the property hereon described according to the official records to the best of my knowledge and belief.  
November 9, 1984

*George T. Dunham*  
George T. Dunham



HGP-181

416-378