

[illegible]


PLAT OF SURVEY OF LAND LOCATED IN GOVERNMENT LOT 4,
SAID LOT IS THE NORTH $\frac{1}{2}$ OF THE SOUTHWEST FRACTIONAL $\frac{1}{4}$
OF SECTION 25, T4N R16E OF WALWORTH COUNTY WISCONSIN.

NORTH COUNTY WISCONSIN.
Lloyd L. Jensen
WALWORTH COUNTY SURVEYOR.

RECEIVED
JAN 7 1992

416-38.1


POINT LOCATED $S 87^{\circ} 47' E$ 61.70 FEET, $S 80^{\circ} 55' E$ 64.75 FEET, $S 72^{\circ} 44' E$ 87.47 FEET FROM THE NORTHEAST CORNER OF LOT 15 OF THE FIRST ADDITION TO LAUDERDALE PARK

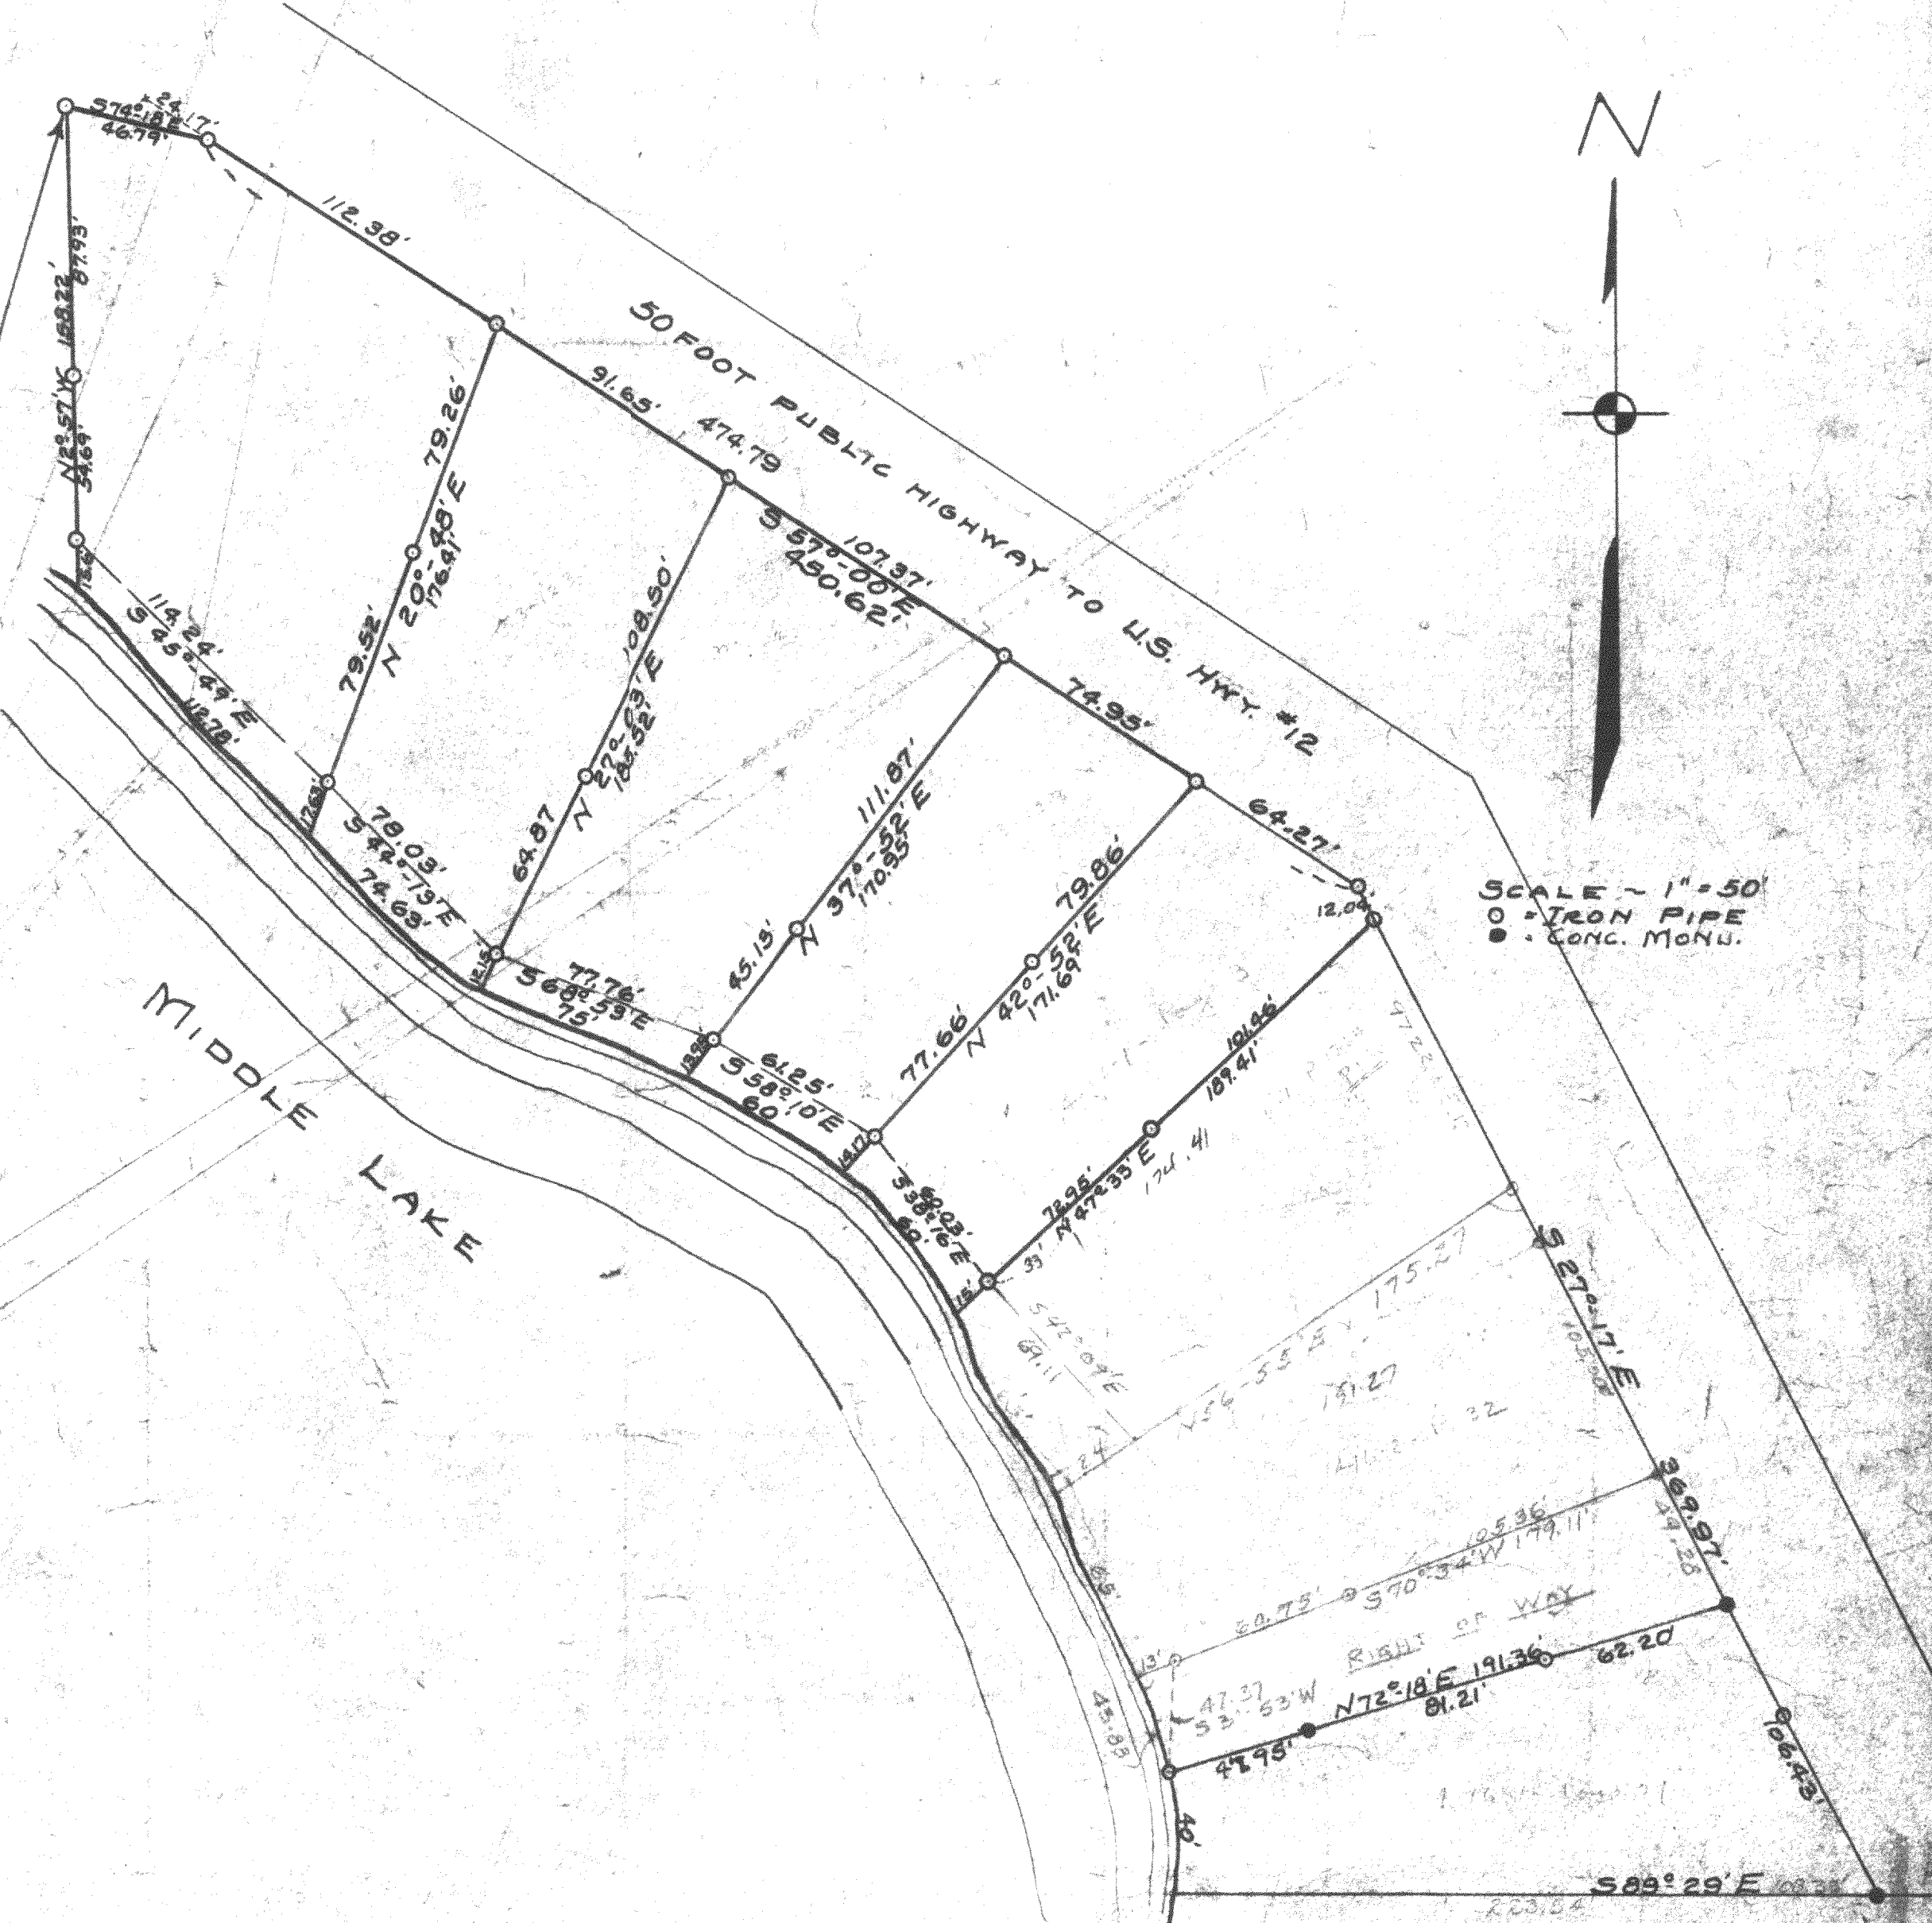

PLAT OF SURVEY OF LAND LOCATED IN GOVERNMENT LOT 4, SAID LOT IS THE NORTH $\frac{1}{2}$ OF THE SOUTHWEST FRACTIONAL $\frac{1}{4}$ OF SECTION 25, T4N R16E OF WALWORTH COUNTY WISCONSIN.

OCT. 1947
REVISED JULY 1963

Floyd A. Jensen
WALWORTH COUNTY SURVEYOR

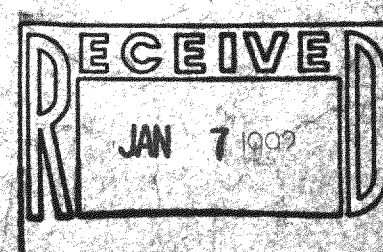

HLG-25-37A
HLG-25-38
HLG-25-41
HLG-25-42
HLG-25-38D
HLG-25-37B
HLG-25-38B
HLG-25-37C
HLG-25-37D
HLG-25-37F1
HTM* MISC

HLG-38.1

HLG-25-38B

POINT LOCATED $S 87^{\circ} 47' E$ 61.70 FEET, $S 80^{\circ} 55' E$ 64.75 FEET, $S 72^{\circ} 44' E$ 87.47 FEET FROM THE NORTHEAST CORNER OF LOT 15 OF THE FIRST ADDITION TO LAUDERDALE PARK



SCALE - 1" = 50'
 O = IRON PIPE
 • = CONC. MONU.

MIDDLE LAKE

50 FOOT PUBLIC HIGHWAY TO U.S. HWY #12

PLAT OF SURVEY OF LAND LOCATED IN GOVERNMENT LOT 4, SAID LOT IS THE NORTH $\frac{1}{2}$ OF THE SOUTHWEST FRACTIONAL $\frac{1}{4}$ OF SECTION 25, T4N R16E OF WALWORTH COUNTY WISCONSIN.

OCT. 1947

WALWORTH COUNTY SURVEYOR

HLG 35 41, 42 38D, 37B, 38B
 + PK LOT 4 WEST MOON

LG-37D
 LG-37A1

416-38.1