
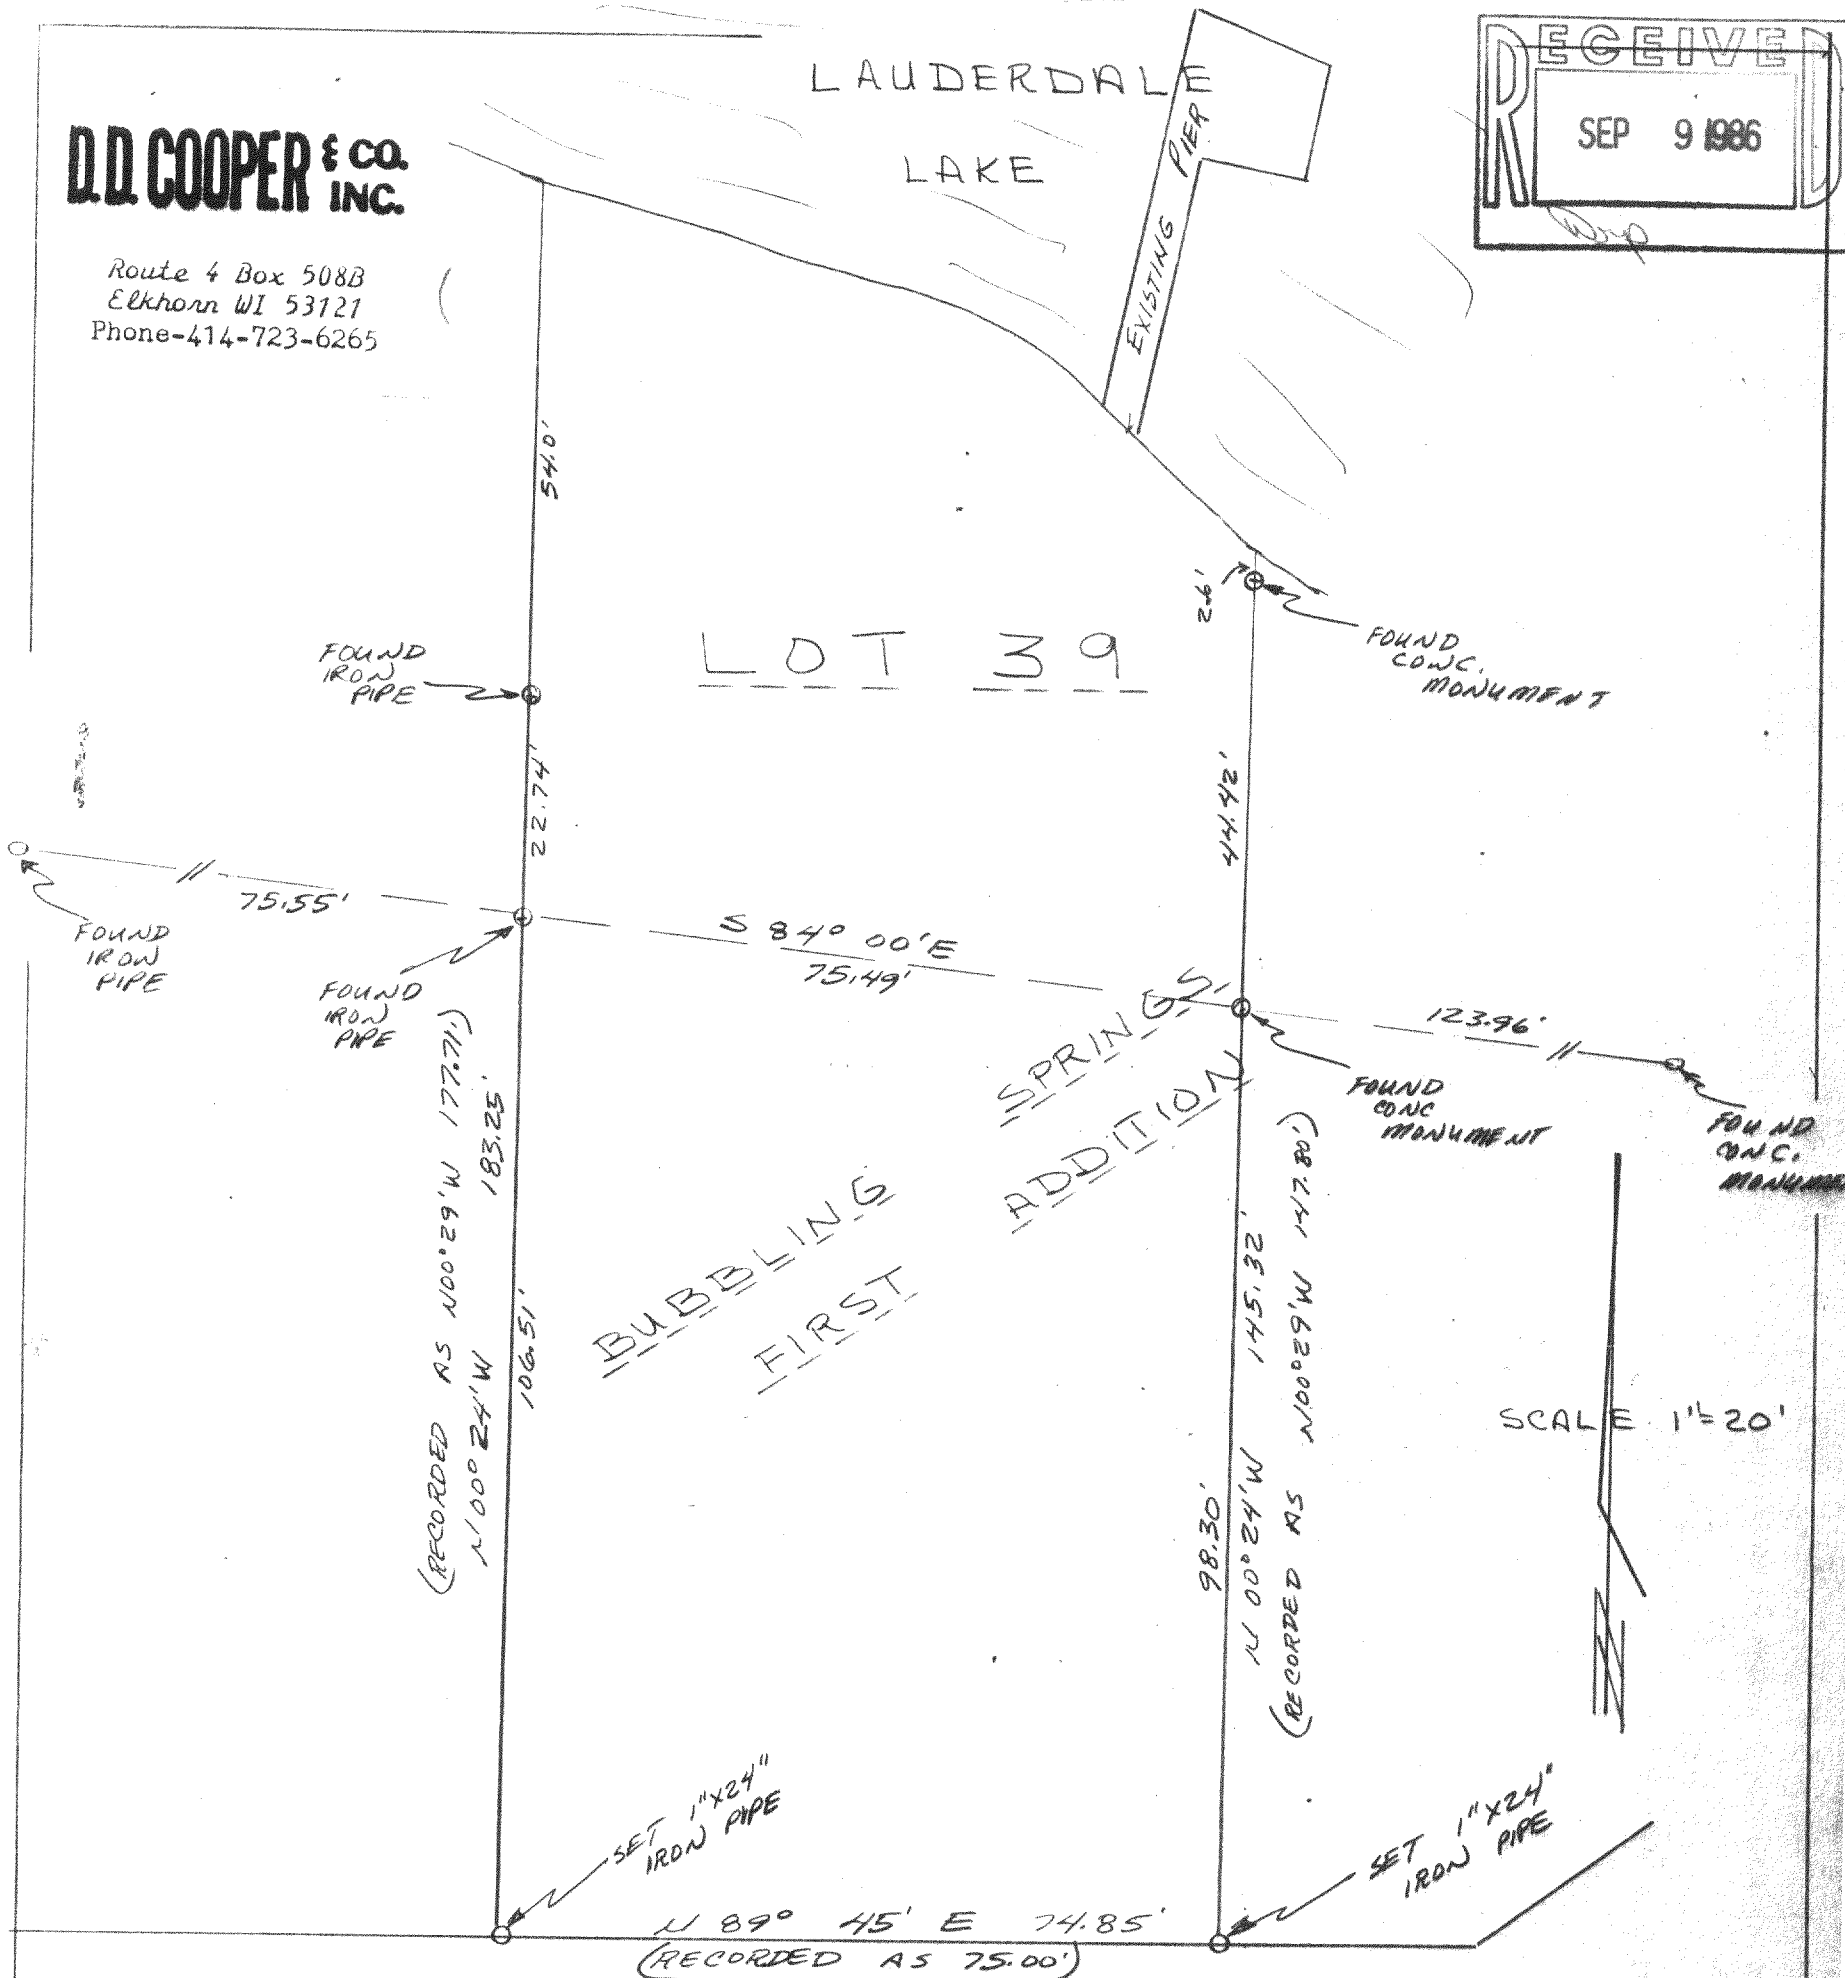


D.D. COOPER & CO. INC.

Route 4 Box 508B
Elkhorn WI 53121
Phone-414-723-6265

LAUDERDALE
LAKE

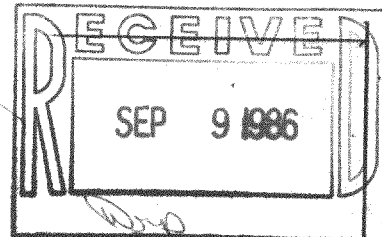

Plat of survey of lot 39 Bubbling Springs First Addition
being in the Town of Lagrange Walworth County Wisconsin


Survey ordered by Modern Realty - Elkhorn

Bearing reference: Westerly line
of parcel assumed to bear N00°24'W

I, Daniel D. Cooper, Registered Land Surveyor do hereby certify that
I have surveyed the property described hereon and that the map shown
hereon is a true and accurate representation thereof to the best of my
professional knowledge and belief.

Dated this 10TH day of July, 1986

Daniel D. Cooper
Daniel D. Cooper, RLS NO. S-1464

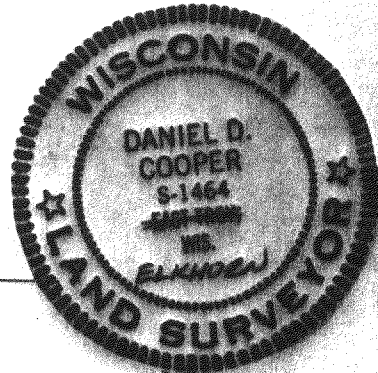

DRAWING NO. 2255-5-3

HBSI-8

TAX NO. HBSI - 00008