

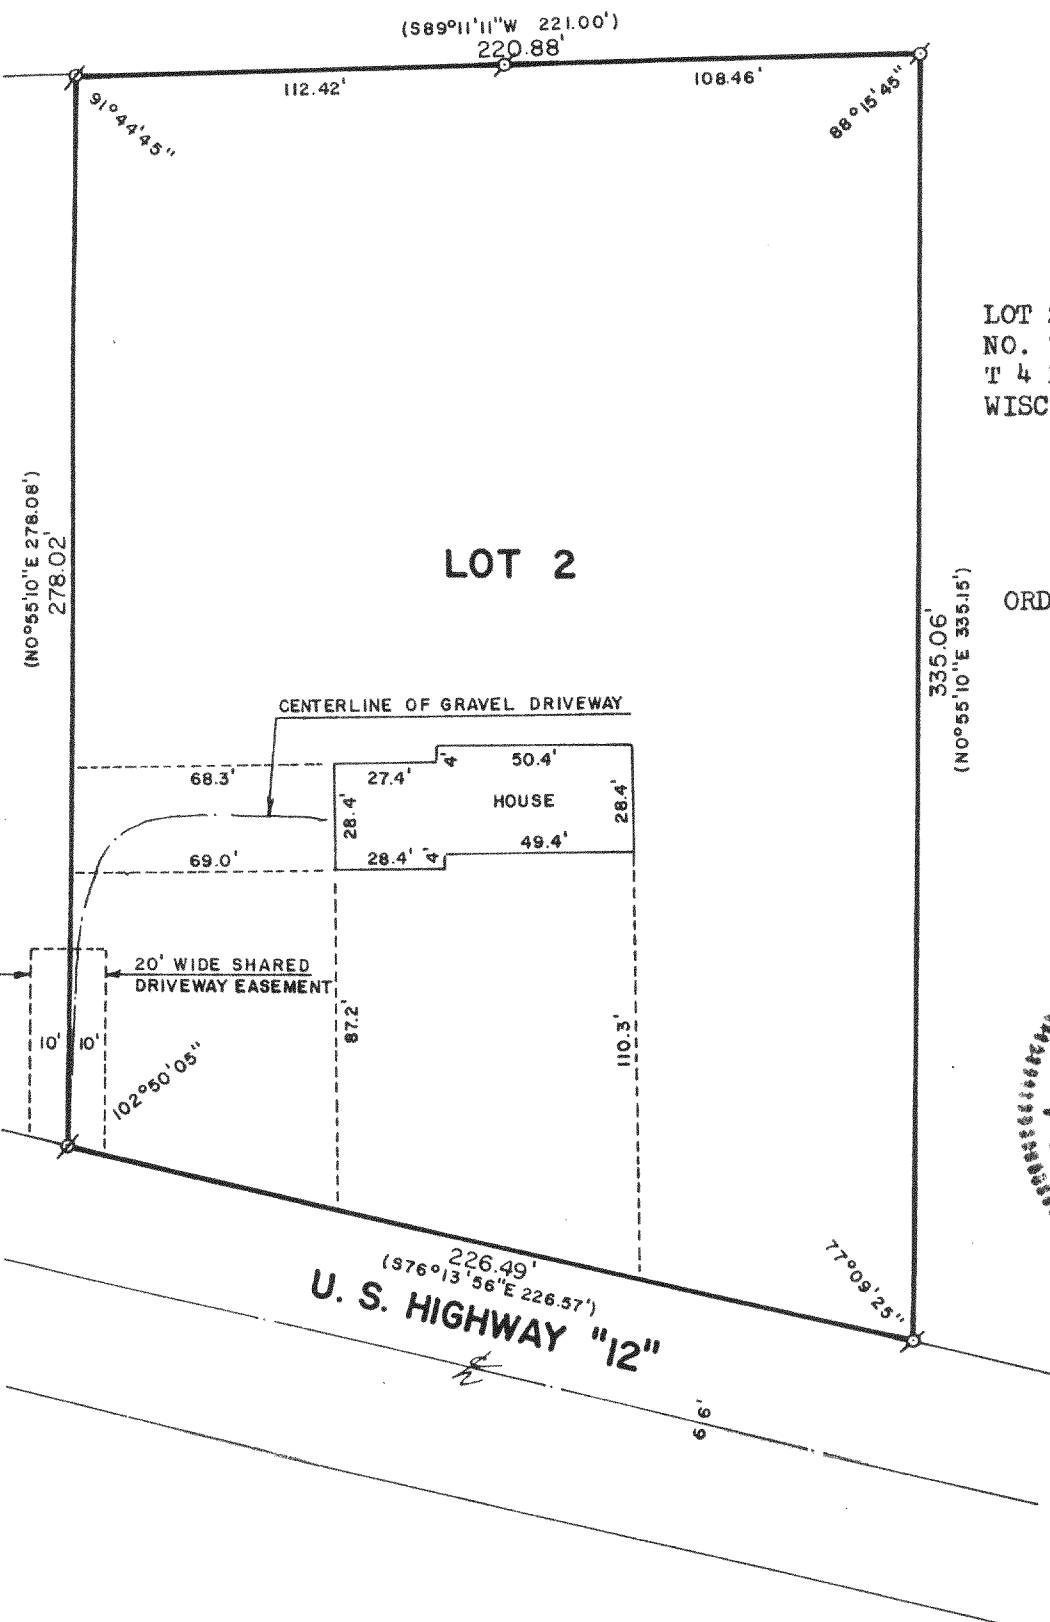
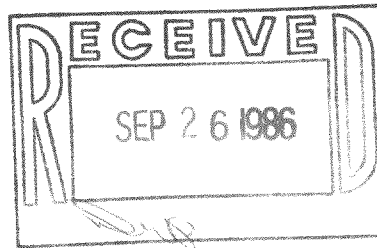


WALWORTH COUNTY
SURVEYING & MAPPING
LAKE GENEVA, WISCONSIN

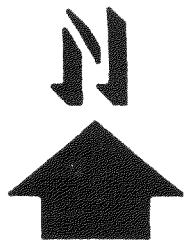

PLAT OF SURVEY OF
LOT 2 OF CERTIFIED SURVEY MAP
NO. 736, LOCATED IN SECTION 18,
T 4 N, R 16 E, WALWORTH COUNTY,
WISCONSIN.

ORDERED BY: ANDREW F. ALLEN
101 BROAD STREET
LAKE GENEVA, WI
53147

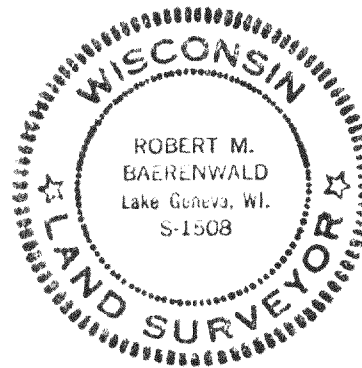

SCALE: 1"=50'

⊘ - IRON PIPE FOUND
○ - IRON ROD FOUND
() - RECORDED AS

I, ROBERT M. BAERENWALD, DO HEREBY CERTIFY THAT I
HAVE SURVEYED THE PROPERTY HEREON DESCRIBED ACCORDING
TO THE OFFICIAL RECORDS AND THAT THE PLAT HEREON IS A
CORRECT REPRESENTATION OF THE PROPERTY LINES TO THE
BEST OF MY KNOWLEDGE AND BELIEF.

Robert M. Baerenwald
ROBERT M. BAERENWALD
WISCONSIN REGISTERED LAND SURVEYOR, S-1508

DATE Aug. 5, 1986 JOB NO. 0674