

PLAT OF SURVEY



of
All of Lot 9 and Lot 10 except the Southwesterly 24 feet
of said Lot 10, in Block 2 of Green Lake Park Subdivision,
located in Section 26, Town 4 North, Range 16 East, Walworth
County, Wisconsin.

Also

a parcel of land more particularly described as follows:
Commence at the Northwest Corner of Block 4 of said Green Lake
Park Subdivision; thence S 31°46' W, along the East line of a
public road, 100.50 feet to the Point of Beginning; thence S
65°15' E 34.00 feet; thence N 31°46' E 46.65 feet; thence S
58°42'42" E 35.75 feet; thence S 31°46' W 55.00 feet; thence N
65°15' W 70.00 feet to the East line of said public road; thence
N 31°46' E, along said East line, 12.50 feet to the Point of
Beginning.

Parcel contains 0.056 acres of land, more or less and is listed
under Tax key # 80-00028 at the Walworth County Courthouse.

GREEN
LAKE

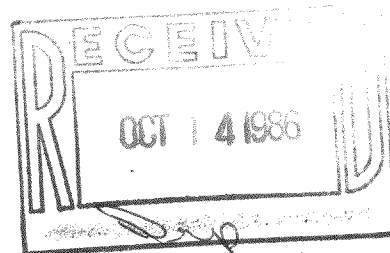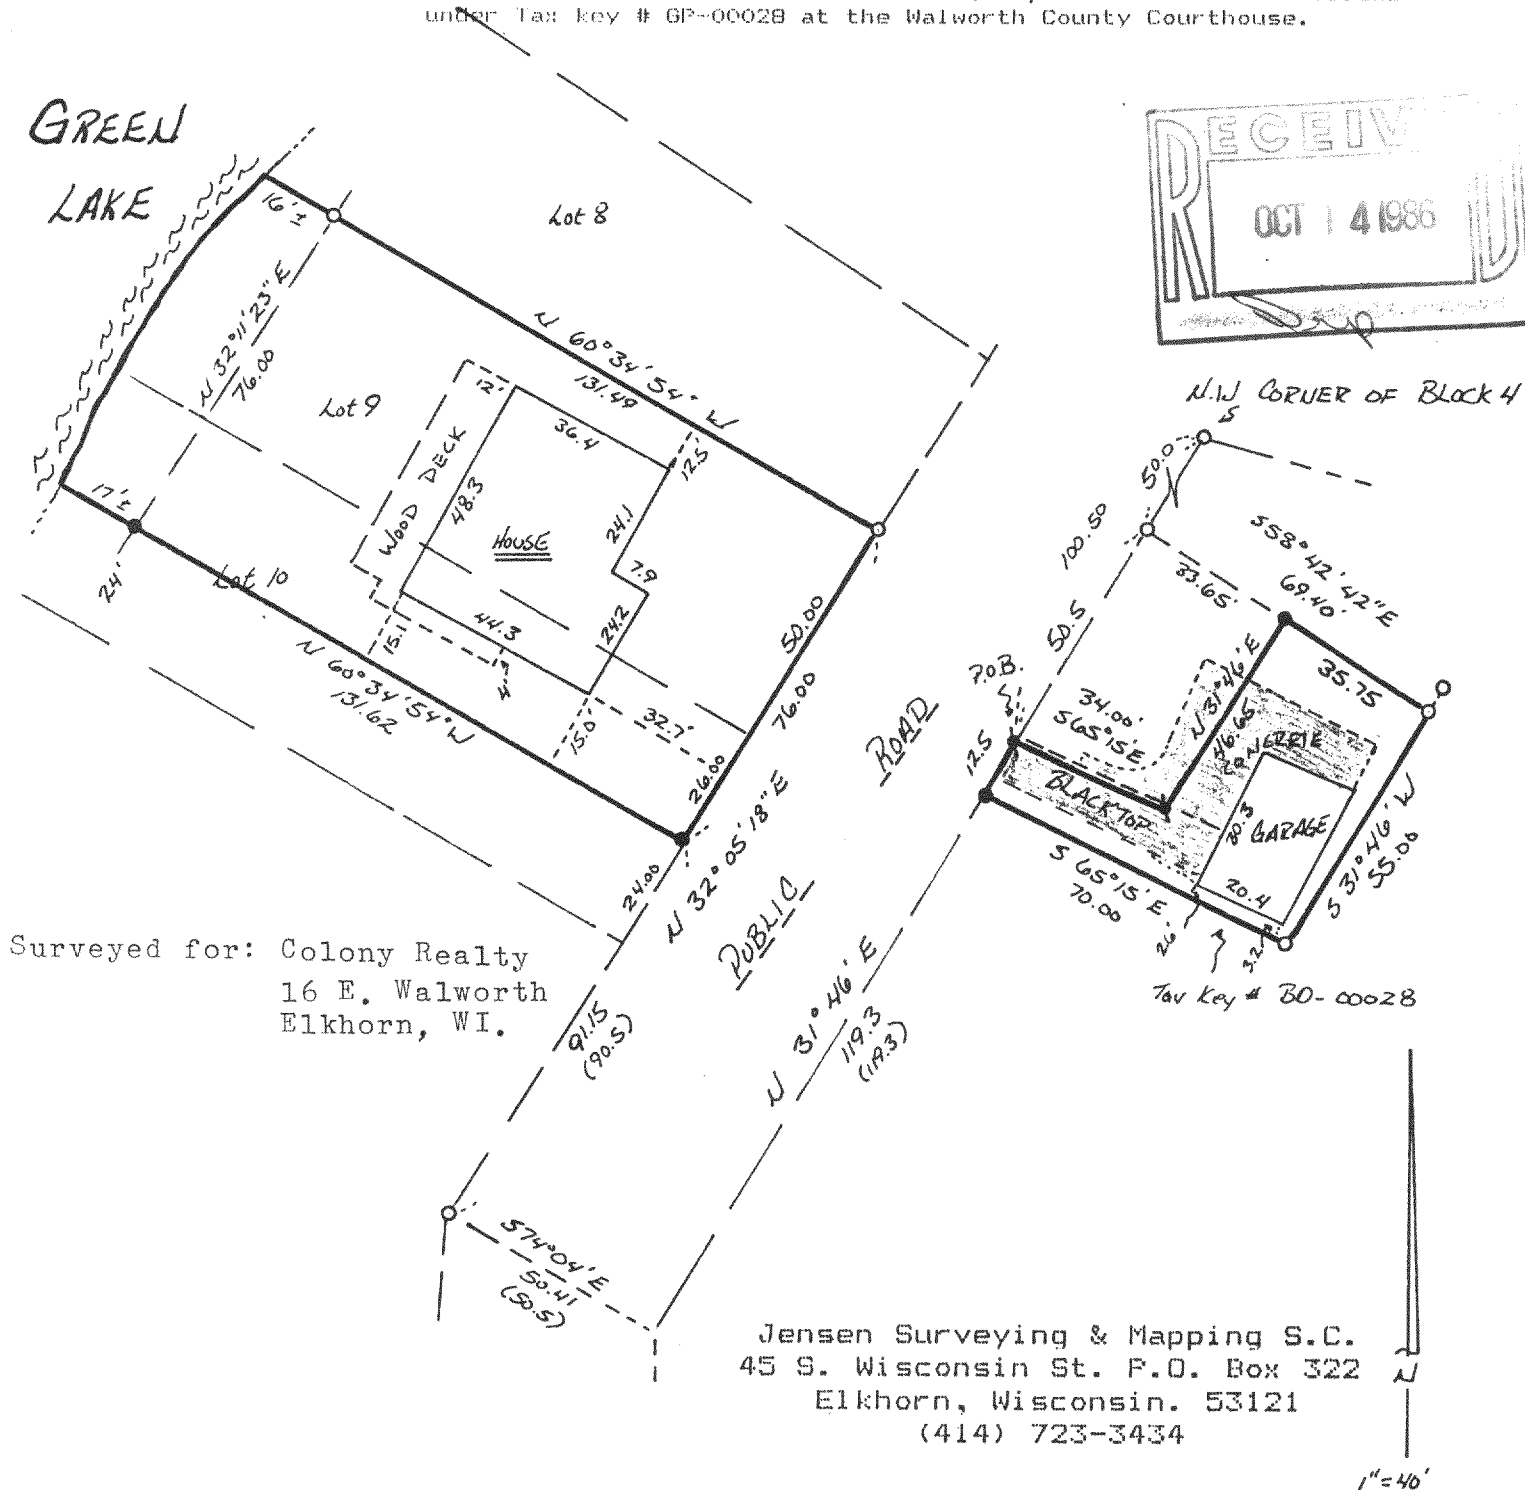

N.W. CORNER OF BLOCK 4

Tax Key # 80-00028

LEGEND

- ~ FOUND IRON PIPE
- ~ SET 3/4" IRON ROD
- ✱ ~ SET P.K. NAIL

Note: This survey plat is not certified
unless signed and sealed in red ink.

I, Thomas P.A. Jensen, Wisconsin Registered Land Surveyor, AUGUST 22, 1986
do hereby certify that this survey was performed by me, or under
my direction, in full compliance with the owner's/agent's
instructions and chapter A-E 5 of the Wisconsin Administrative
Code "Minimum Standards For Property Surveys"; and that this map
is an accurate representation thereof to the best of my knowledge
and belief.

Thomas P.A. Jensen S-1084
Jensen Surveying & Mapping S.C.

1986.085 X