
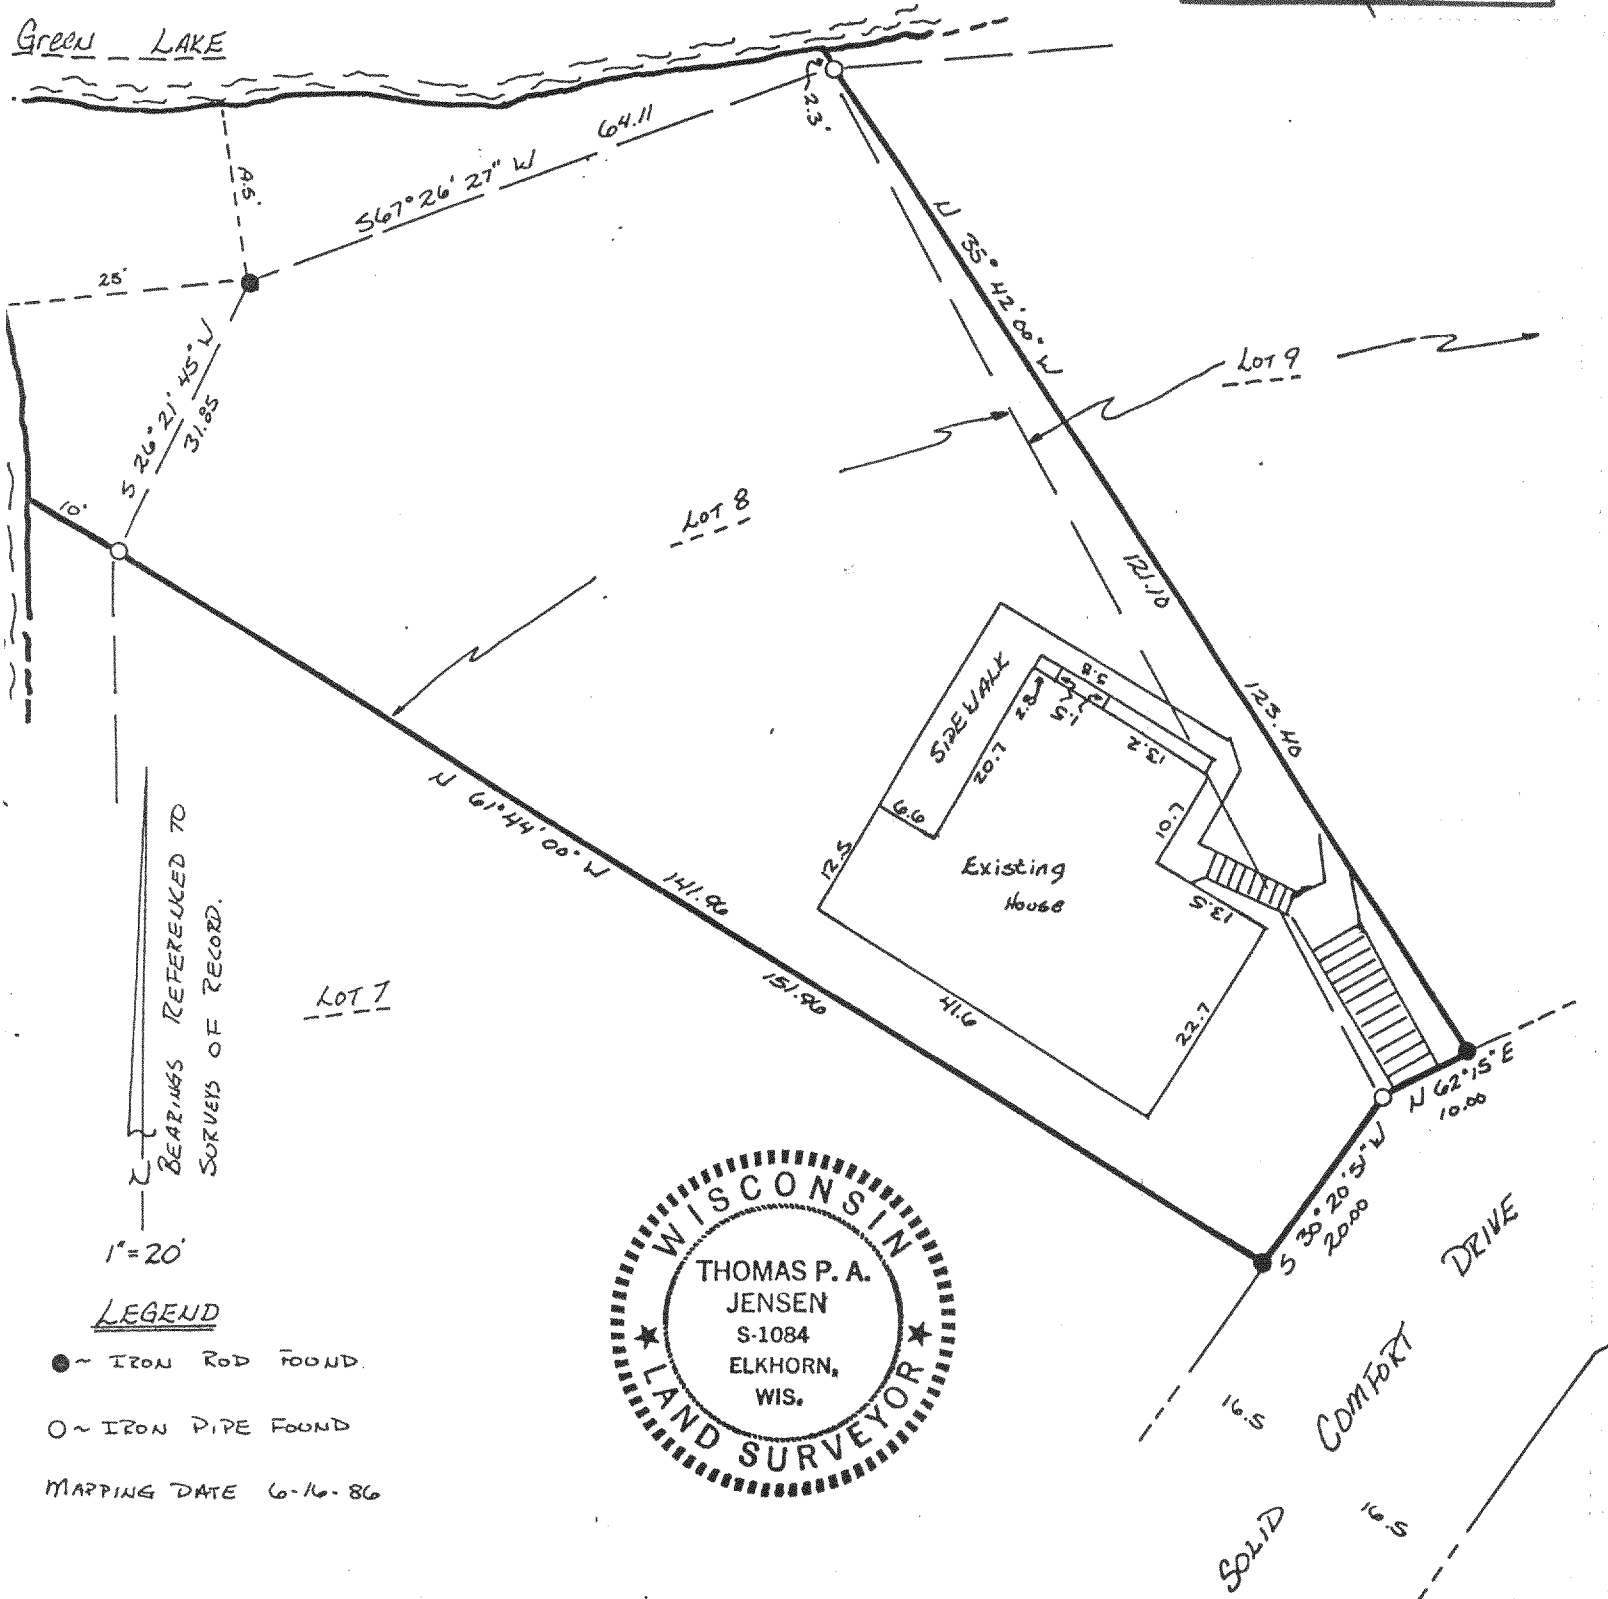


PLAT OF SURVEY

of
A parcel of land described in Volume 192, Page 721 at the
Walworth County Register of Deeds, being Lot 8 and part of
Lot 9 of LaSelva Subdivision, located in Section 26, T 4 N,
R 16 E, Town of LaGrange, Walworth County, Wisconsin.

Sureveyed by: Jensen Surveying & Mapping S.C.
45 S. Wis. P.O. Box 322
Elkhorn, WI. 53121

Surveyed for: T.L.C. Realty Inc.
12½ S. Wisconsin
Elkhorn, WI. 53121

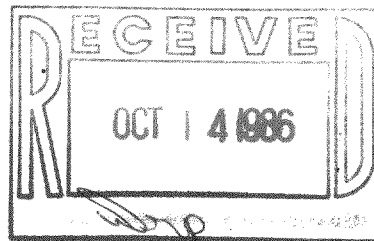

I, Thomas P.A. Jensen, Wisconsin Registered Land Surveyor,
do hereby certify that this survey was performed by me, or under
my direction, in full compliance with the owner's/agent's
instructions and chapter A-E 3 of the Wisconsin Administrative
Code "Minimum Standards For Property Surveys"; and that this map
is an accurate representation thereof to the best of my knowledge
and belief.

Thomas P.A. Jensen
S-1084
Thomas P.A. Jensen
Jensen Surveying & Mapping S.C.
45 S. Wisconsin St.
Elkhorn, Wisconsin. 53121
(414) 723-3434

1986.050 X

416-404