



GEORGE T. DUNHAM
SURVEYING & SUBDIVIDING
DELAVER, WISCONSIN

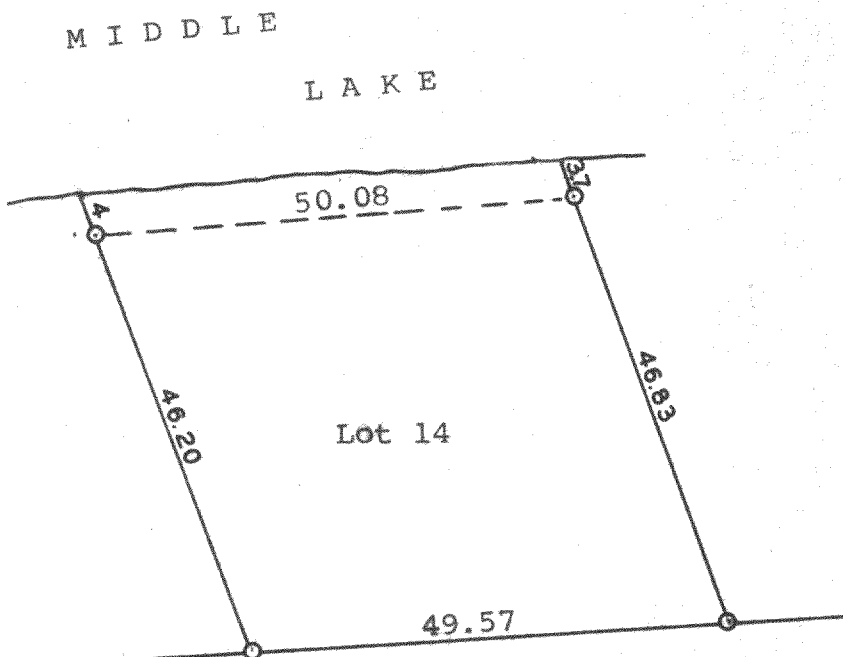

ROADWAY

Scale - 1" = 20'
O = Iron Pipe

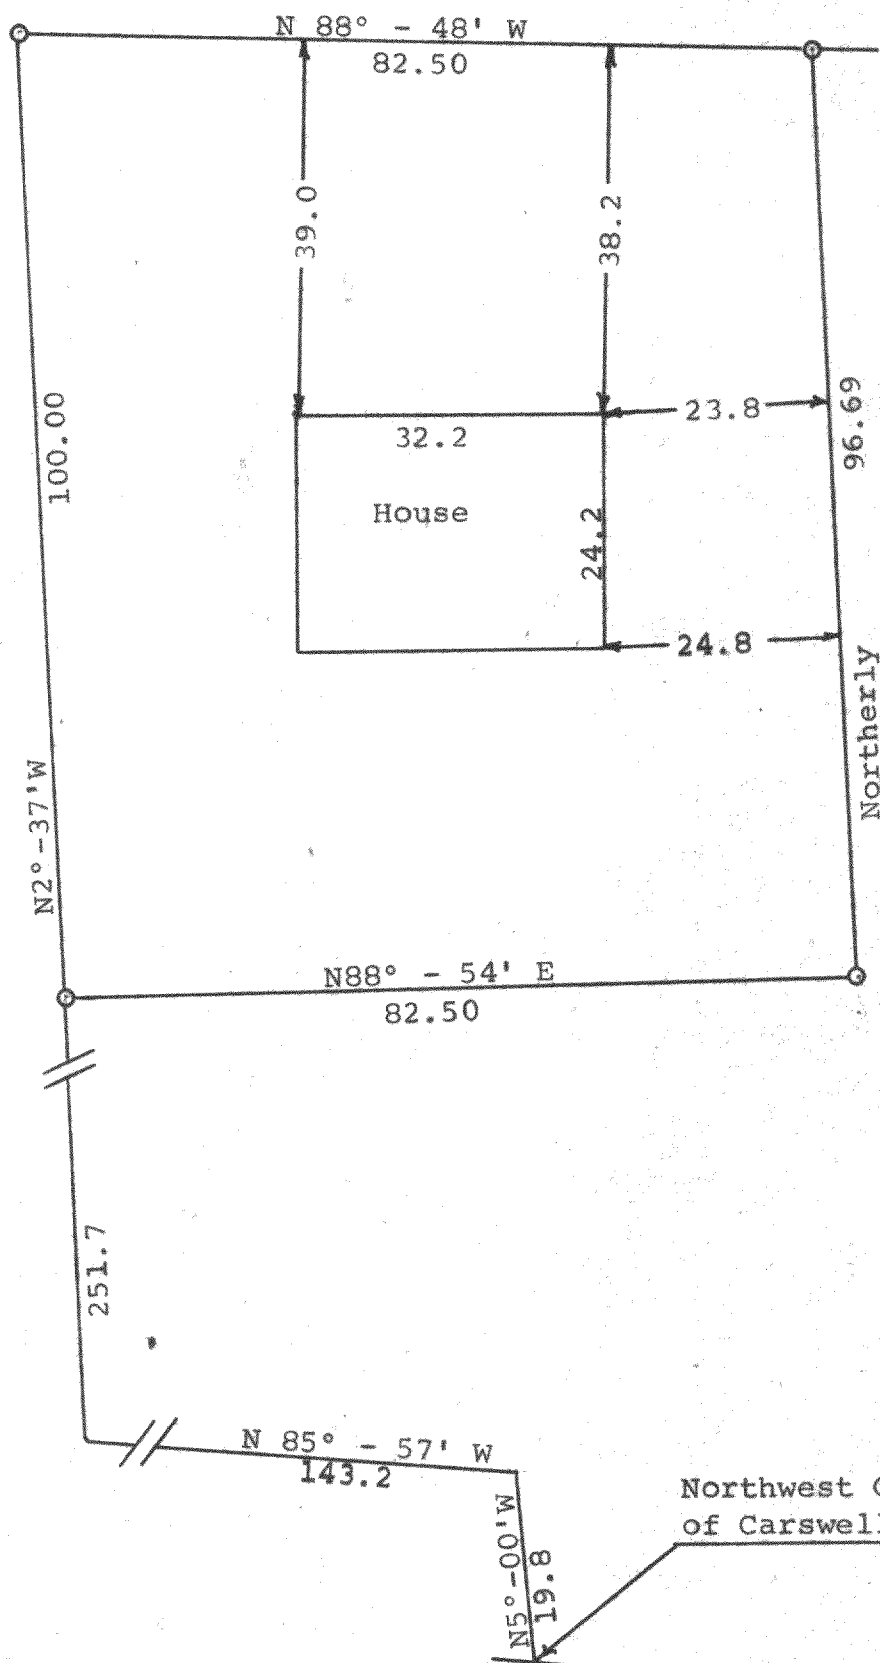

Northwest Corner of Lot 19, Block 3
of Carswell's Park Subdivision

Plat of survey of land located in Lot 14, Block 2 Carswell's
Park Subdivision and in Block 4 of Carswell's Park Subdivision
in Sections 35 & 36, T 4 N, R 16 E, Walworth County, Wisconsin.
March 9, 1970

George T. Dunham
George T. Dunham, Surveyor

CA-56A2

416-41