


416-41.1

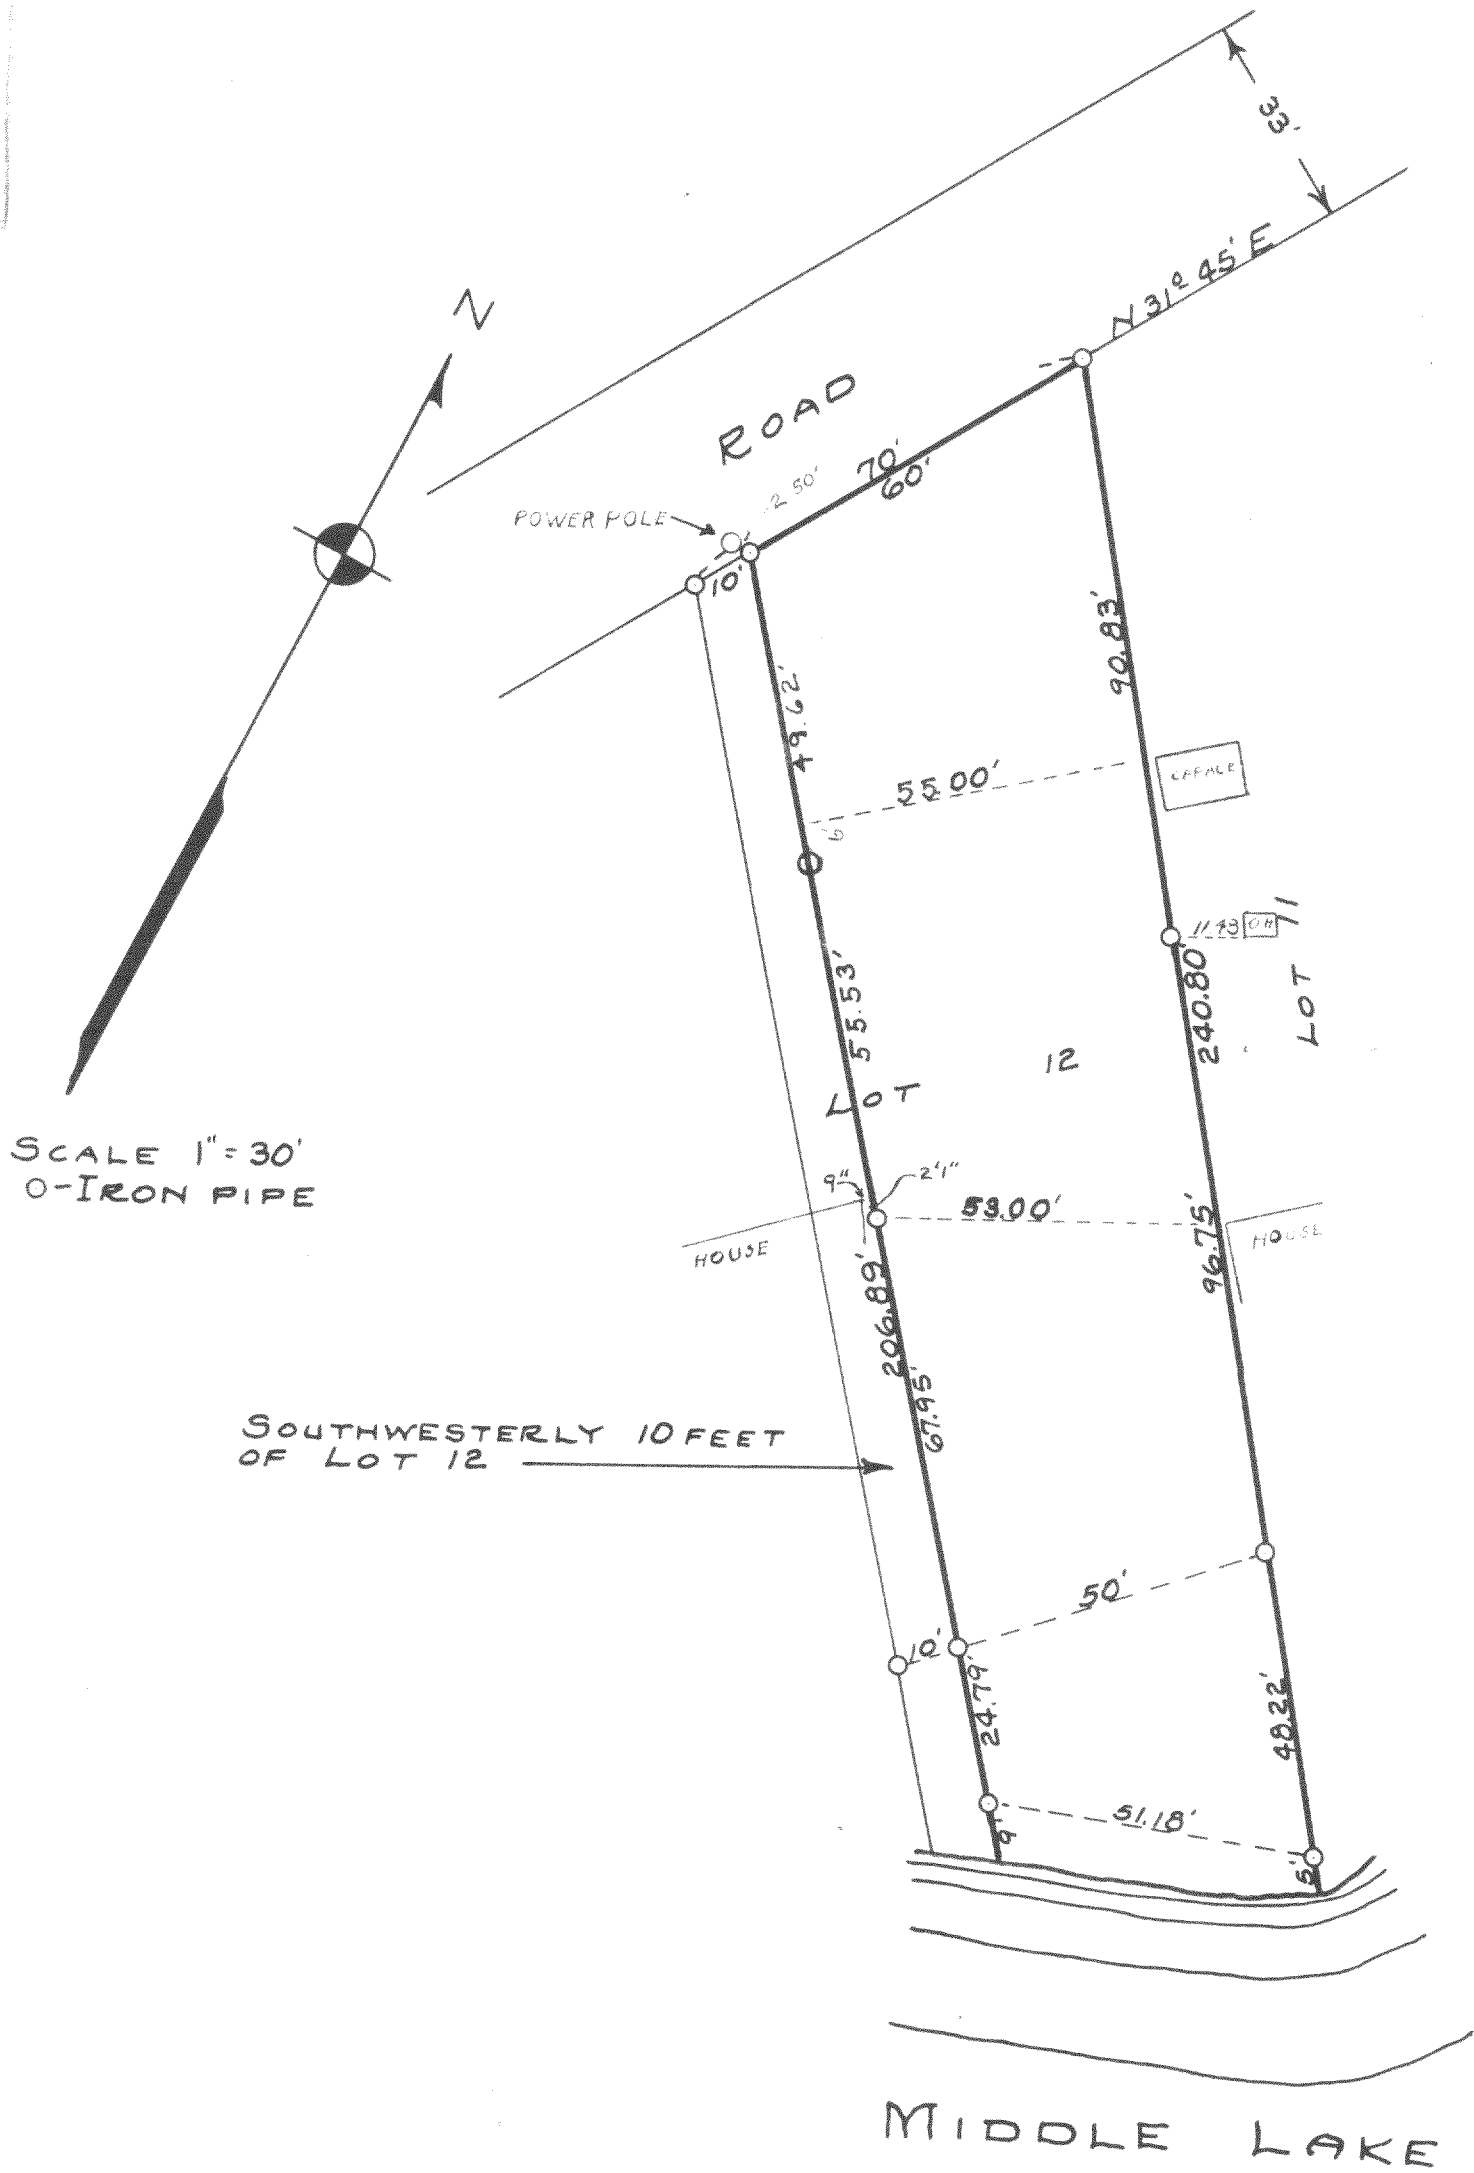

PLAT OF SURVEY OF LOT 12 OF
OAK PARK SUBDIVISION EXCEPTING
THE SOUTHWESTERLY 10 FEET OF SAID
LOT, SAID SUBDIVISION IS LOCATED
IN SECTION 26, T4N R16E OF WAL-
WORTH COUNTY WISCONSIN.

#OP-9

1946

Lloyd D. Jensen
COUNTY SURVEYOR

416-41.1