


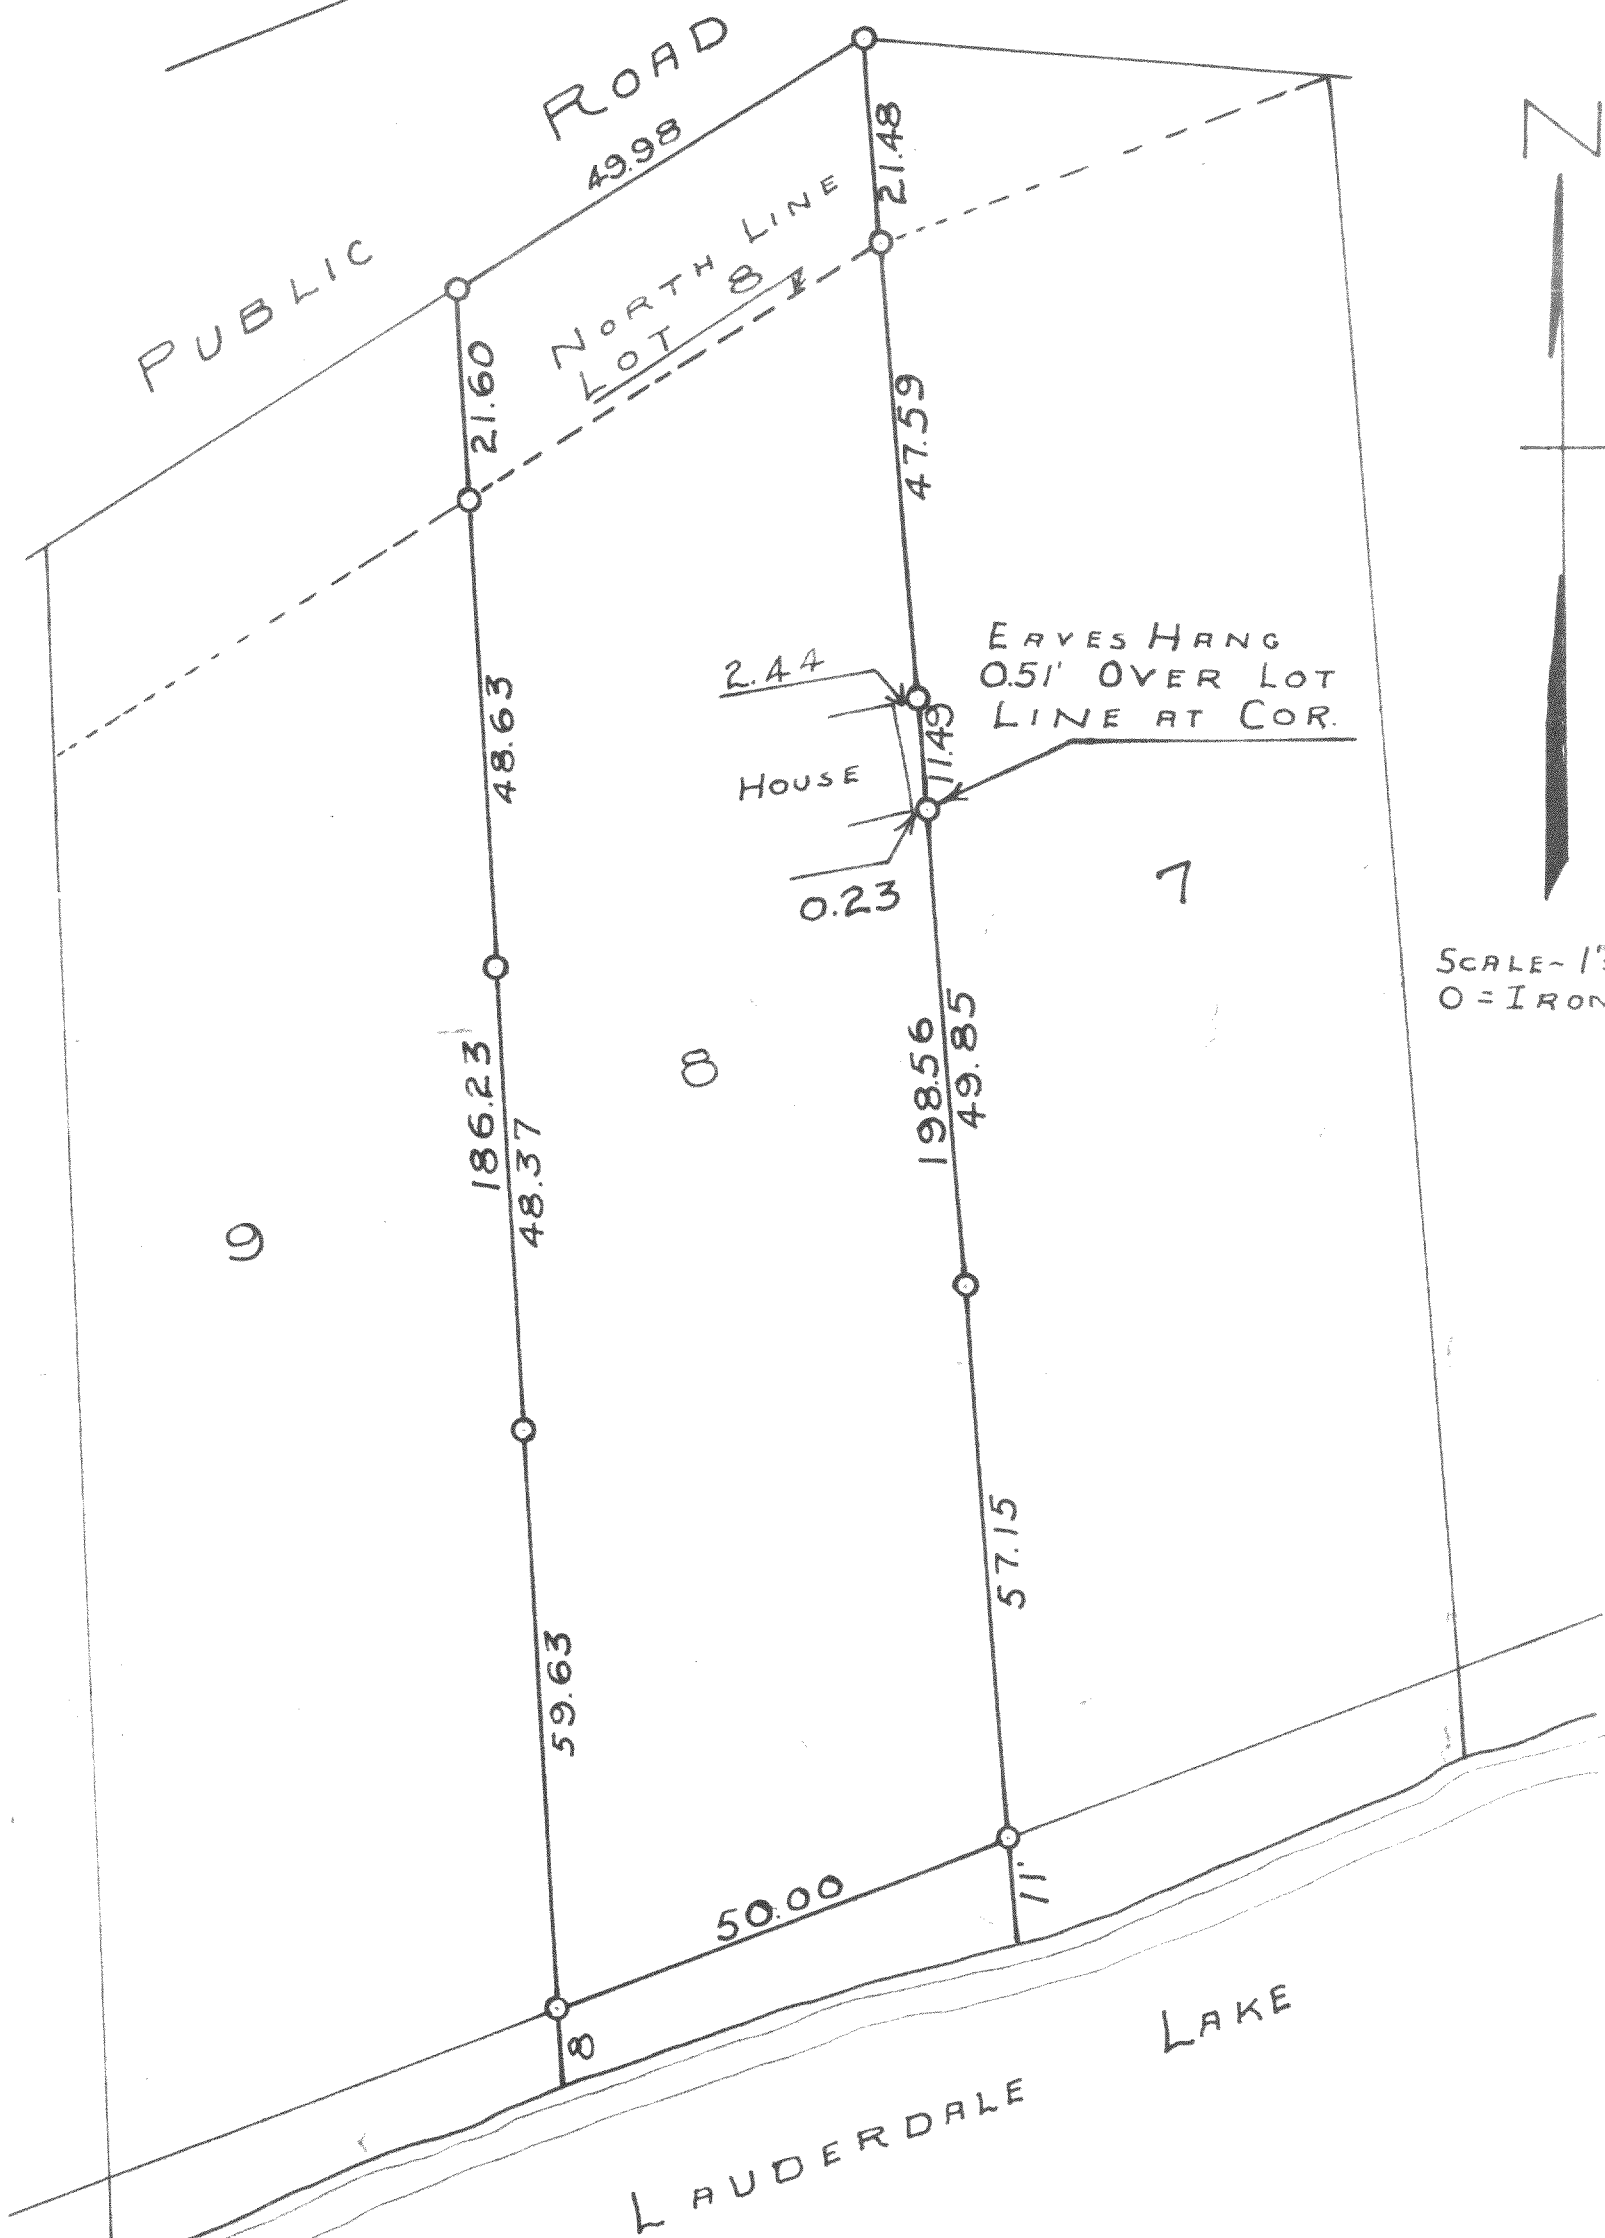

PLAT OF SURVEY OF LOT 8 BLOCK 3 OF
 CARSWELL PARK AND A PARCEL OF LAND
 ON THE NORTH END OF LOT 8 EXTENDING
 TO THE PUBLIC ROAD, LOCATED IN
 SECTION 35, T4NR16E WALWORTH COUNTY
 WISCONSIN
 OCT 1948

Lloyd L. Jensen
 COUNTY SURVEYOR

416-42.

416-42

#CA-30