

D.D. COOPER & CO. INC.


Route 4 Box 5088
Elkhorn WI 53121
Phone-414-723-6265

Plat of survey of lot 16 Arrowhead Park addition number 1
being in the Town of Lagrange Walworth County Wisconsin

Survey ordered by Lauderdale Lakes Realty

Bearing reference: Northerly line
of parcel assumed to bear N46°00'E


Also part of the road in Arrowhead Park
Addition #1, Described as beginning at
the Southwest corner of lot 16 of said
Subdivision: thence S81°01'E 93.93 feet;
thence S46°00'W 82.66 feet; thence N81°01'W
93.33 feet; thence N46°00'E 82.66 feet to
the point of beginning.

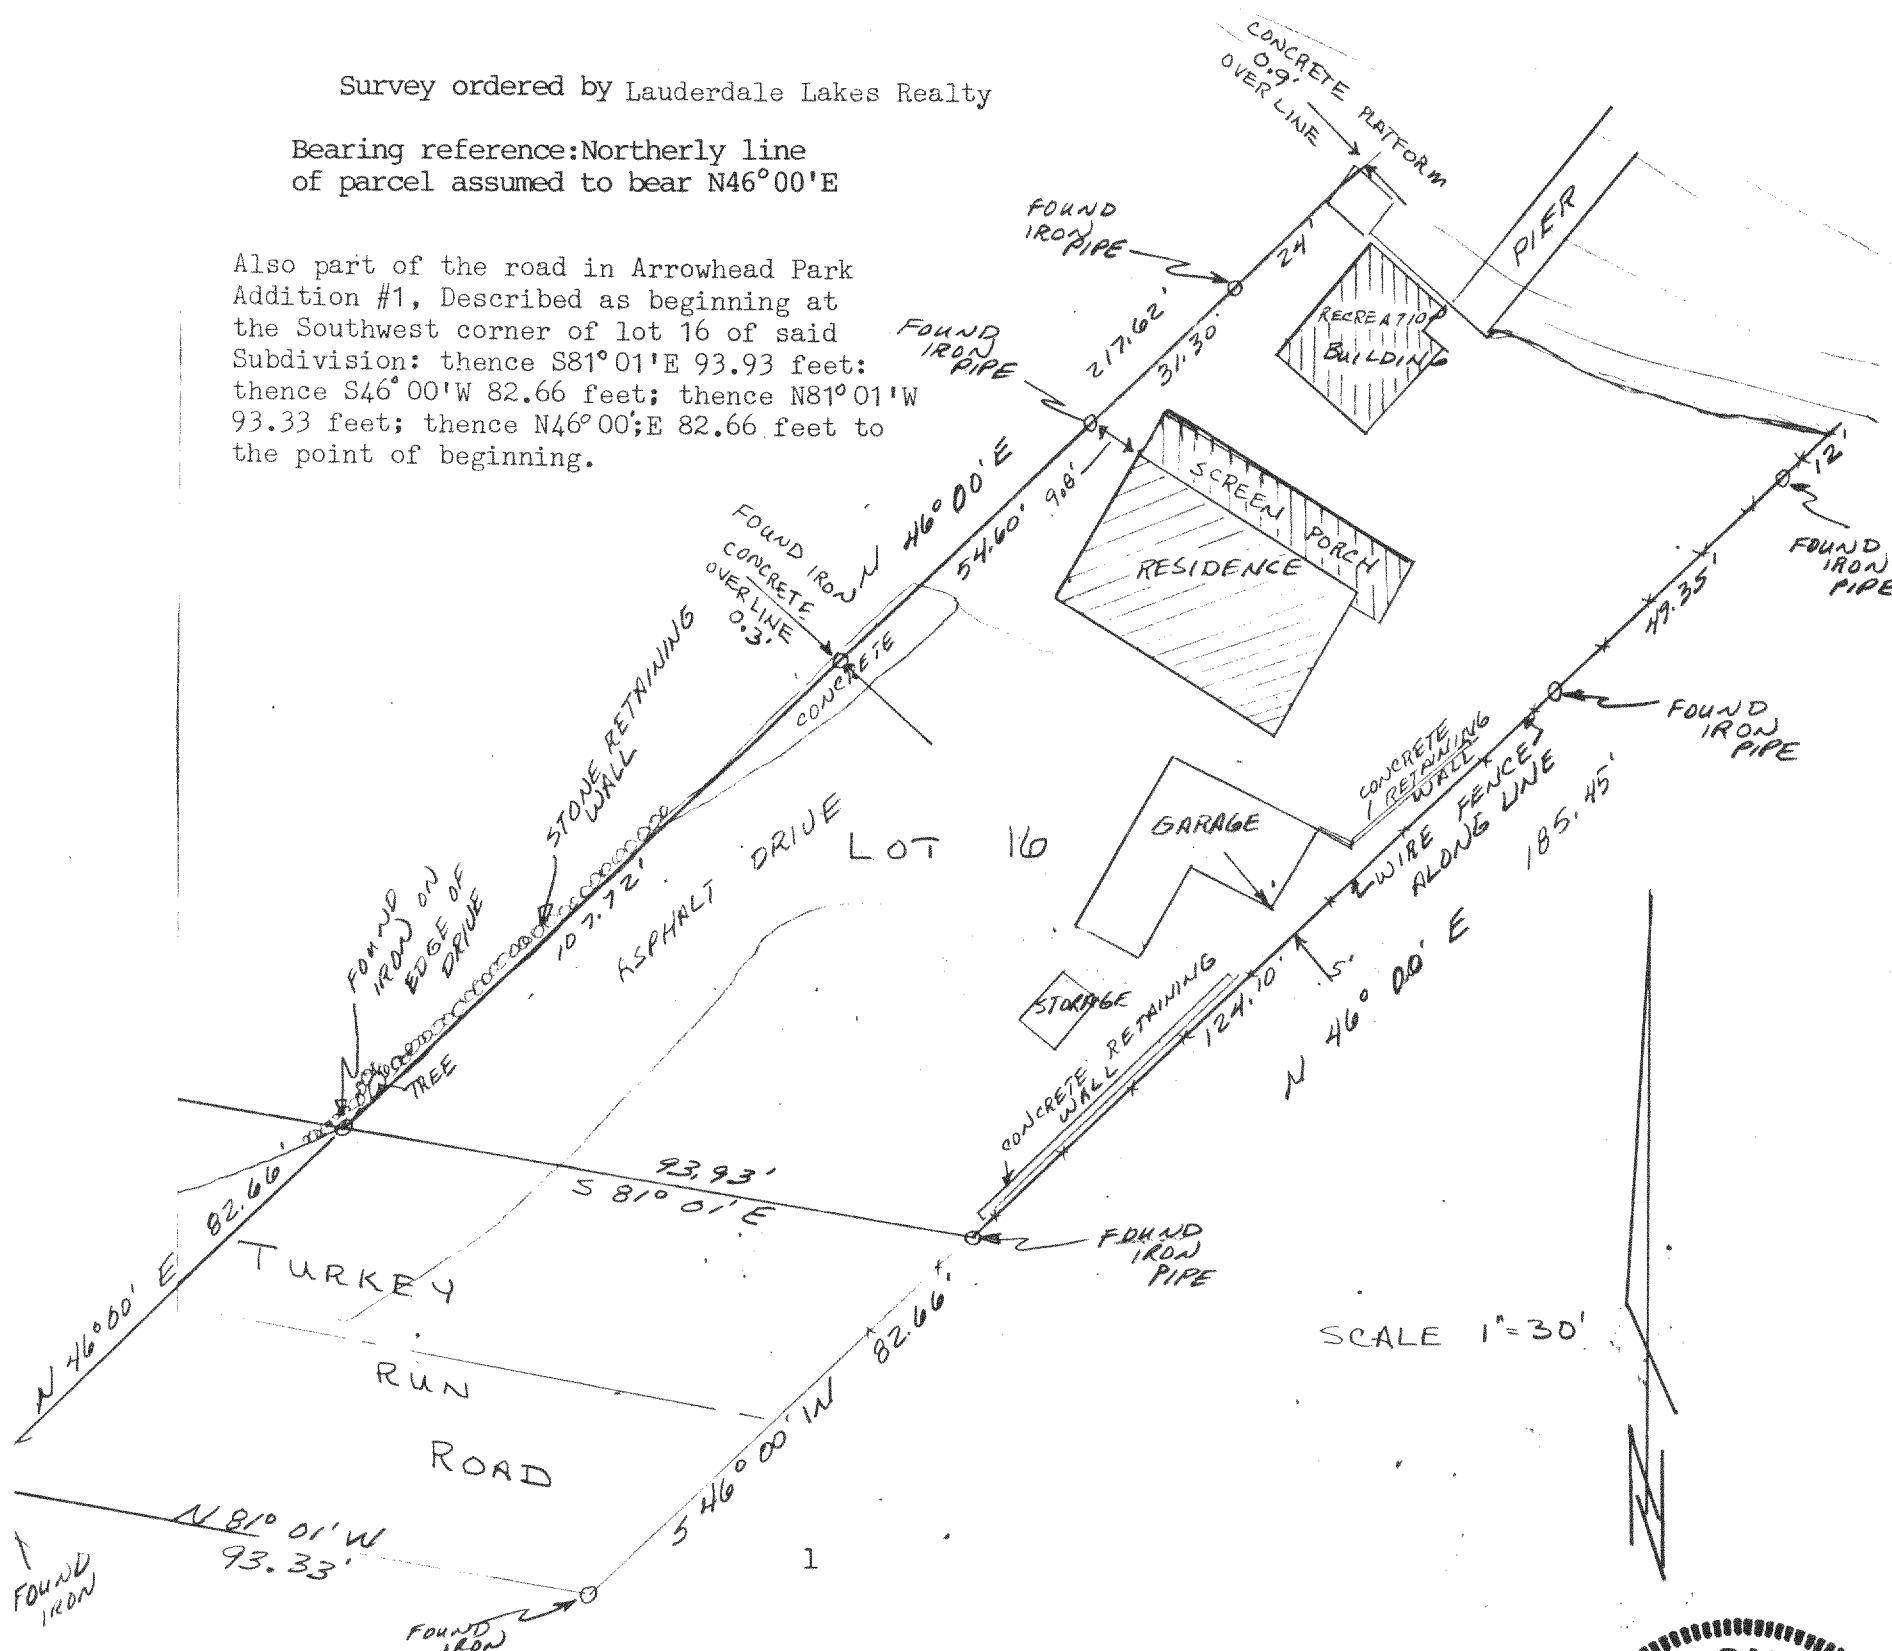

I, Daniel D. Cooper, Registered Land Surveyor do hereby certify that
I have surveyed the property described hereon and that the map shown
hereon is a true and accurate representation thereof to the best of my
professional knowledge and belief.

Dated this 8th day of July 1986

Daniel D. Cooper
Daniel D. Cooper, RLS NO. S-1464

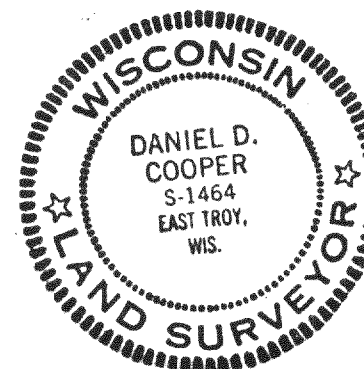

DRAWING NO 2256-5-34

HAPA 00006

416-420