
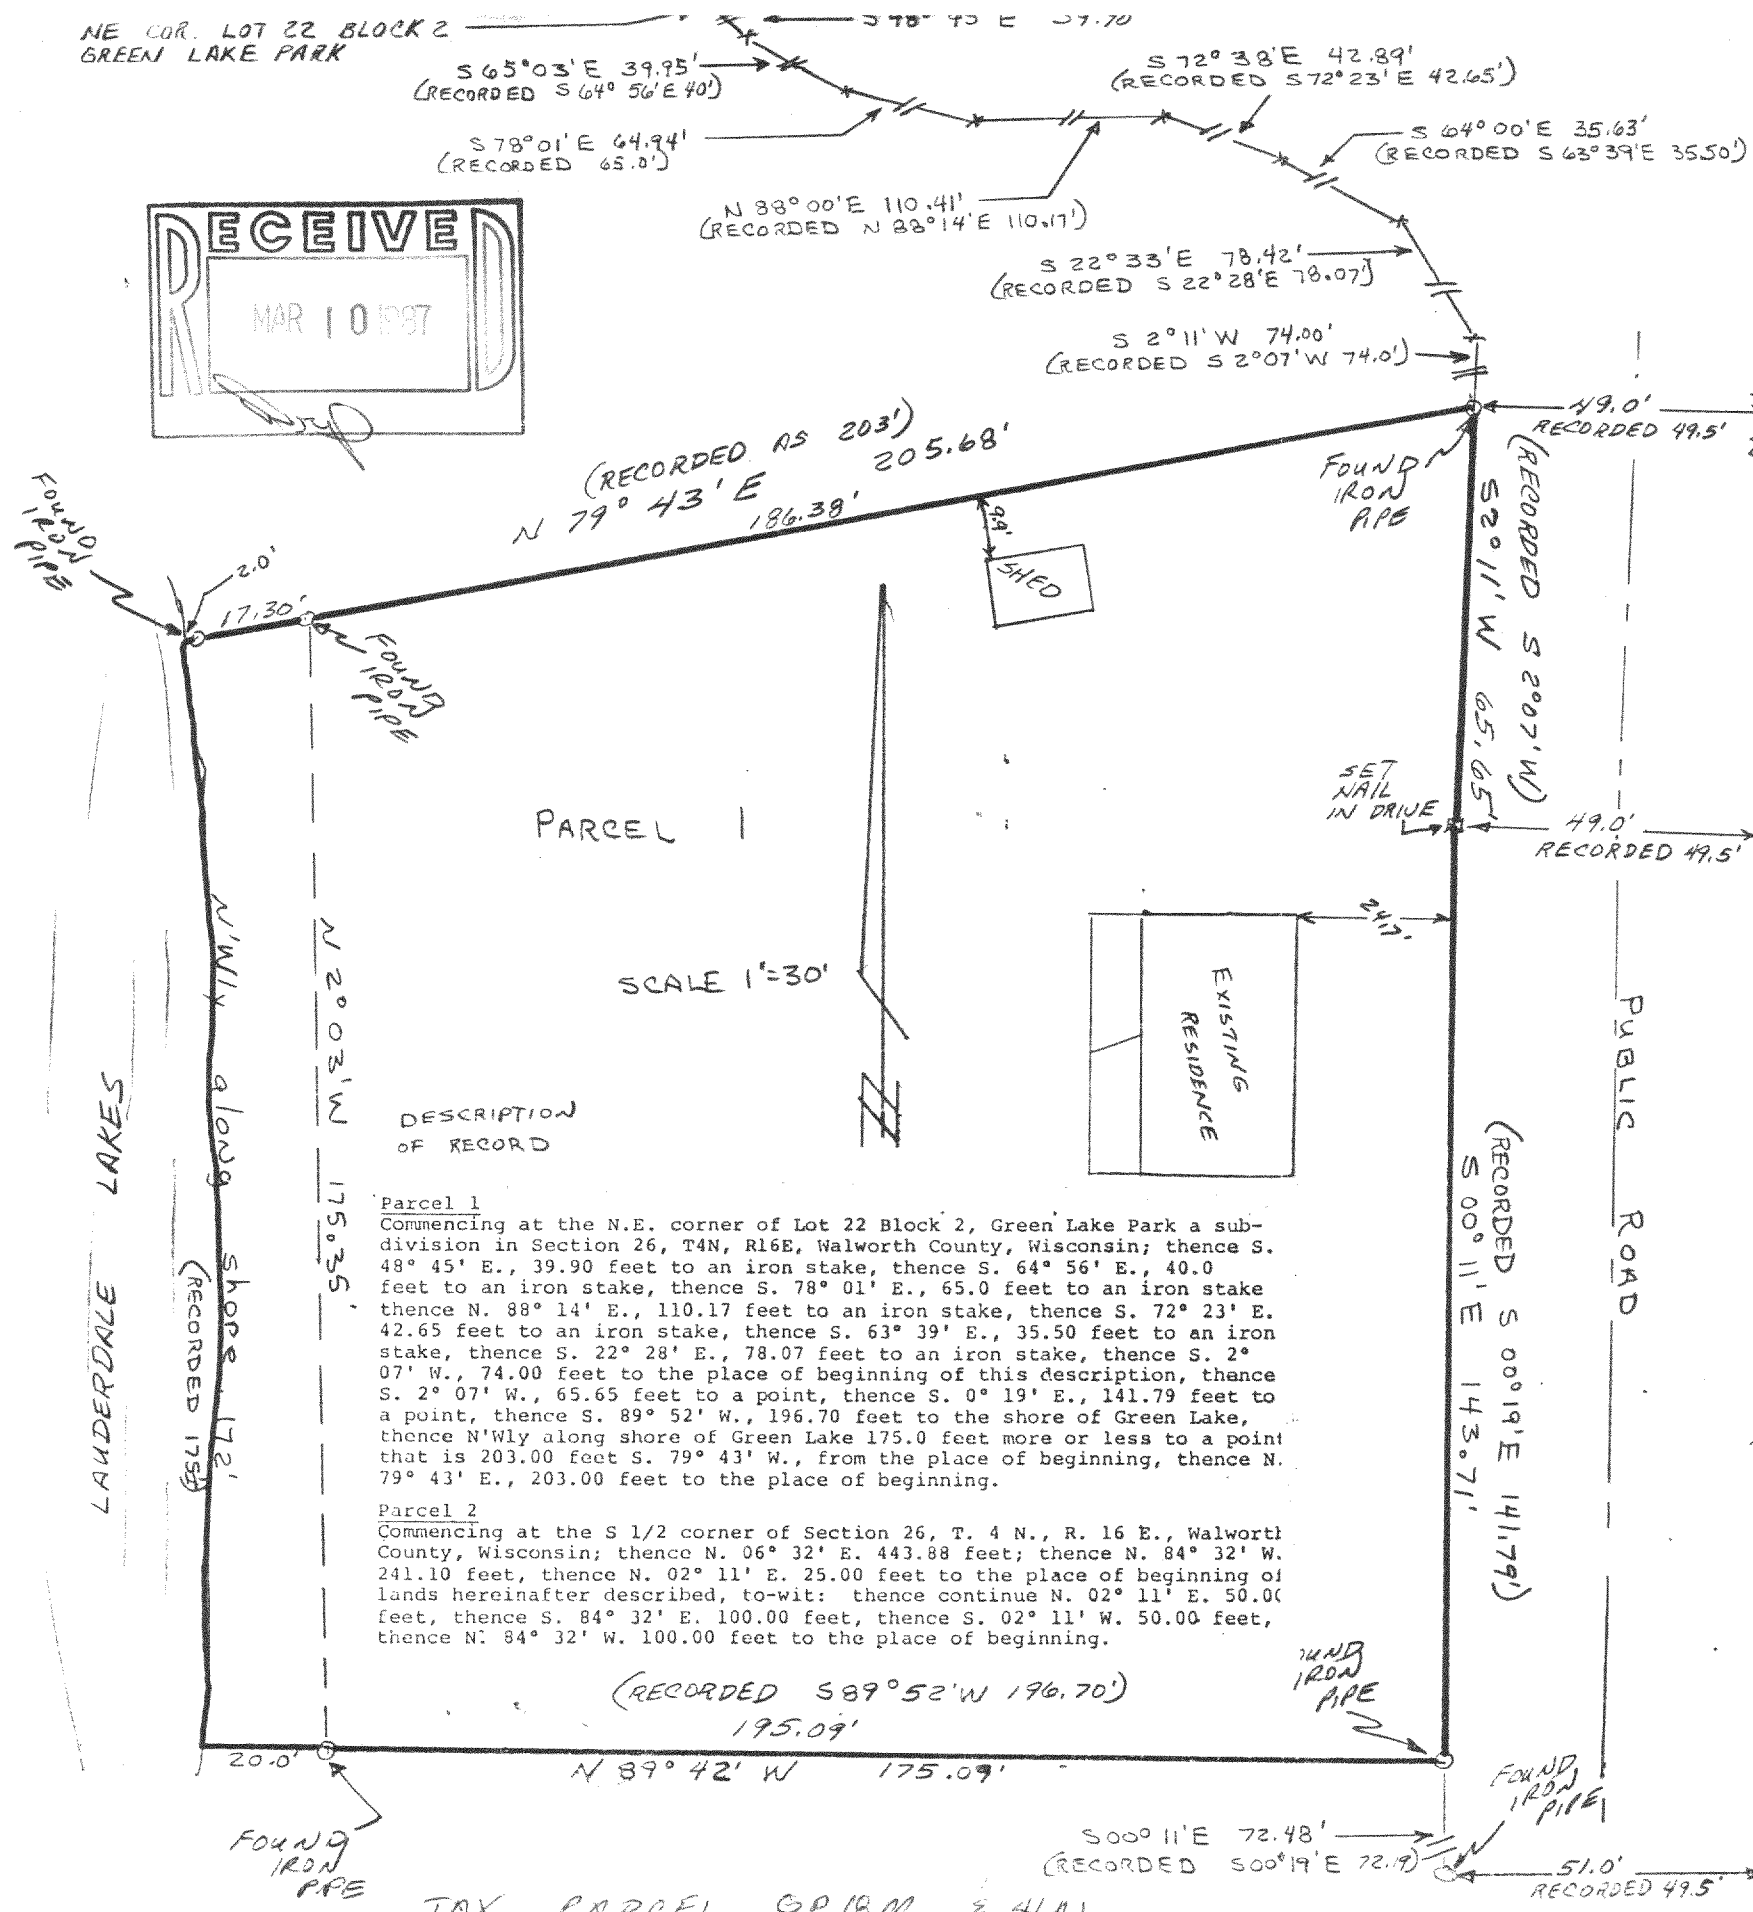


NE COR. LOT 22 BLOCK 2
GREEN LAKE PARK

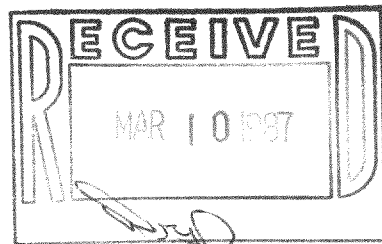

D. D. COOPER & CO., INC.
Daniel D. Cooper
Rt. 4 Box 508B
Elkhorn, WI 53121

I hereby certify that I have surveyed the property described hereon and that the map shown hereon is a true and accurate representation thereof to the best of my professional knowledge and belief.

Dated this 5 day of Mar., 1987

Daniel D. Cooper, Surveyor No. S-1264
COOPER
S-1264
WIS.

Survey ordered by John Summerfield
Park Ridge Ill

Bearing reference: Northerly line of parcel assumed to bear N79 43'E as recorded.