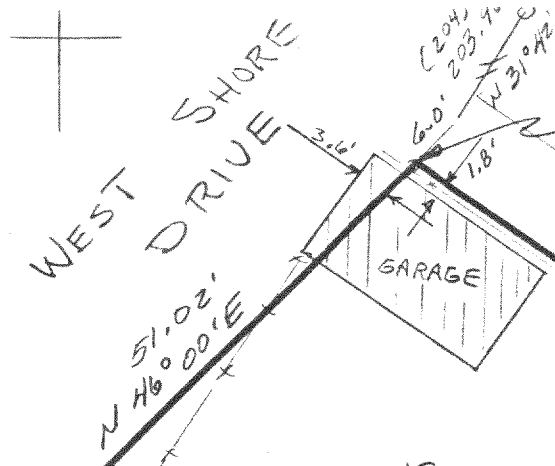


D. D. COOPER & CO., INC.
Daniel D. Cooper
Rt. 4 Box 508B
Elkhorn, WI 53121

Plat of survey of the Northerly 60 ft. excepting
there from the Northerly 10 ft. of lot 14
Morris Park subdivision, being located in town
4 North range 16 East, Walworth County Wisconsin.

SCALE 1"=20'


BEARING REFERENCE: EASTERLY LINE OF
WEST SHORE DRIVE ASSUMED TO
BEAR N 46° 00' E

CHAIN
LINK
FENCE
ON LINE

FOUND
IRON
PIPE

FOUND
IRON
PIPE

NORTHERLY
LINE
S 54° 14' E

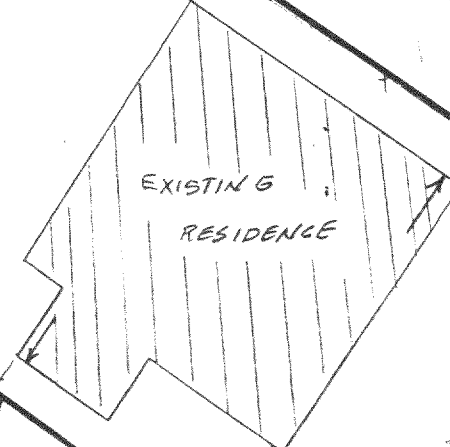

EXISTING
RESIDENCE

(RECORDED)

554° E

190.78'

LOT 14

CHAIN LINK
FENCE
ON INSIDE
LINE

SOUTHERLY
LINE
(RECORDED)

S 54° 07' E

204.93'

LOT 14

S 56° E

WIRE FENCE
ON INSIDE
LINE

224.10'
(RECORDED 220')

SET 1" x 24" IRON PIPE

34'


N 30° 03' E

50.93'

(RECORDED 50')

FOUND
IRON
PIPE

LAUDERDALE LAKES

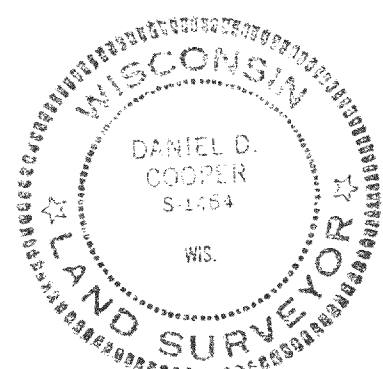

I, Daniel D. Cooper, Registered Land Surveyor do hereby certify that
I have surveyed the property described hereon and that the map shown
hereon is a true and accurate representation thereof to the best of my
professional knowledge and belief.

Dated this 24 day of MAR., 1987

HMD-11A

Daniel D. Cooper
Daniel D. Cooper, RLS NO. S-1464

DRAWING NO 3048-5-3

416-426