

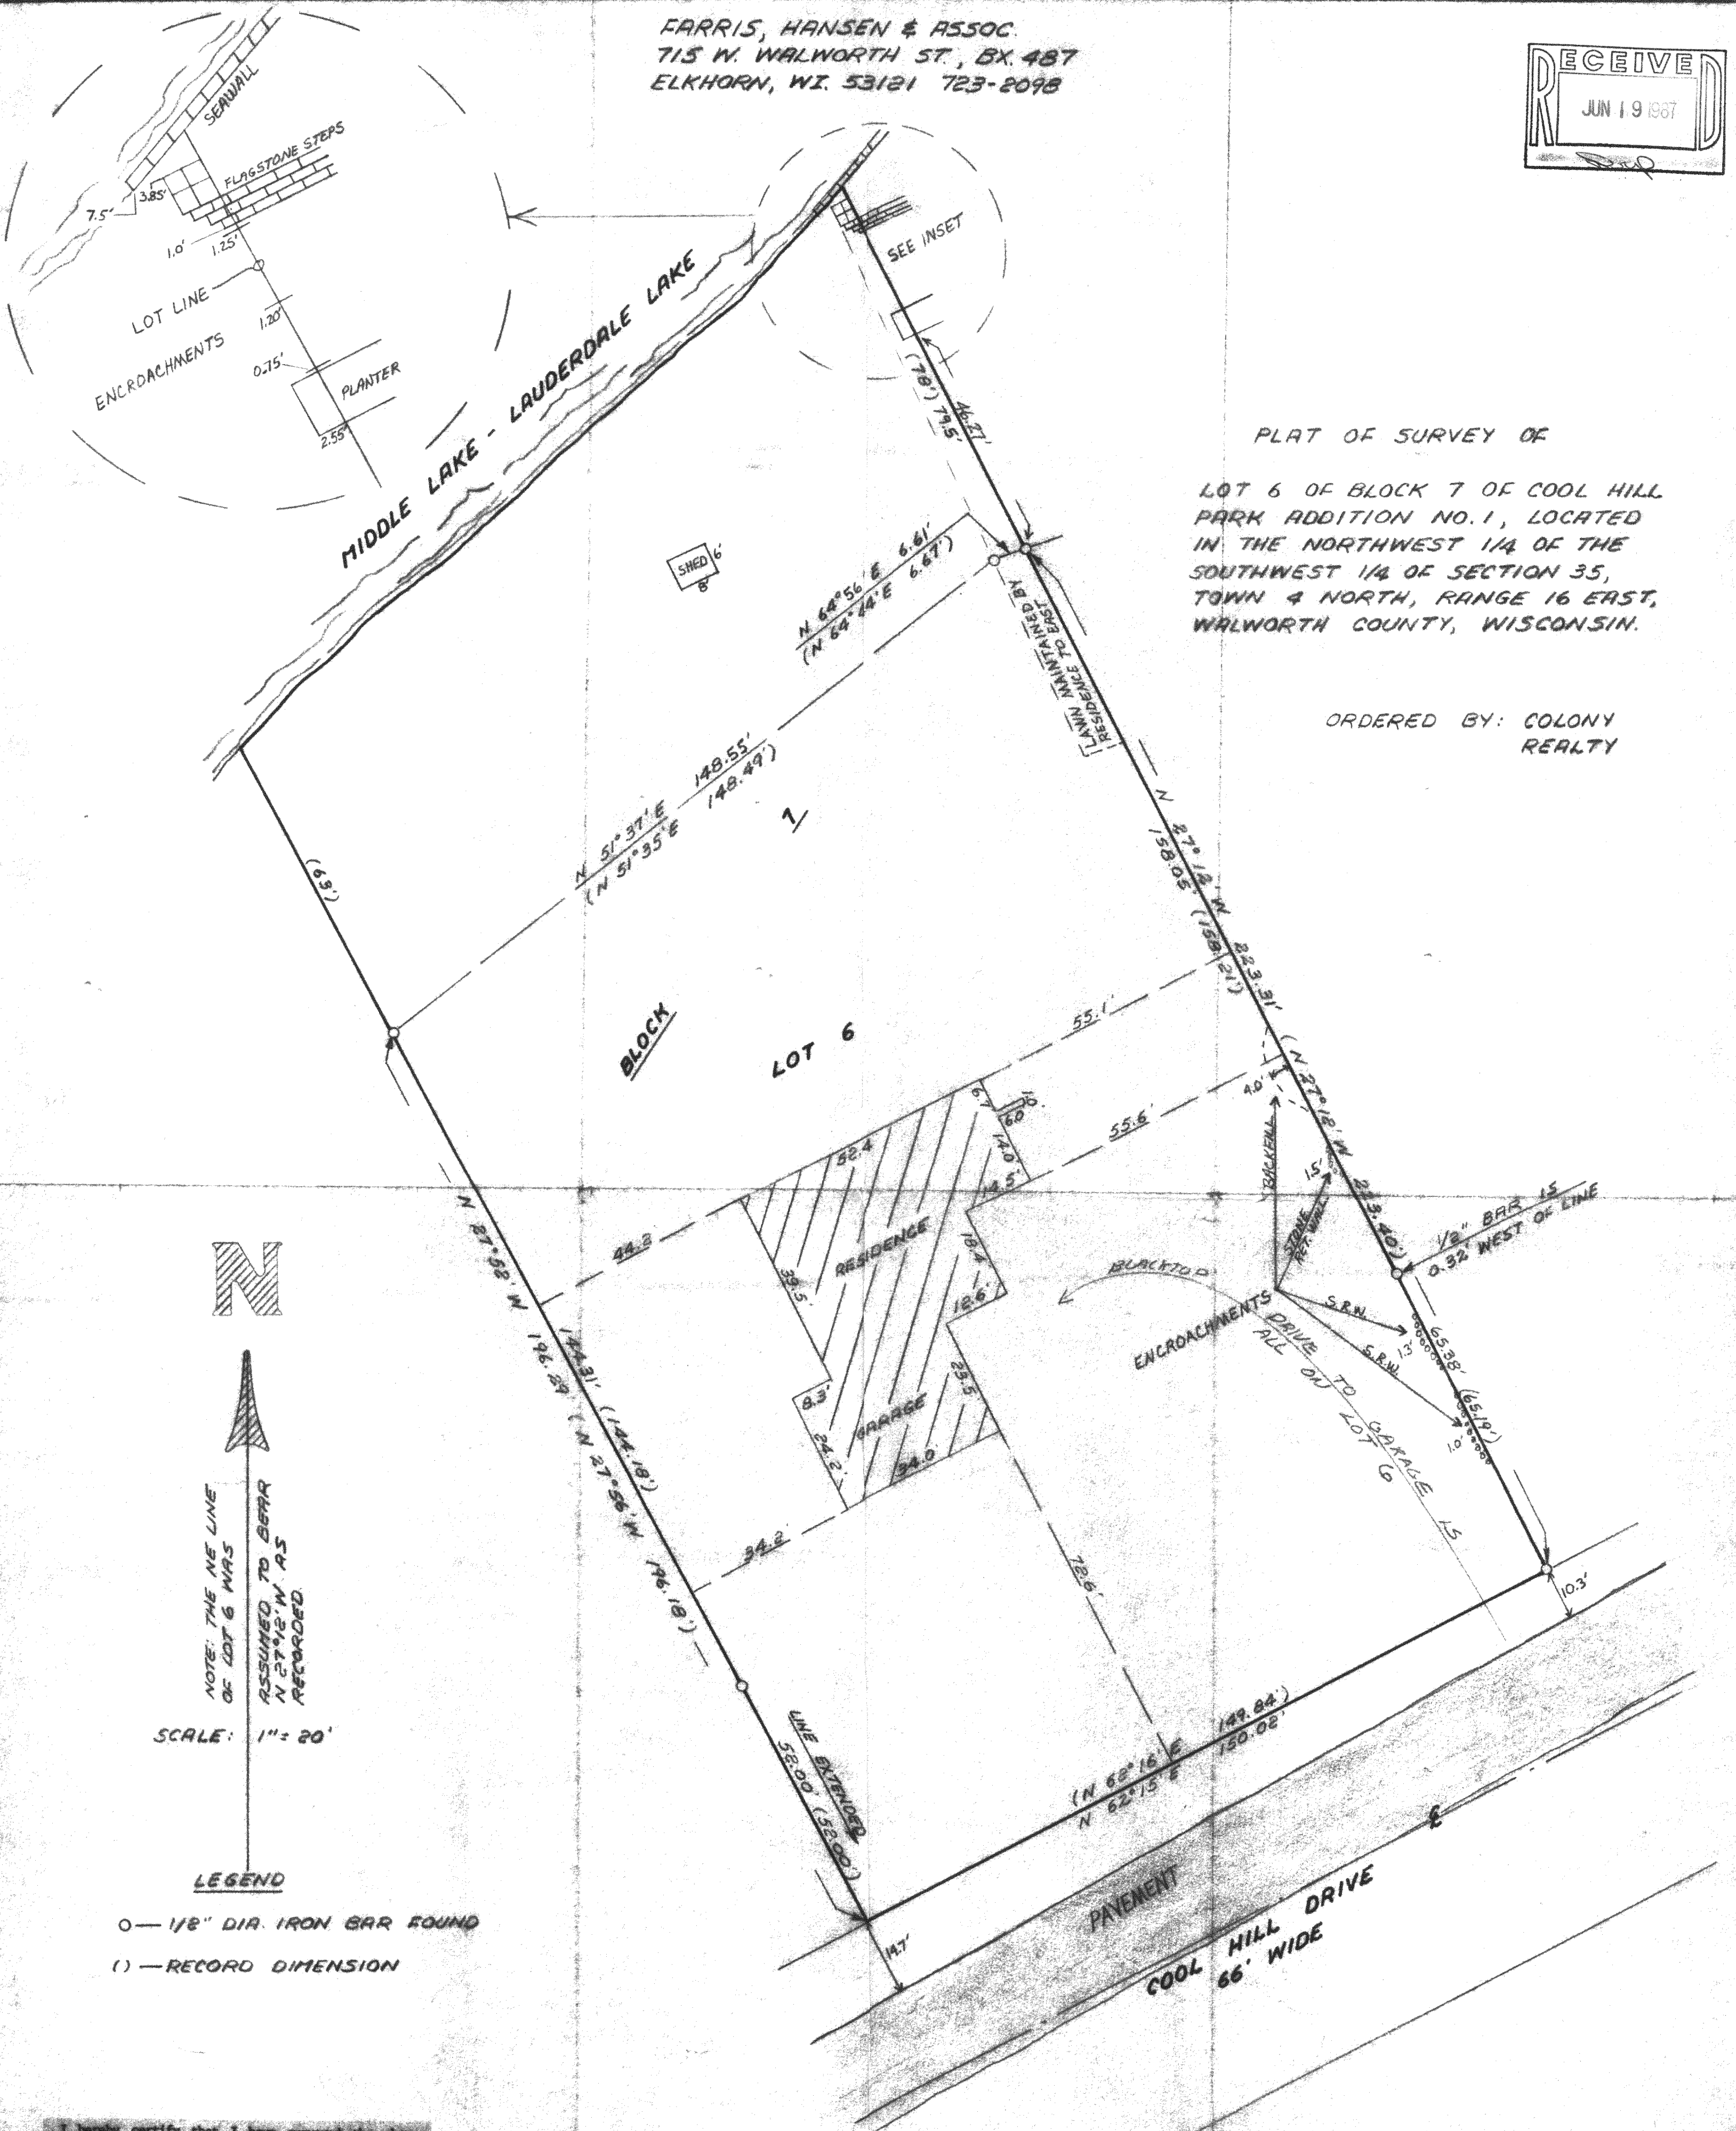


FARRIS, HANSEN & ASSOC.
715 W. WALWORTH ST., BX. 487
ELKHORN, WI. 53121 723-2098

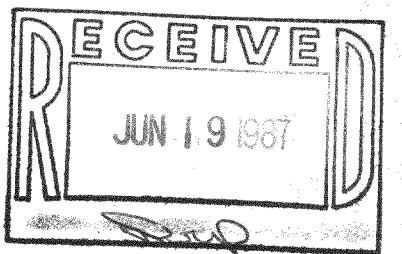

I hereby certify that I have surveyed the above described property and that the above map is a true representation thereof and show the size and location of the property, its exterior boundaries, the location of all visible structures and dimensions of all principal buildings thereon, boundary fences, apparent easements, roadways and visible encroachments, if any. This survey is made for the use of the present owners of the property, and also those who purchase, mortgage, or guarantee the title thereto within one (1) year from the date thereof.

Robert A. Farris
DATED 3/27/87

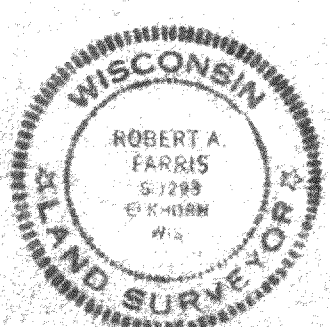

PROJECT NO. 2747
416-440