


COOPER SURVEYING SERVICES

Rural - Residential - Commercial

Route 3, Box 255 :: Elkhorn, Wisconsin 53121

Phone (414) 723-6265

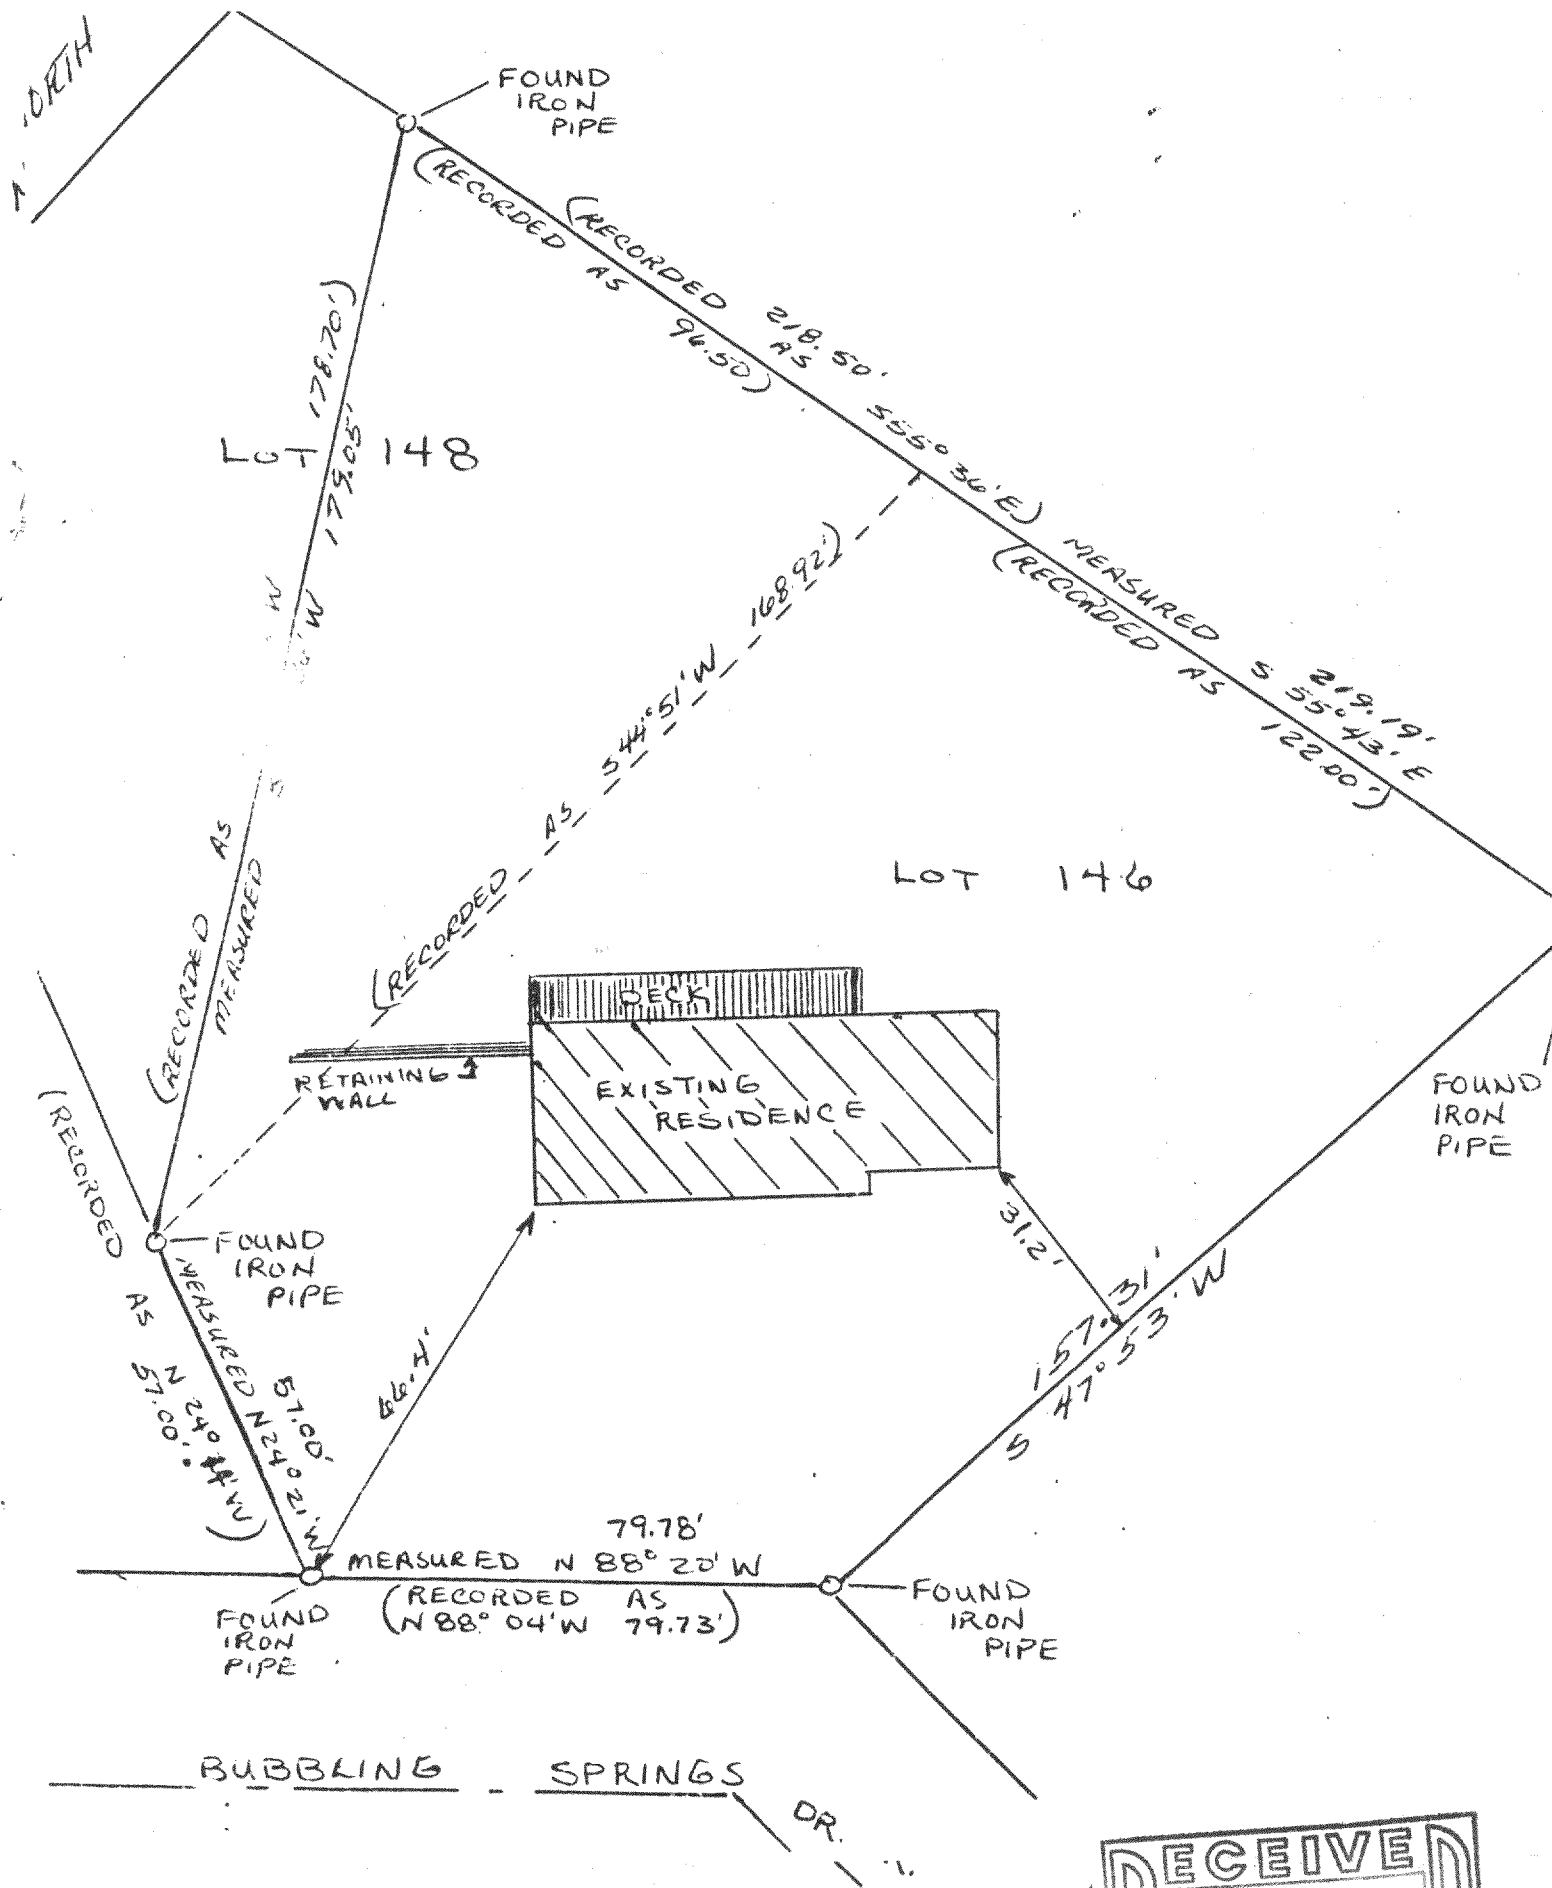

SCALE 1" = 30'


Plat of survey of Lot 146 of Bubbling Springs
2nd Addition and also a parcel described as
beginning at the Southerly most corner of Lot
148 of Bubbling Springs Subdivision 2nd Addition
thence N44 51'E 168.92 feet; thence N55 36'W 96.50
feet; thence S12 46'W 178.70 feet to the point
of beginning all being located in Section 34,
T 4 N, R 16 E, Walworth County, Wisconsin.

Survey ordered by John Hohlfelder
Rt 1 Elkhorn WI

Bearing Reference: Easterly line of Lot 146
assumed to bear S 47 53' W

I hereby certify that I have surveyed the property described
hereon as it was found to be monumented and that the above map
is a true and accurate representation thereof to the best of
my professional knowledge and belief.

Dated this _____ day of _____, 1983

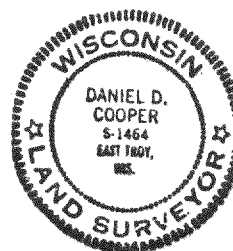

Daniel D. Cooper, RLS No. S-1464
East Troy, Wis. 53121
Surveyed and monumented the above described property
on the 1st day of May, 1983.