
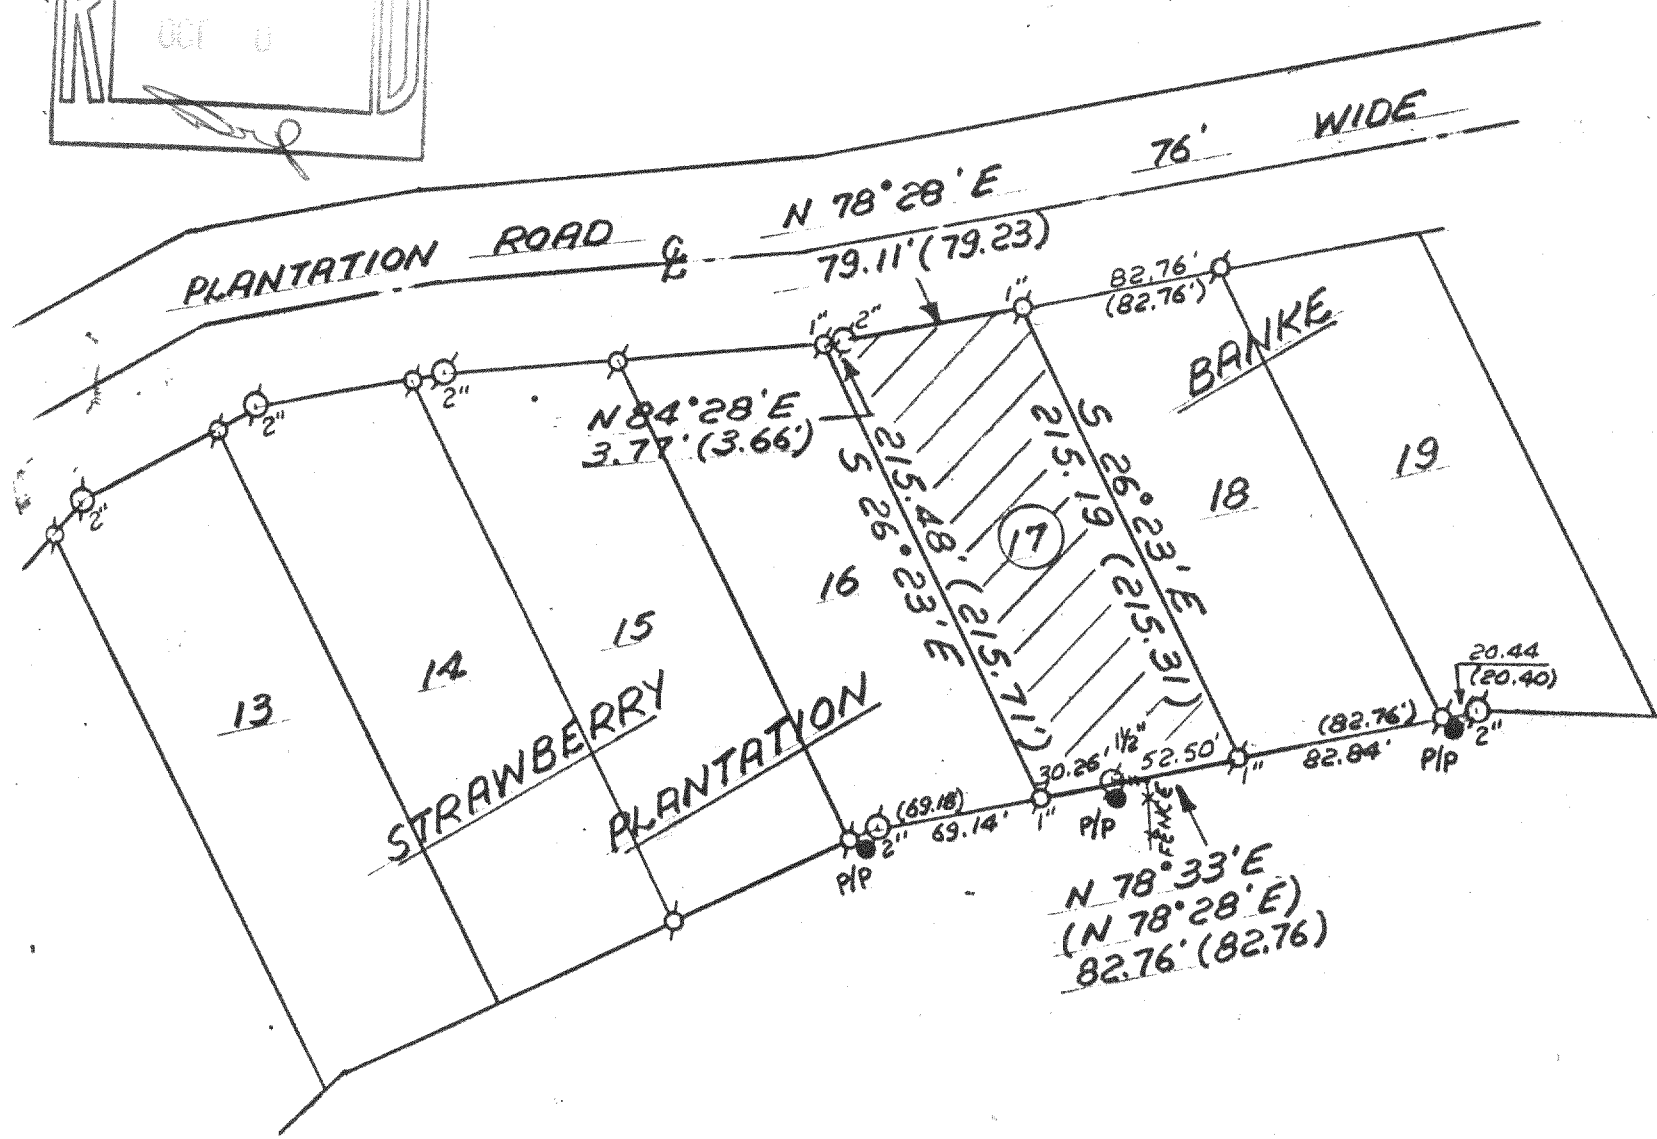


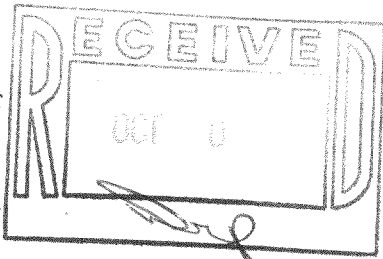


PLAT OF SURVEY OF LOT 17 OF STRAWBERRY BANKE PLANTATION, A SUBDIVISION LOCATED IN THE SOUTHWEST 1/4 OF SECTION 36, TOWN 4 NORTH, RANGE 16 EAST, AND IN THE NORTHWEST 1/4 OF SECTION 1, TOWN 3 NORTH, RANGE 16 EAST, WALWORTH COUNTY, WIS.


I, DANIEL D. COOPER, REGISTERED SURVEYOR, DO HEREBY CERTIFY THAT I HAVE SURVEYED THE PROPERTY DESCRIBED HEREON AND THAT THE MAP SHOWN HEREON IS A TRUE AND ACCURATE REPRESENTATION THEROF TO THE BEST OF MY PROFESSIONAL KNOWLEDGE AND BELIEF.

DATED THIS 13 DAY OF Dec., 1984 Daniel D. Cooper
DANIEL D. COOPER, RLS NO. S-1464

- LEGEND**
○ — IRON PIPE FOUND
() — RECORD DIMENSION
● — POWER POLE
PIP

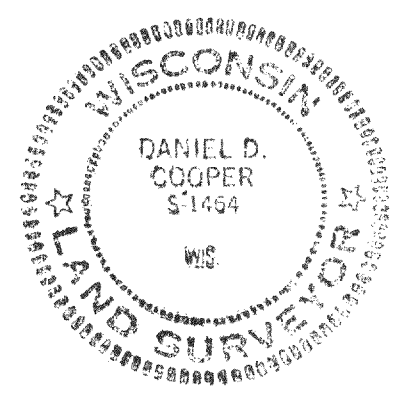

OWNER: CLARICE A CIULINI
6359 S. KEELER
CHICAGO, IL. 60629

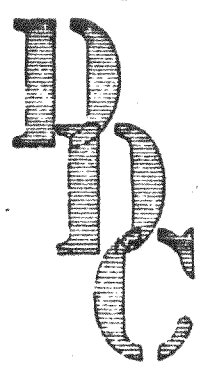


D.D. COOPER & CO. INC.

ROUTE 4, BOX 508 S
ELEXHORN, WI 53121

PH 414-723-6265

SURVEYING • MODULAR HOMES

NOTE: THE EASTERLY LINE OF LOT 17 WAS ASSUMED TO BEAR S 26° 23' E AS SHOWN ON THE SUBDIVISION PLAT OF STRAWBERRY BANKE PLANTATION.

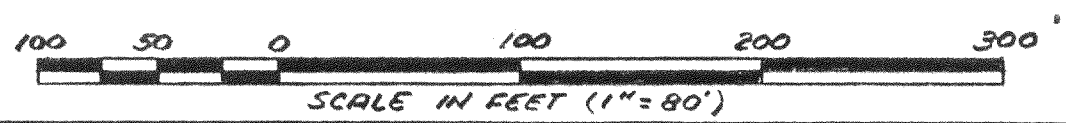

1995
PROJ. NO. 1985