


PLAT OF SURVEY

of  
Lot 4 of Bubbling Springs Subdivision, located in Section 34,  
Town 4 North, Range 16 East, Town of LaGrange, Walworth  
County, Wisconsin.

Surveyed for: Colony Realty  
16 East Walworth Street  
Elkhorn, Wisconsin 53121

Surveyed by: Jensen Surveying & Mapping S.C.  
45 South Wisconsin Street P.O. Box 322  
Elkhorn, Wisconsin. 53121

Mapping date: September 4, 1987

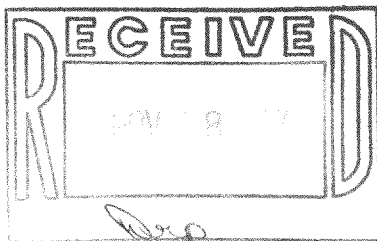


SCALE: 1" = 30'

LEGEND

○ ~ FOUND IRON PIPE

BEARINGS REFERENCED TO  
THE SUBDIVISION PLAT

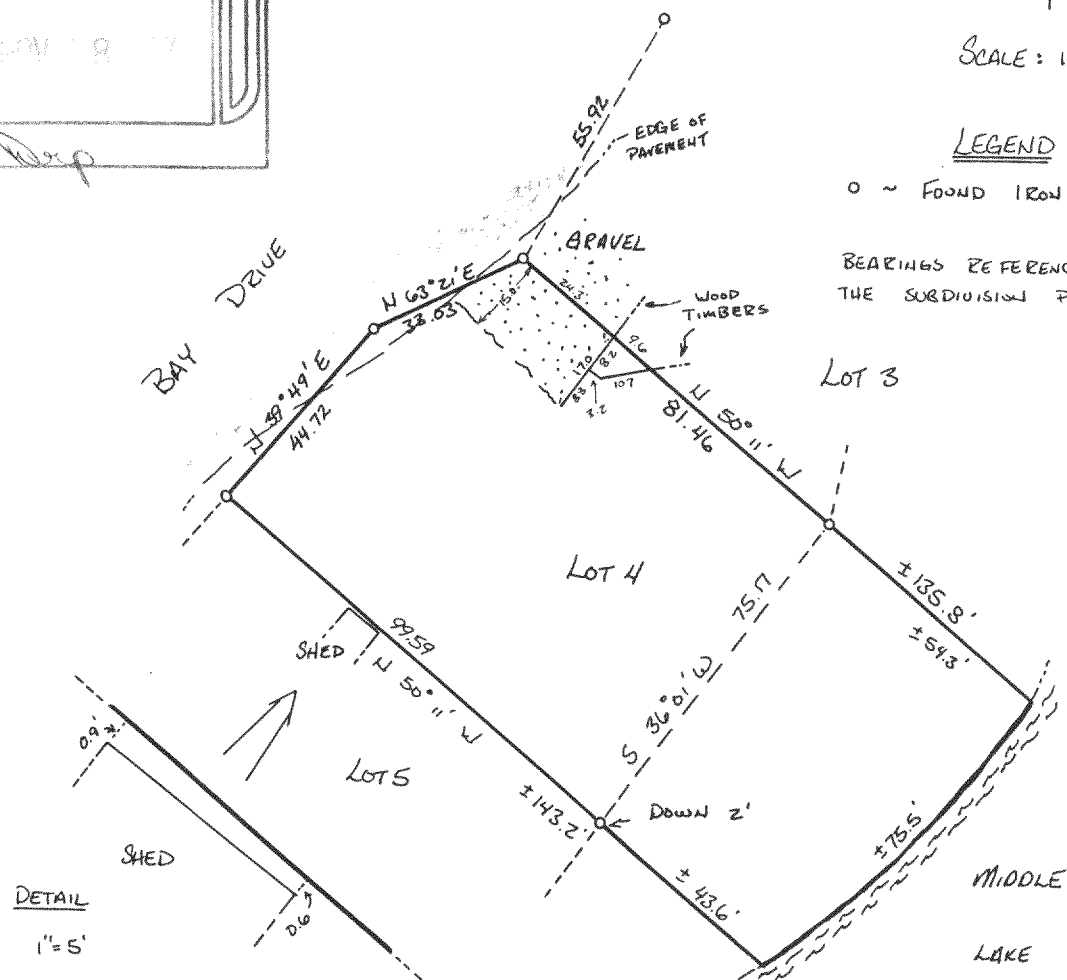

Copyright © 1987 by Jensen Surveying & Mapping S.C.

All rights reserved. No part of this survey plat may be reproduced or transmitted in any form by any means - graphic, electronic, or mechanical, including photocopying, tracing, or information storage and retrieval systems - without permission in writing from Thomas P.A. Jensen, Jensen Surveying & Mapping S.C.

I, Thomas P.A. Jensen, Wisconsin Registered Land Surveyor, do hereby certify that this survey was performed by me, or under my direction, in full compliance with the owner's/agent's instructions and Chapter A-E 5 of the Wisconsin Administrative Code "Minimum Standards For Property Surveys"; and that this map is an accurate representation thereof to the best of my knowledge and belief.

Note: This survey plat is not certified unless signed and sealed in red ink.

Thomas P.A. Jensen R.L.S-1084  
Jensen Surveying & Mapping S.C.

Job REFERENCE No. 1987.101