




Rt 4 Box 508B * Elkhorn WI 53121

Plat of survey of Lot 9, block 2, of Pebble Beach subdivision in the town of LaGrange, Walworth County, Wisconsin.

O = IRON PIPE

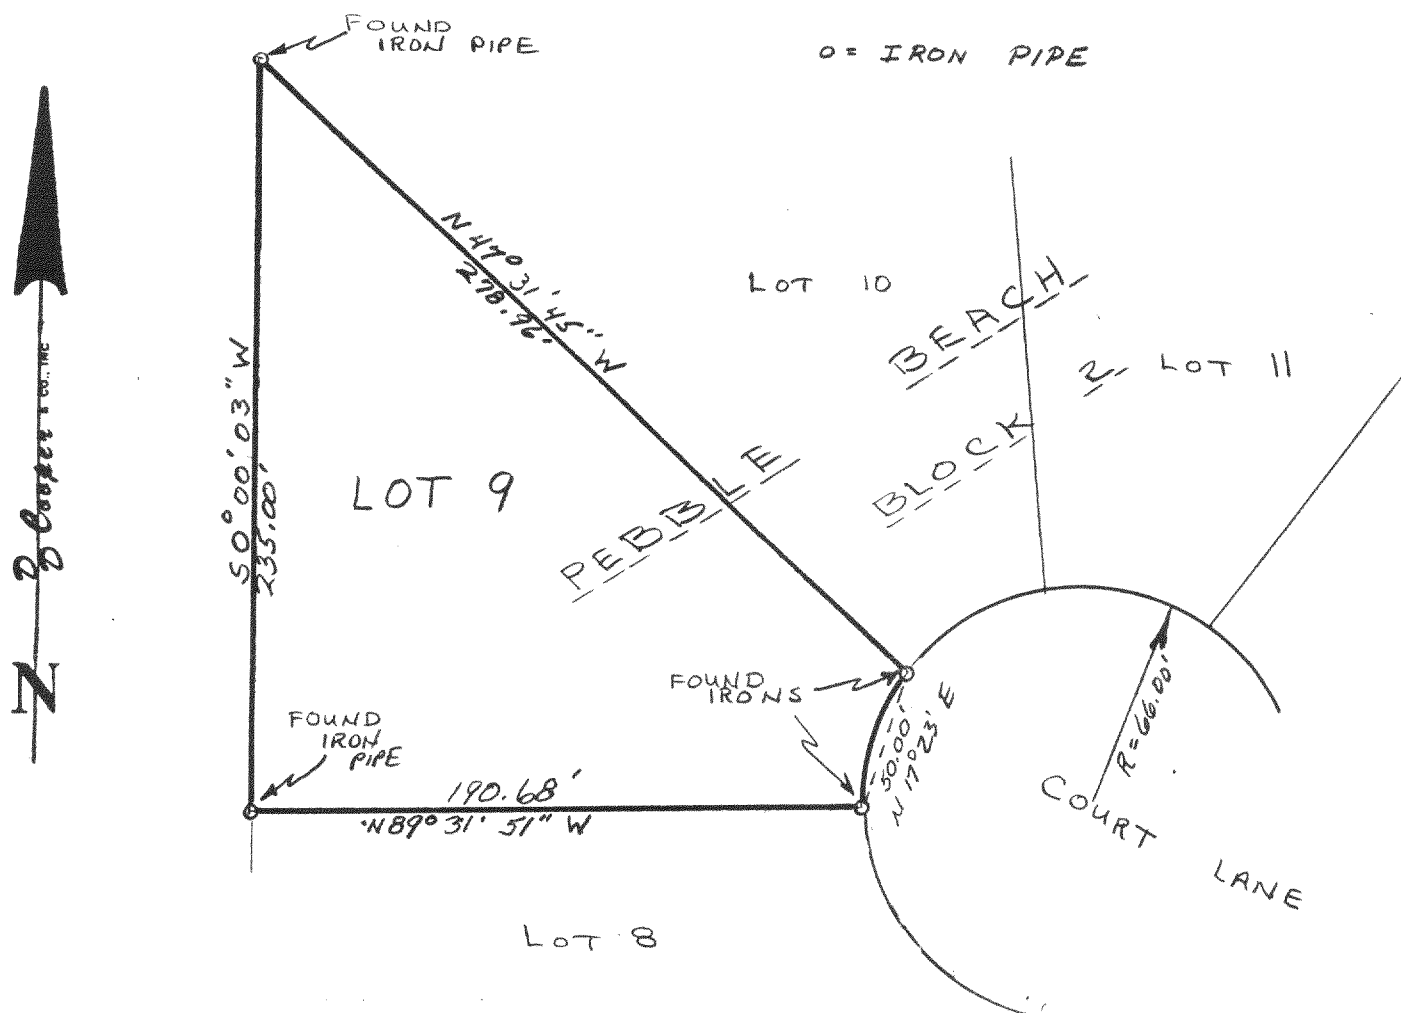

Bearing Reference: Westerly most property line assumed to bear S00°00'03" W.

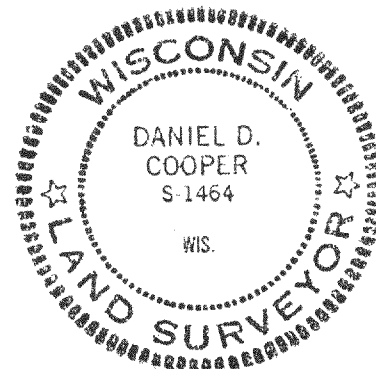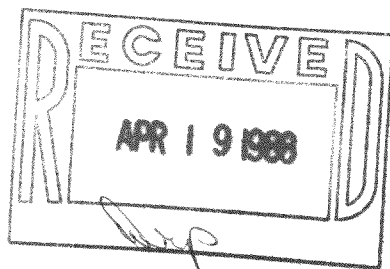

Dated this 10 day of Mar., 1988

Daniel D. Cooper
Daniel D. Cooper, RLS No. S-1464

DRAWING NO.

416-492