


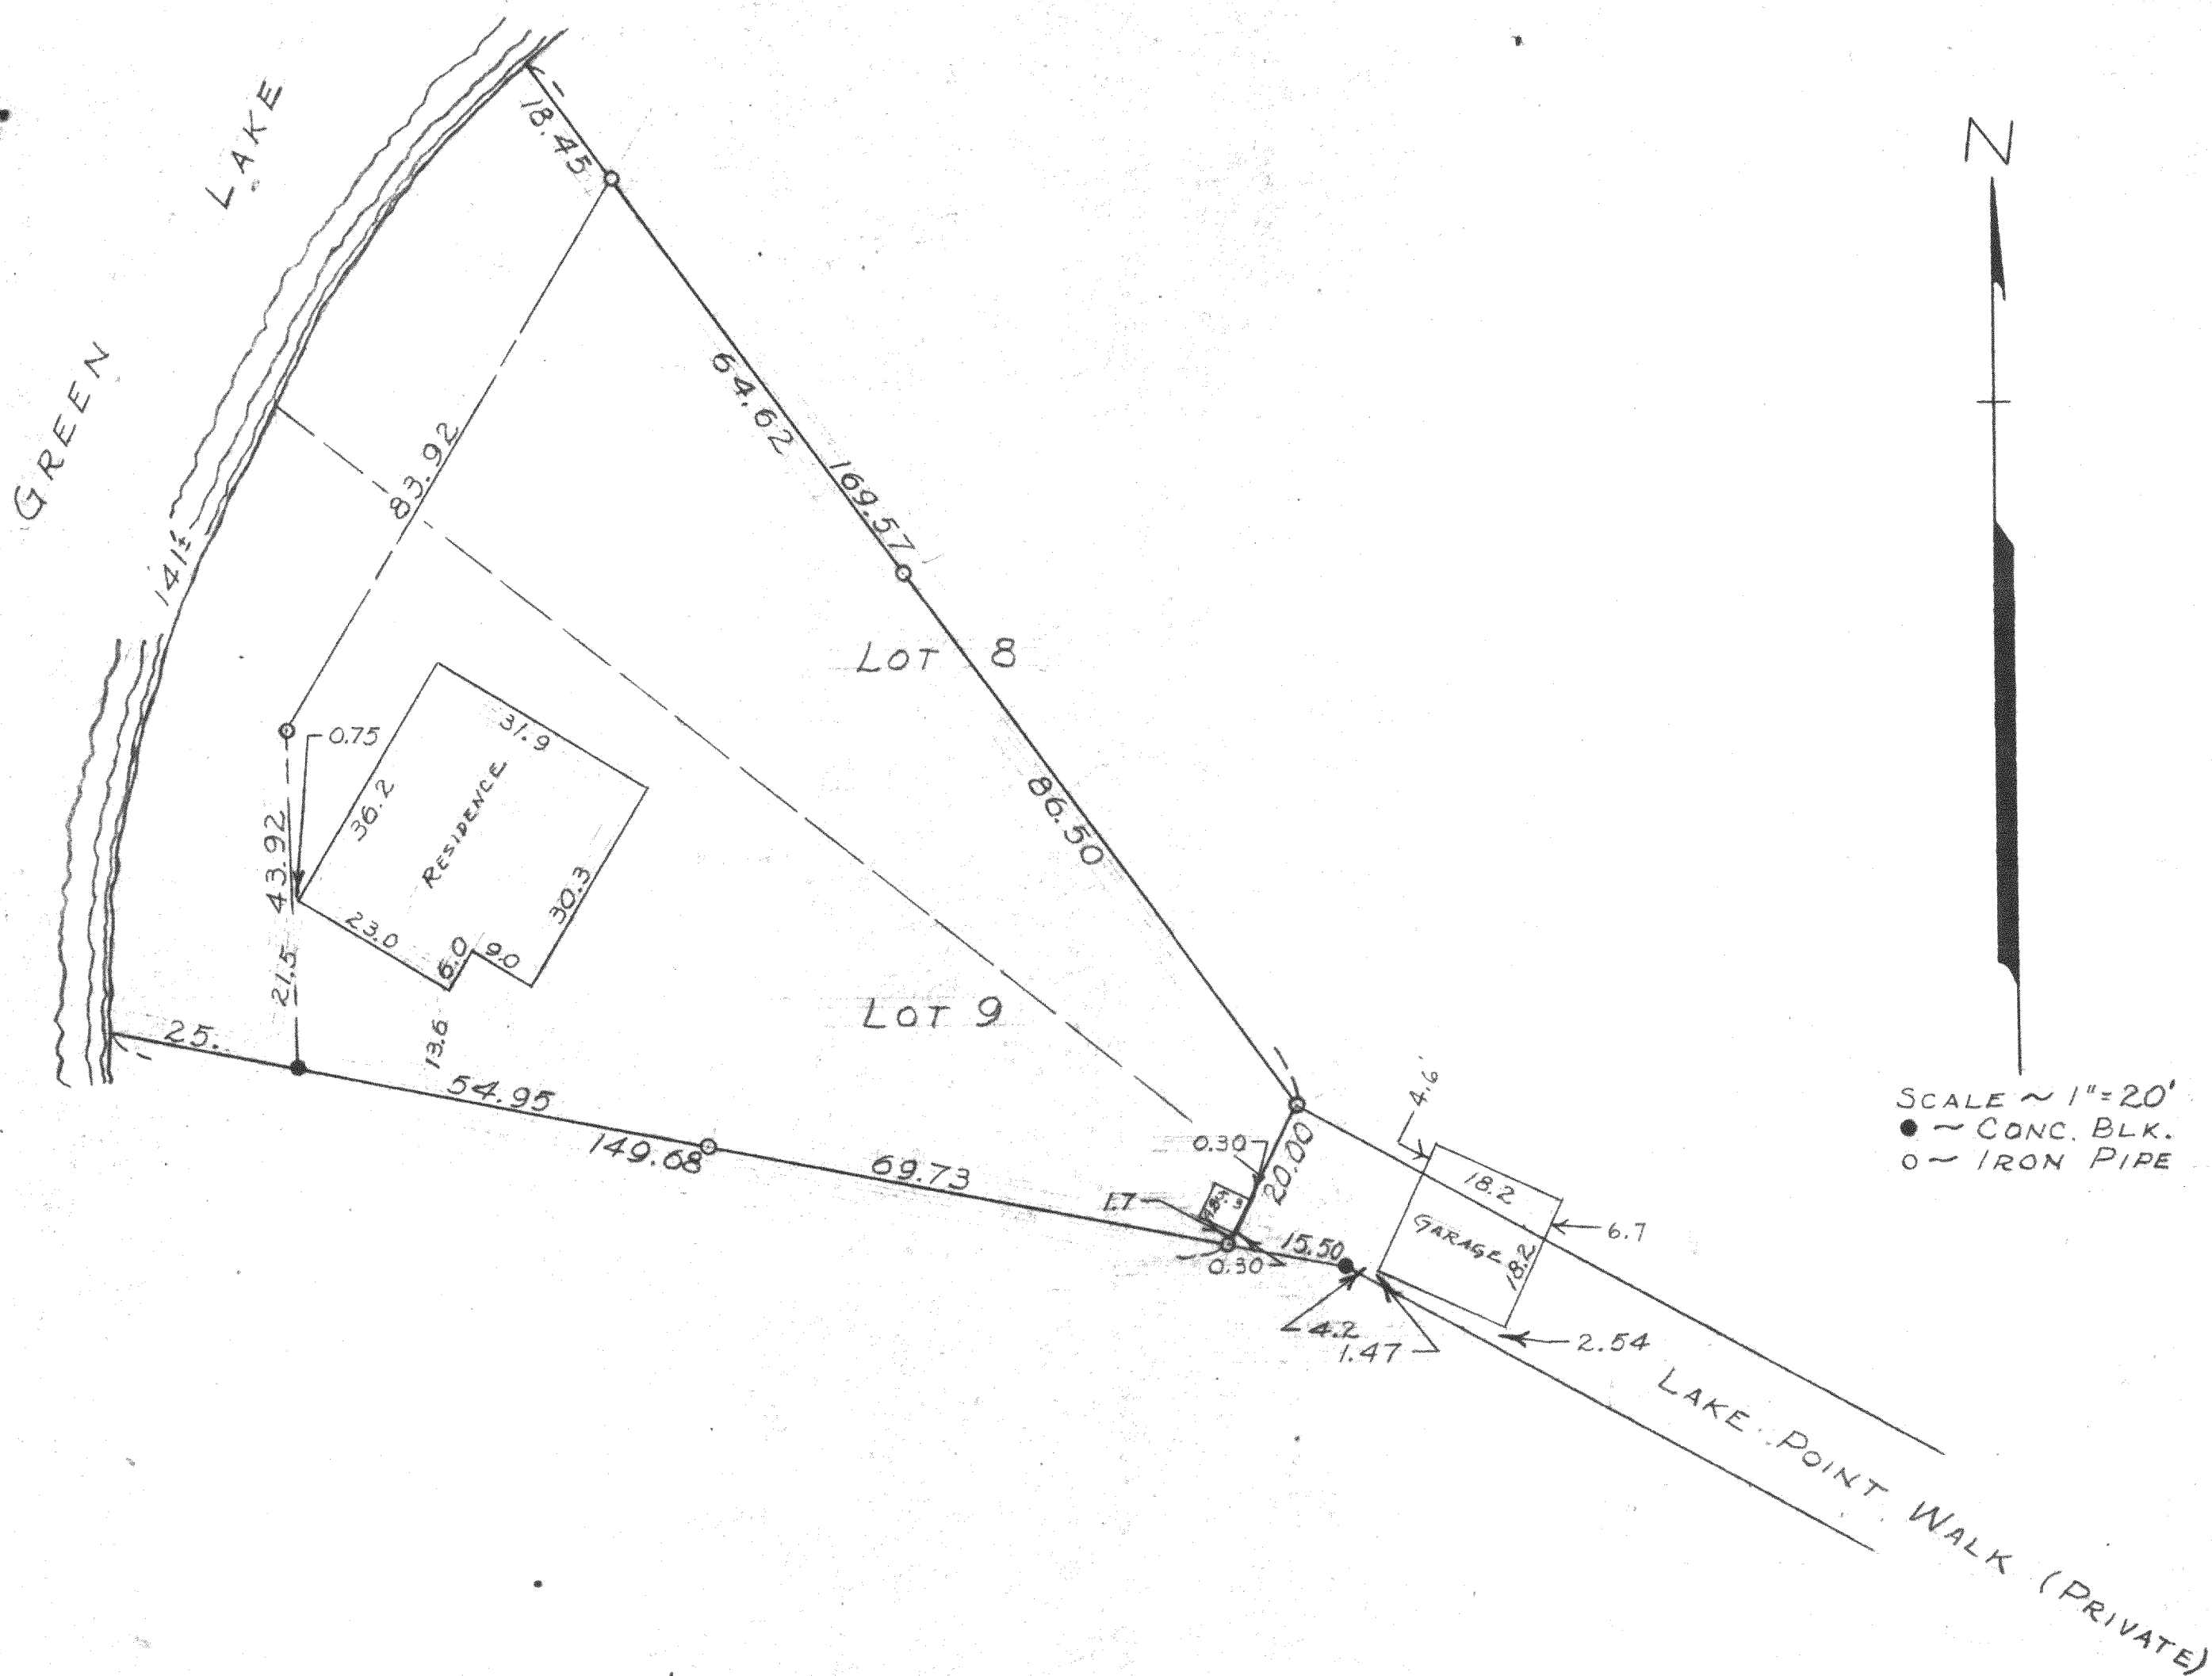

PLAT OF SURVEY OF LOT 9 AND PART OF LOT 8, SOLID COMFORT,
A SUBDIVISION LOCATED IN THE SOUTHEAST 1/4 OF SECTION 26, T4NR16E,
WALWORTH COUNTY, WISCONSIN.
JULY 13, 1957

George T. Dunham
GEORGE T. DUNHAM, SURVEYOR
DELAVER, WISCONSIN