



**ABELL**  
**SURVEYING & MAPPING**  
 DELAVAN, WISCONSIN 53115  
 414-728-6737

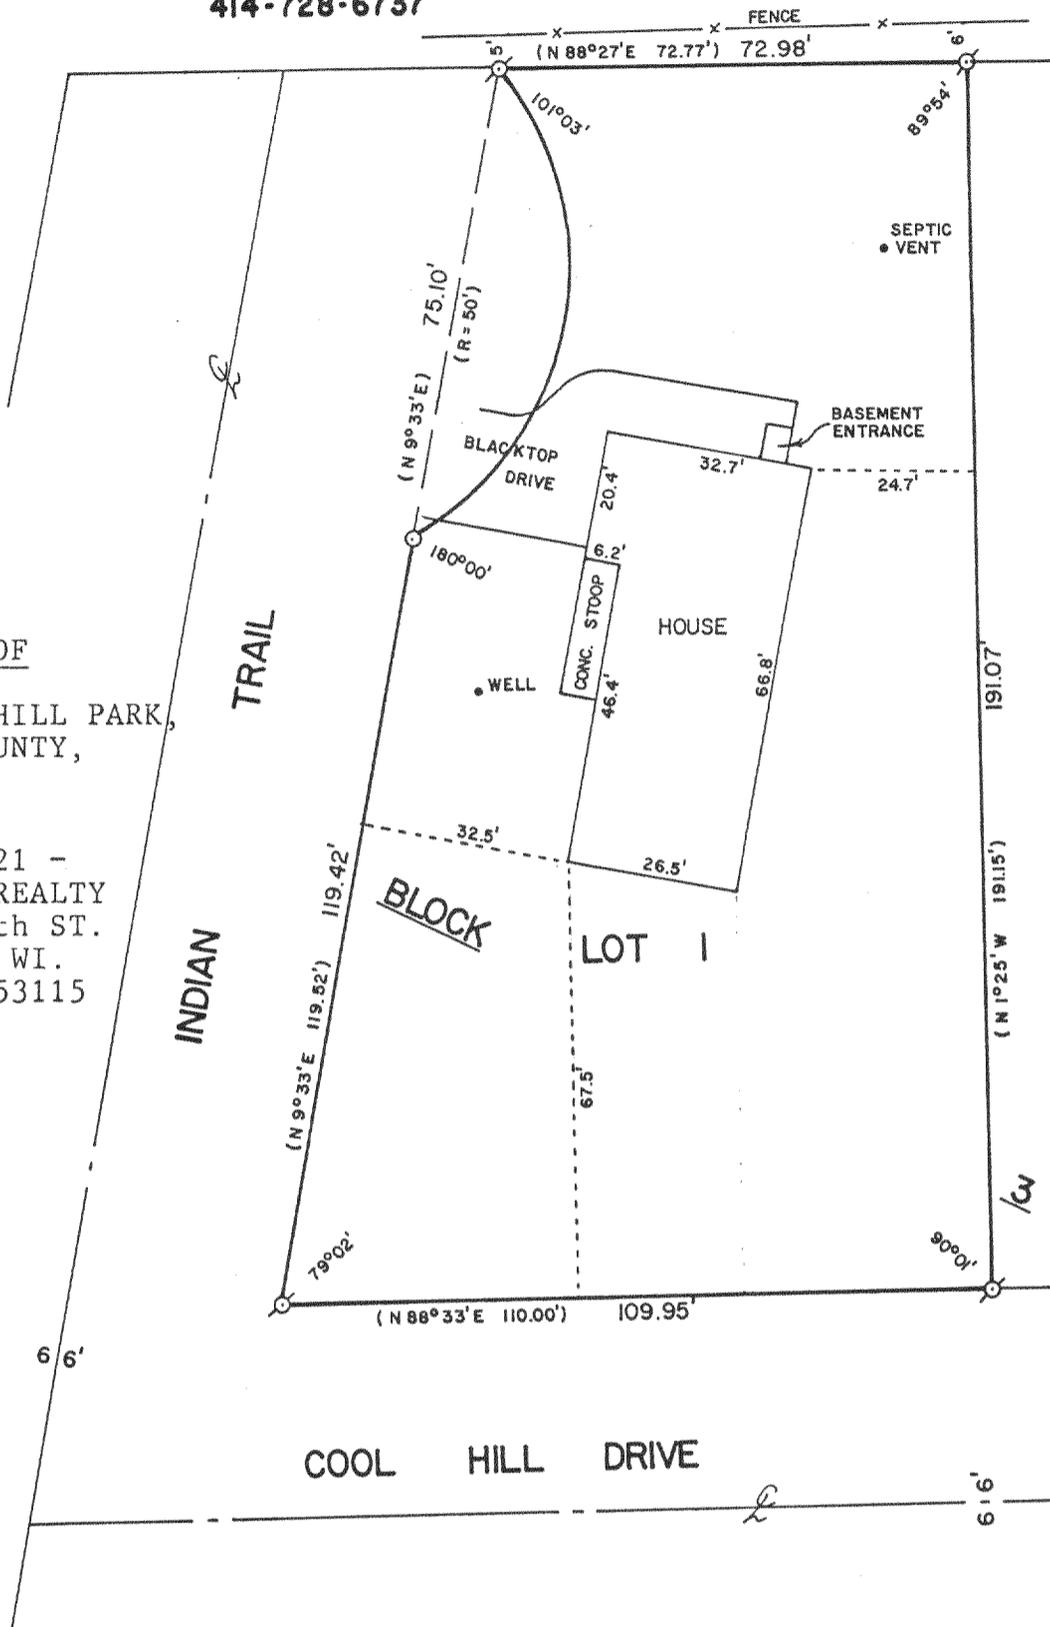

PLAT OF SURVEY OF

LOT 1, BLOCK 3, COOL HILL PARK,  
 T4N, R16E, WALWORTH COUNTY,  
 WISCONSIN.

ORDERED BY: CENTURY 21 -  
 SKANDIA REALTY  
 312 S. 7th ST.  
 DELAVAN, WI.  
 53115

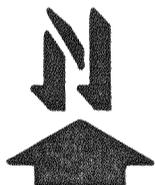

SCALE - 1"=30'

LEGEND

- ⊗ - IRON PIPE FOUND
- - IRON ROD SET
- ( ) - RECORDED AS

I, DAVID F. ABELL, DO HEREBY CERTIFY THAT I HAVE SURVEYED THE PROPERTY HEREON DESCRIBED ACCORDING TO THE OFFICIAL RECORDS AND THAT THE PLAT HEREON IS A CORRECT REPRESENTATION OF THE PROPERTY LINES TO THE BEST OF MY KNOWLEDGE AND BELIEF.

*David F. Abell*

DAVID F. ABELL  
 WISCONSIN REGISTERED LAND SURVEYOR, S-1596

*March 15, 1988*

DATE JOB NUMBER - 88025

NOTE: THIS IS NOT A CERTIFIED COPY UNLESS SEALED.