


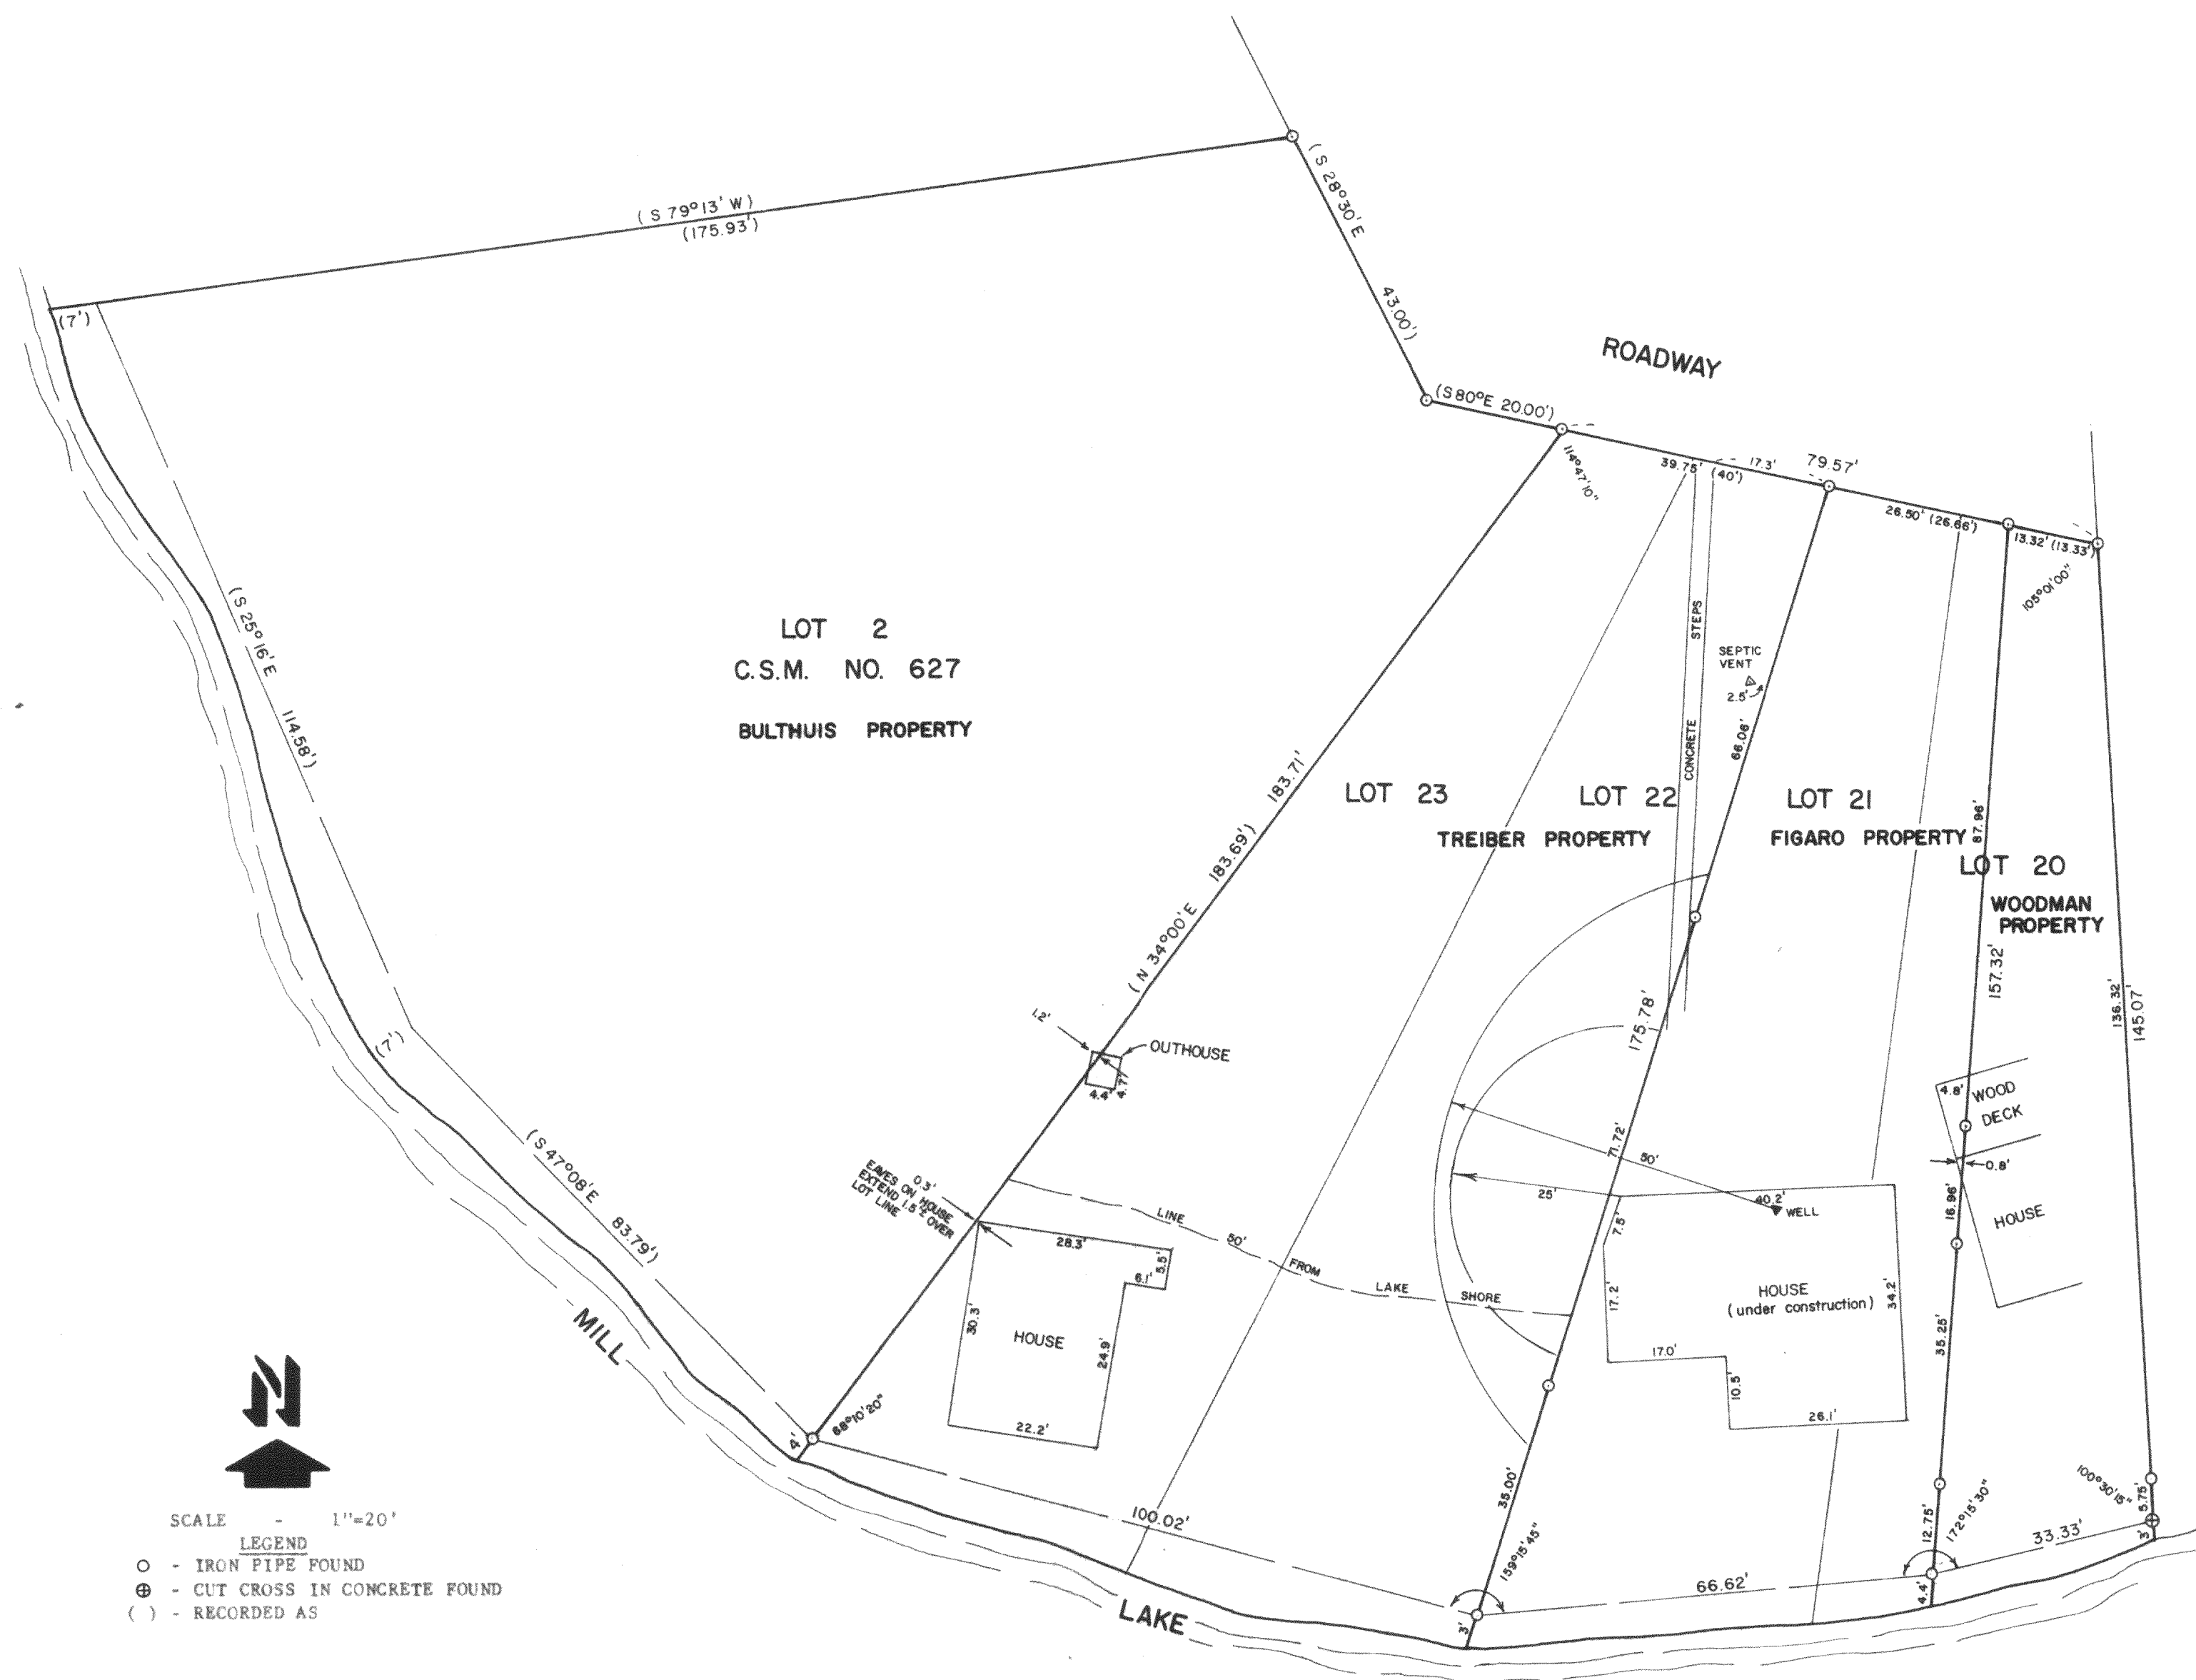

SCALE - 1"=20'



- LEGEND
- - IRON PIPE FOUND
 - ⊕ - CUT CROSS IN CONCRETE FOUND
 - () - RECORDED AS

PREPARED BY: ABELL SURVEYING & MAPPING
1140 SEQUOIA STREET
DELAVER, WI. 53115
414-728-6737

PLAT OF SURVEY OF

LOTS 20-23, BLOCK 3, CARSWELL'S PARK, TOWN 4 NORTH, RANGE
16 EAST, WALWORTH COUNTY, WISCONSIN.

ORDERED BY: GODFREY, PFEIL & NESHEK, S.C.
P.O. BOX 291
ELKHORN, WI. 53121

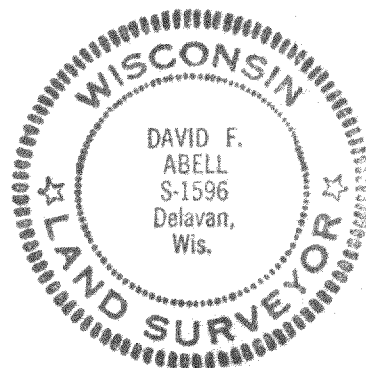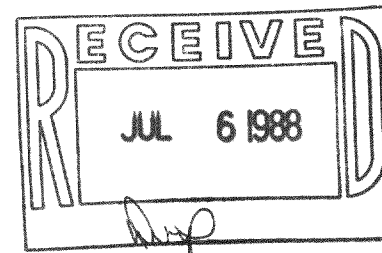

I, DAVID F. ABELL, DO HEREBY CERTIFY THAT I HAVE SURVEYED THE PROPERTY
HEREON DESCRIBED ACCORDING TO THE OFFICIAL RECORDS AND THAT THE PLAT
HEREON IS A CORRECT REPRESENTATION OF THE PROPERTY LINES TO THE BEST
OF MY KNOWLEDGE AND BELIEF.

David F. Abell

DAVID F. ABELL
WISCONSIN REGISTERED LAND SURVEYOR, S-1596

DATE *May 6, 1988*

JOB NUMBER - 87036