


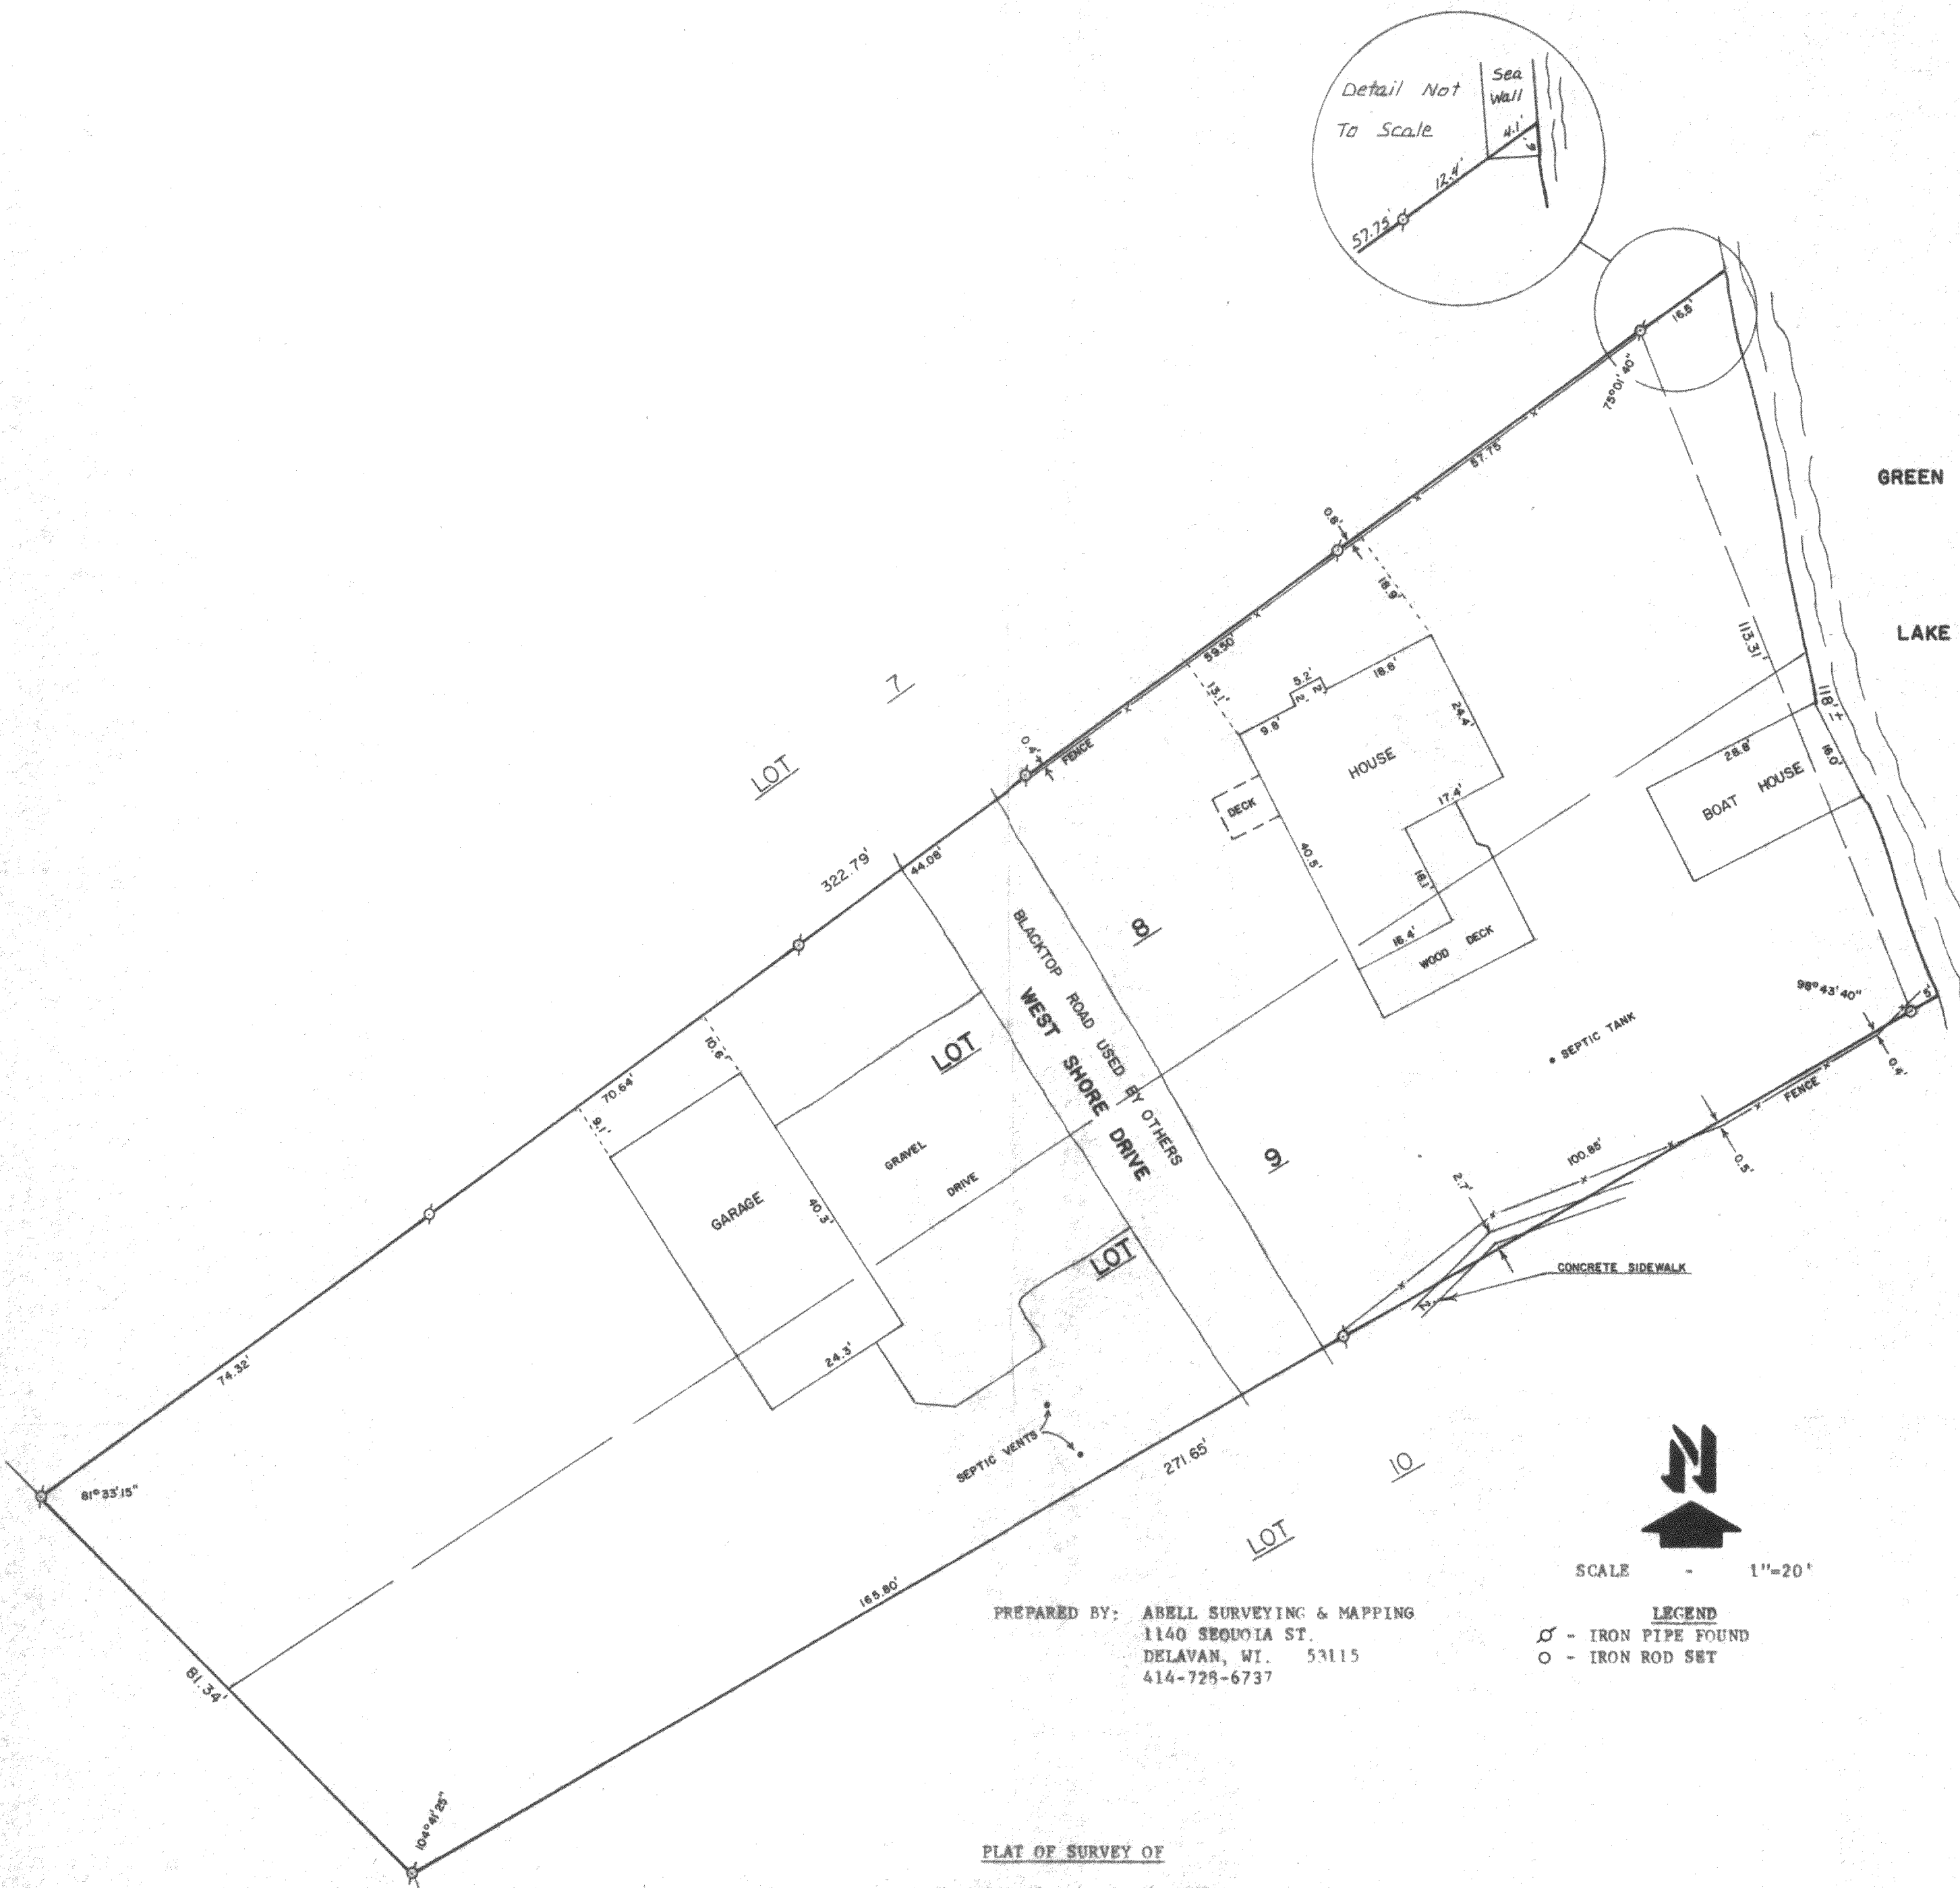


PREPARED BY: ABELL SURVEYING & MAPPING
1140 SEQUOIA ST.
DELAVER, WI. 53115
414-728-6737

PLAT OF SURVEY OF

LOTS 8 AND 9 IN WHAT IS KNOWN AS LONG POINT SITUATED ON LOT 7 OR THE EAST 1/2 OF THE SOUTHEAST FRACTIONAL 1/4 OF SECTION 26, T4N, R16E, ACCORDING TO A PLAT OF SAID LONG POINT ON RECORD IN THE OFFICE OF THE REGISTER OF DEEDS IN AND FOR WALWORTH COUNTY, WISCONSIN IN VOLUME 5 OF PLATS ON PAGE 66.

ORDERED BY: ERA LANHAM REALTY
20 S. WASHINGTON ST.
ELKHORN, WI. 53121

OWNER: FREDRICK FOERSTERLING

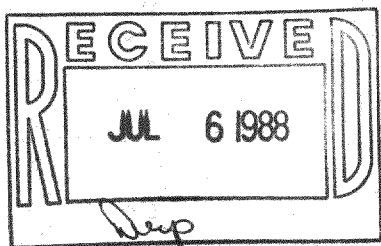

I, DAVID F. ABELL, DO HEREBY CERTIFY THAT I HAVE SURVEYED THE PROPERTY HEREON DESCRIBED ACCORDING TO THE OFFICIAL RECORDS AND THAT THE PLAT HEREON IS A CORRECT REPRESENTATION OF THE PROPERTY LINES TO THE BEST OF MY KNOWLEDGE AND BELIEF.

David F. Abell
DAVID F. ABELL
WISCONSIN REGISTERED LAND SURVEYOR, S-1596

March 25, 1988
DATE JOB NUMBER - 88032
NOTE: THIS IS NOT A CERTIFIED COPY UNLESS SEALED.