



**ABELL
SURVEYING & MAPPING
DELAVAN, WISCONSIN 53115
414-728-6737**

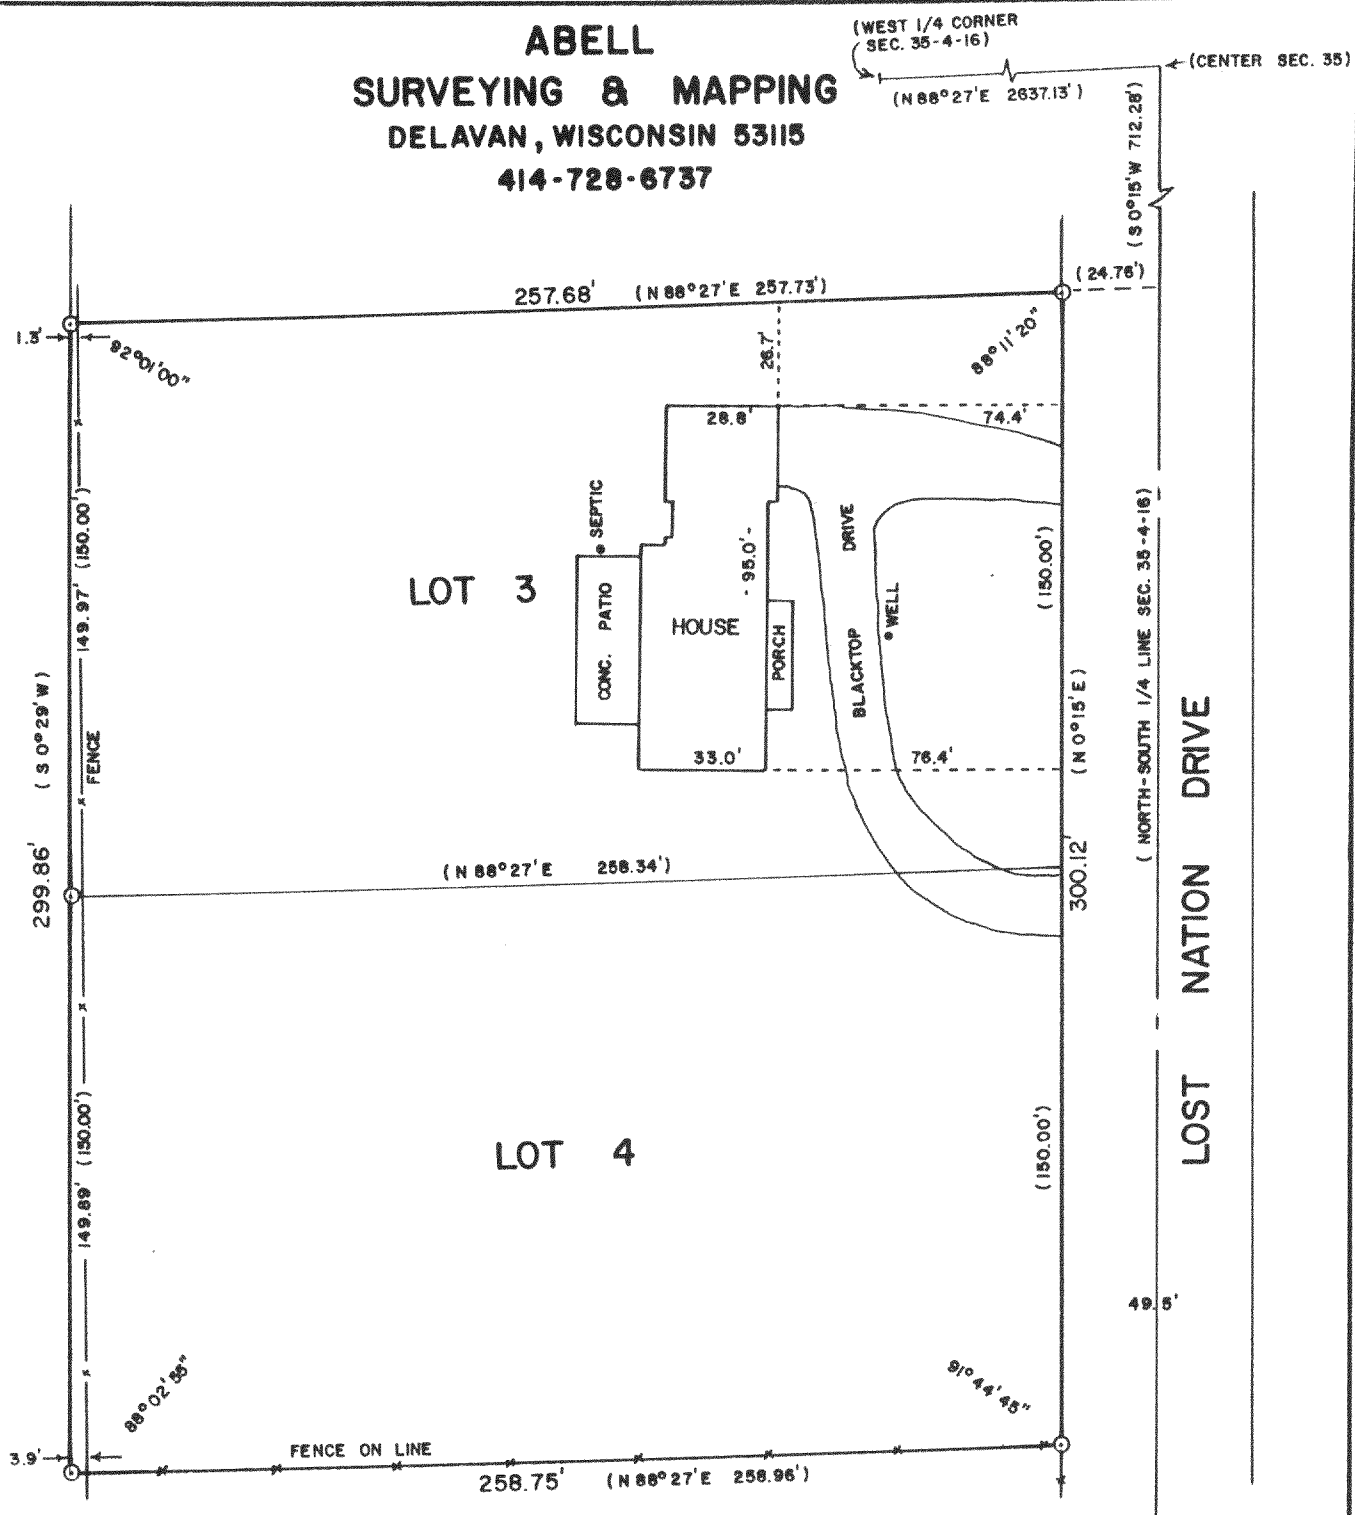


PLAT OF SURVEY OF

LOTS 3 AND 4 OF CERTIFIED SURVEY MAP NO. 36, ACCORDING
TO THE PLAT THEREOF RECORDED MAY 19, 1970 IN VOLUME 1
OF CERTIFIED SURVEYS ON PAGE 36 AS DOCUMENT NO. 624076.

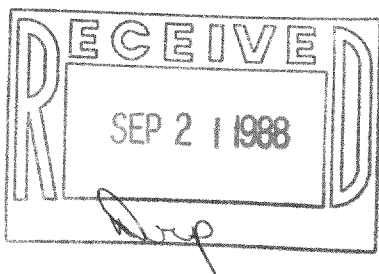

ORDERED BY: ANCHOR SAVINGS
201 BROAD ST.
LAKE GENEVA, WI. 53147

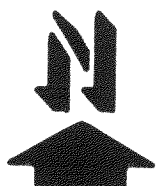

SCALE - 1"=50'

LEGEND

○ - IRON ROD FOUND
() - RECORDED AS

I, DAVID F. ABELL, DO HEREBY CERTIFY
THAT I HAVE SURVEYED THE PROPERTY
HEREON DESCRIBED ACCORDING TO THE
OFFICIAL RECORDS AND THAT THE PLAT
HEREON IS A CORRECT REPRESENTATION
OF THE PROPERTY LINES TO THE BEST OF
MY KNOWLEDGE AND BELIEF.

David F. Abell
DAVID F. ABELL
WISCONSIN REGISTERED LAND SURVEYOR, S-1596

DATE *July 28, 1988* JOB NUMBER - 88159
NOTE: THIS IS NOT A CERTIFIED COPY UNLESS SEALED.