


PROJ # 3057

Farris, Hansen & Associates, Inc.

7 RIDGEWAY COURT, P.O. BOX 487, ELKHORN, WISCONSIN TEL. 414-723-2098

NOTE: COPIES OF THIS MAP TO WHICH THE FOLLOWING CERTIFICATE WILL APPLY ARE BLUE LINE PRINTS SHOWING SURVEYOR'S SEAL AND SIGNATURE IN BLACK INK. COPIES BY ANY OTHER MEANS MAY HAVE ALTERATIONS WHICH DO NOT REPRESENT THE SURVEYOR'S WORK PRODUCT.

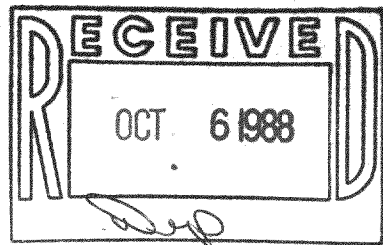

SOUTH LINE OF LOT 9 ASSUMED TO BEAR $N 89^{\circ} 31' 51'' W$ AS SHOWN ON ORIG. SUBDIVISION PLAT AS THE BASIS FOR ALL BEARINGS IN THIS PLAT

MAP SCALE IN FEET



- XXX = COMPUTER COORDINATE FILE NO.
- = IRON PIPE STAKE FOUND & BELIEVED TO BE ORIG. PLAT COR.
- = POINT ON EXTERIOR OF NEW CONCRETE WORK
- (XXX) = RECORD DIMENSION SHOWN ON ORIG. SUBDIVISION PLAT
- XXX = DIMENSION MEASURED OR CALC. FROM MEAS. MADE FOR THE SURVEY

LOT 10

I hereby certify this plat of survey to be a true and accurate representation of the location of a new concrete foundation on Lot 9 of Block 2 of Peoble Beach Subdivision in the Town of Lagrange, Walworth County, Wisconsin to the best of my professional knowledge and belief.

Work Ordered by: Thelen Construction for Bob & Carol Tortorello

PROJ # 3057
JULY 13, 1988

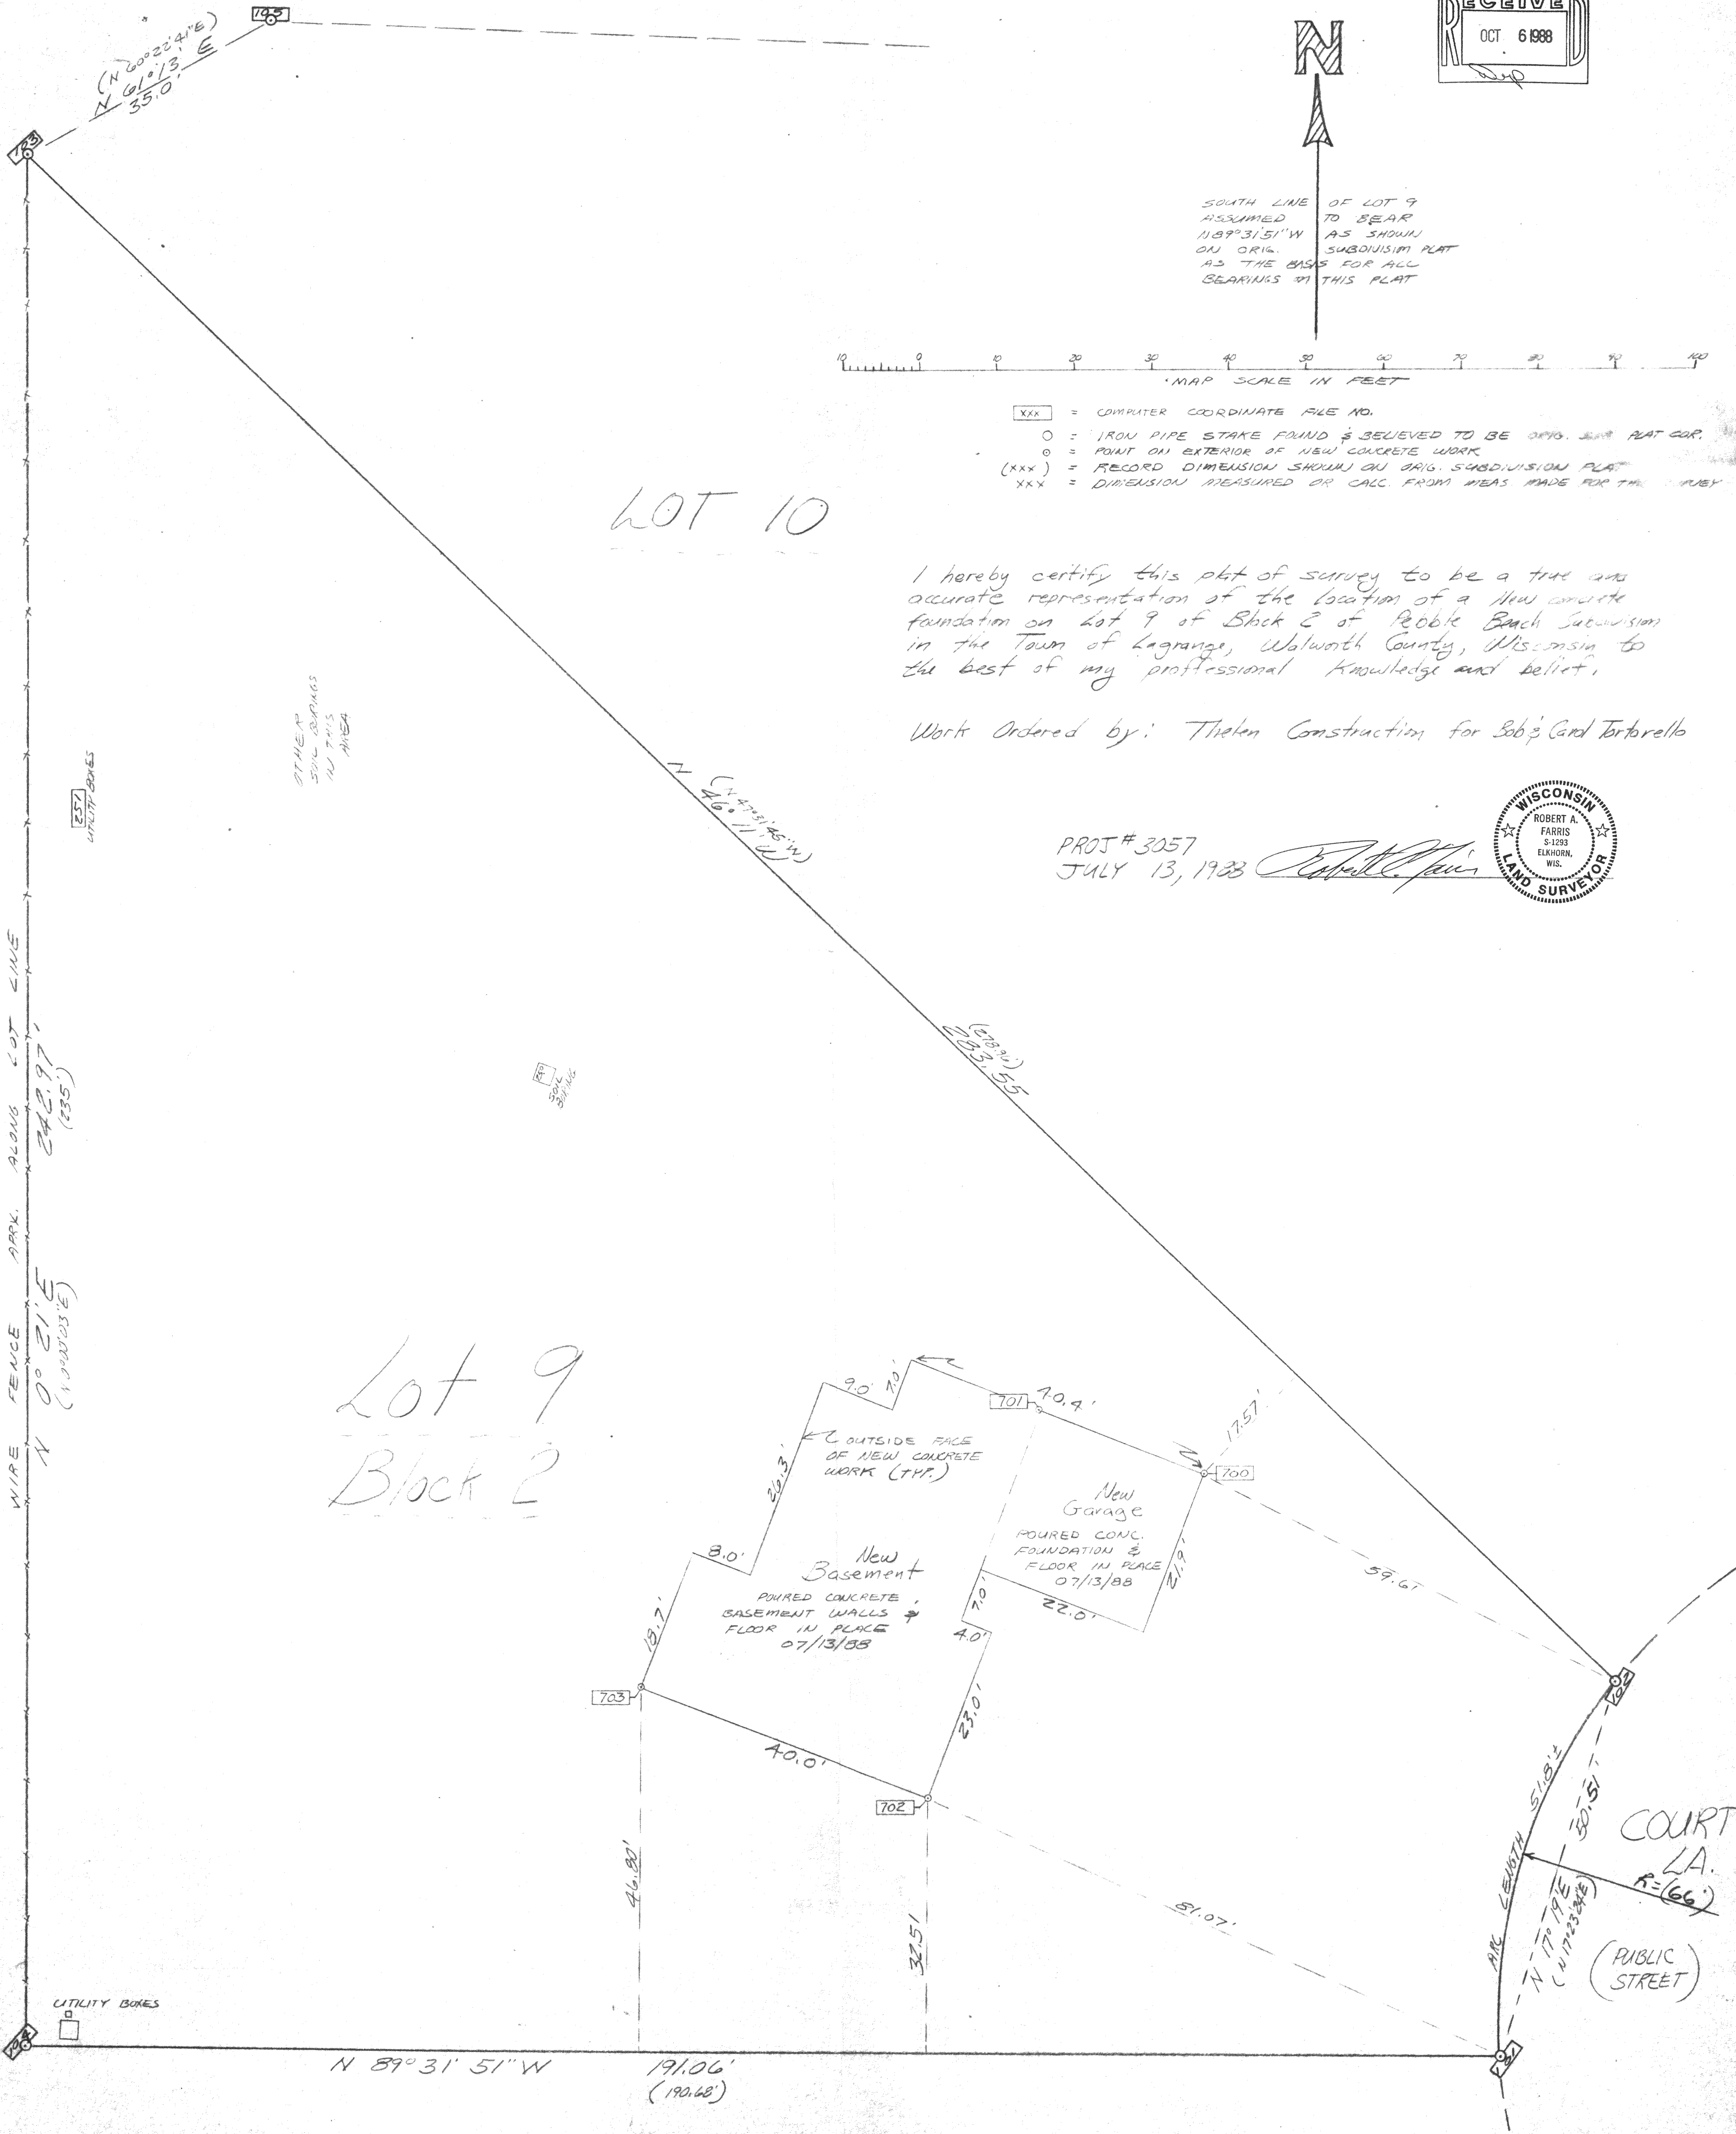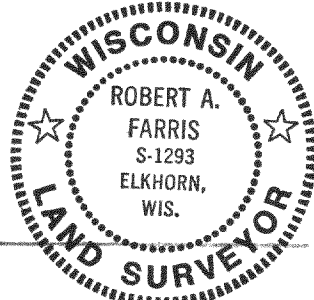

LOT 8