


PLAT OF SURVEY LOTS 10 & 11 OF DUNBAR ESTATES SUBDIVISION
IN SE 1/4 SEC. 36, T. 4N., R. 16E.
WALWORTH CO., WI.

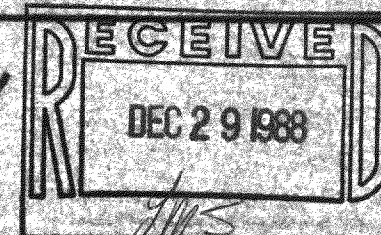

MAP SCALE IN FEET

DUNBAR DRIVE

MEADOWLARK DRIVE

NORTH AS SHOWN
ON ORIG. PLAT OF
DUNBAR ESTATES
● = FOUND REBAR STAKE
○ = SET REBAR STAKE
(XXV) = ORIG. PLAT DIMENSION
[XXV] = SURVEYOR'S STAKE LABEL

FARRIS, HANSEN & ASSOCIATES, INC.
Engineers Architects Surveyors
7 Ridgeway Court P.O. Box 437
ELKHORN, WISCONSIN 53121
Office: (414) 723-2098


LOT 11

TAX KEY HDS 00011
SURVEY OF LOT 11 ORDERED BY
LANHAM REALTY FOR JAY & SUSAN MARITZ
FH&A PROJECT # 3138

LOT 10

TAX KEY HDS 00010
SURVEY OF LOT 10 ORDERED BY
LANHAM REALTY FOR DANIEL & LANEITE MAURINA
FH&A PROJECT # 3139

I hereby certify that I have surveyed the above described property and that the above map is a true representation thereof and show the size and location of the property, its exterior boundaries, the location of all visible structures and dimensions of all principal buildings thereon, boundary fences, apparent easements, roadways and visible encroachments, if any.
This survey is made for the use of the present owners of the property, and also those who purchase, mortgage, or guarantee the title thereto within one (1) year from the date hereof.

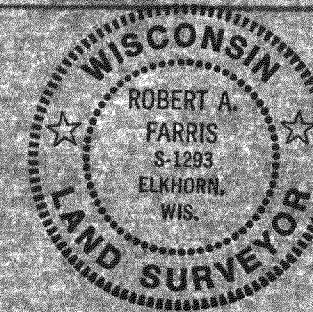

NOTE: COPIES OF THIS MAP TO WHICH THE FOLLOWING CERTIFICATE SHALL APPLY ARE BLUE LINE PRINTS WITH THE SURVEYOR'S ORIGINAL SEAL AND SIGNATURE APPEARING IN BLACK INK. COPIES BY ANY OTHER MEANS MAY CONTAIN ALTERATIONS WHICH DO NOT REPRESENT THE SURVEYOR'S WORK PRODUCT.

Robert A. Farris 12/23/88

PROJECTS 3138
3139

HDS-10711

416-540