

**ABELL
SURVEYING & MAPPING
DELAVER, WISCONSIN 53115
414-728-6737**



MIDDLE LAKE

PLAT OF SURVEY OF

LOT 2 OF CERTIFIED SURVEY MAP NO. 847,
LOCATED IN THE NORTHEAST 1/4 AND THE
NORTHWEST 1/4 OF SECTION 35, T4N, R16E,
WALWORTH COUNTY, WISCONSIN.

OWNER: DENNIS & CHARLENE PETERSON

ORDERED BY: GODFREY, PFEIL
& NESHEK
P.O.B. 291
ELKHORN, WI.

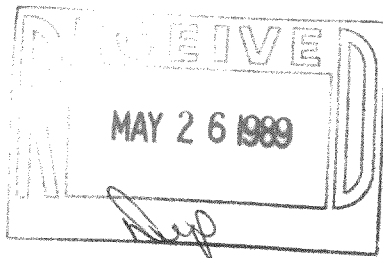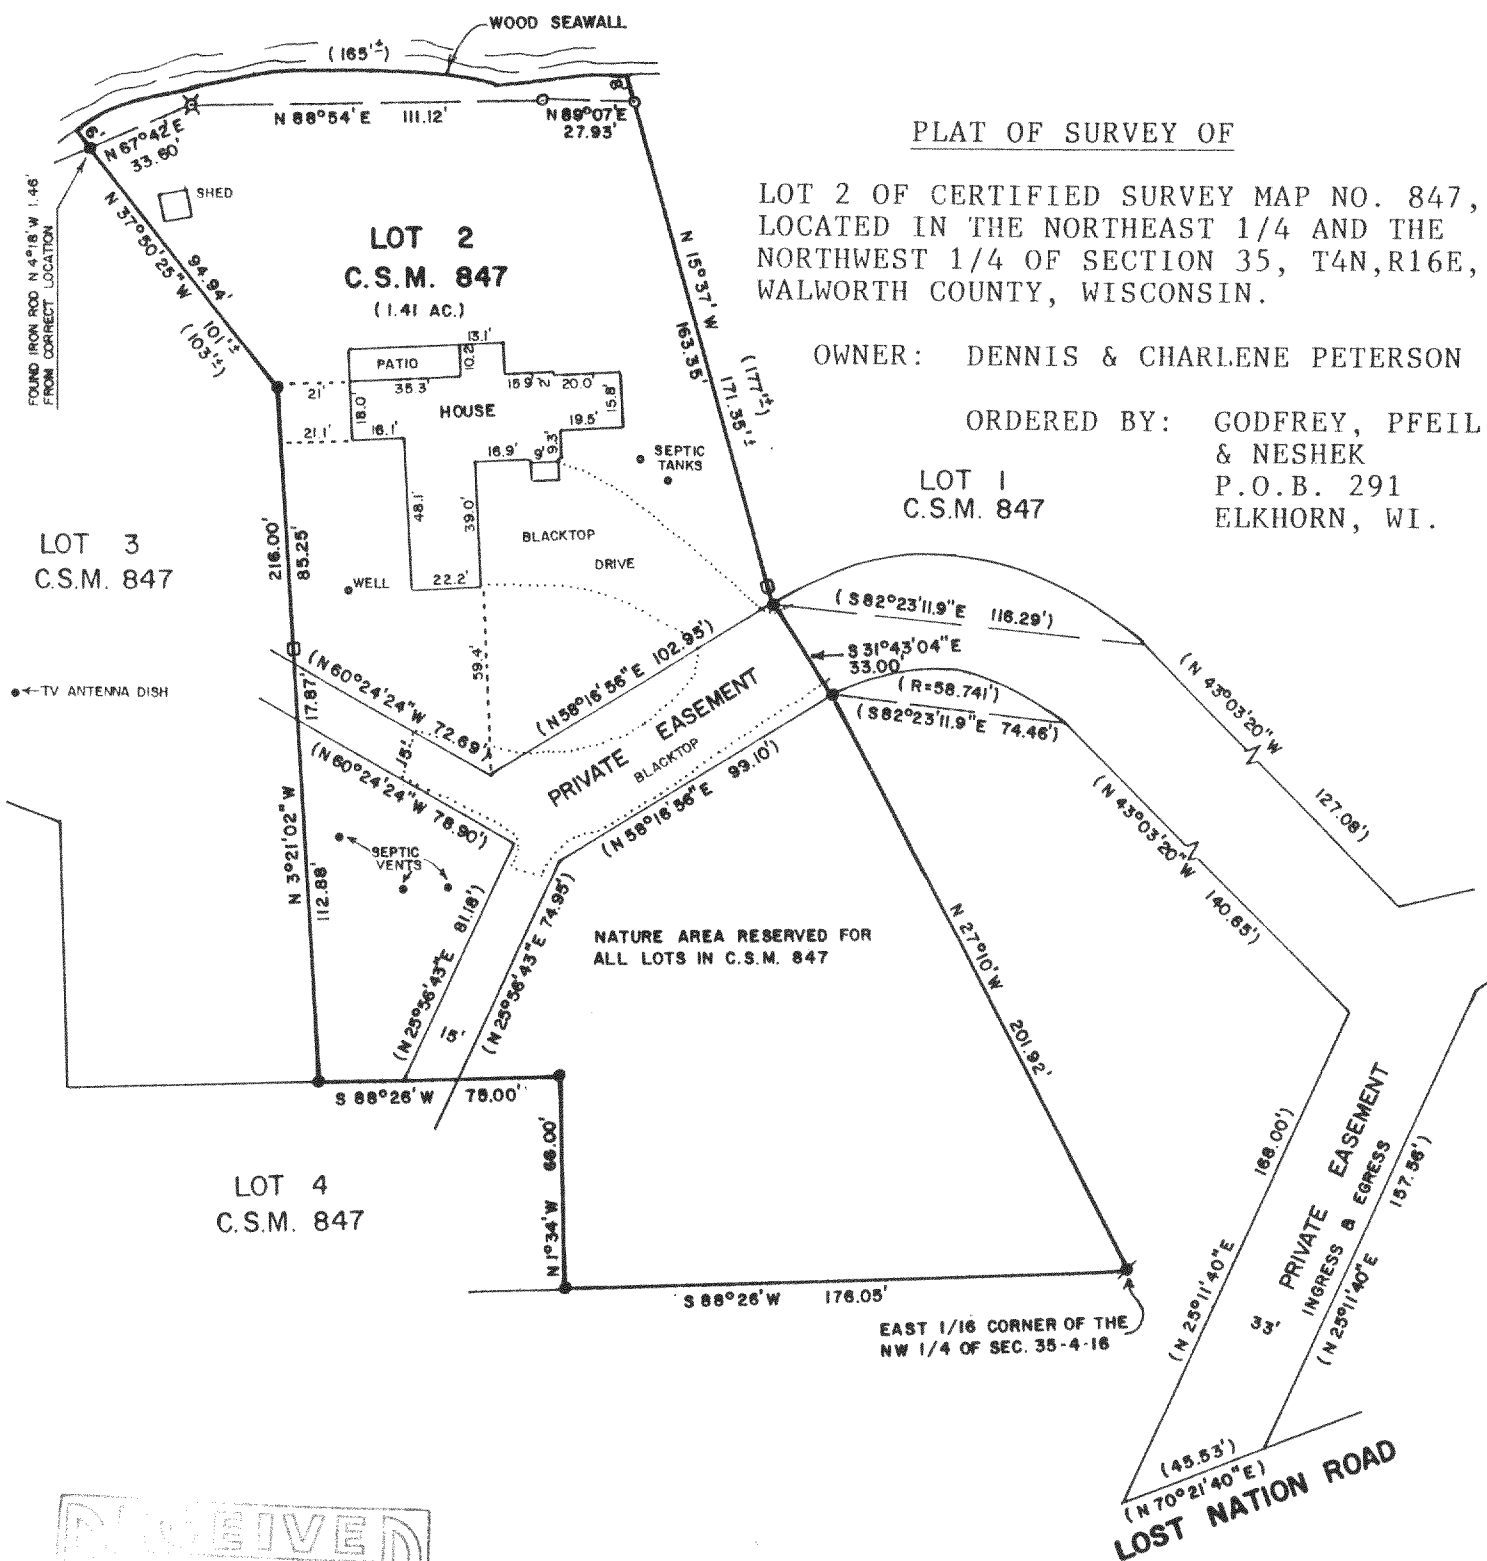

SCALE - 1"=60'

LEGEND

- - IRON ROD FOUND
- - CONCRETE MONUMENT FOUND
- - IRON PIPE SET
- ✕ - NAIL SET IN WOOD STEPS
- () - RECORDED AS
- - ELECTRIC PED.

I HEREBY CERTIFY THAT I HAVE SURVEYED THE ABOVE DESCRIBED PROPERTY AND THAT THE ABOVE MAP IS A TRUE REPRESENTATION THEREOF AND SHOWS THE SIZE AND LOCATION OF THE PROPERTY, ITS EXTERIOR BOUNDARIES, THE LOCATION OF ALL VISIBLE STRUCTURES AND DIMENSIONS OF ALL PRINCIPAL BUILDINGS THEREON, BOUNDARIES FENCES, APPARENT EASEMENTS, ROADWAYS AND VISIBLE ENCROACHMENTS, IF ANY, TO THE BEST OF MY KNOWLEDGE AND BELIEF.

THIS SURVEY IS MADE FOR THE USE OF THE PRESENT OWNERS OF THE PROPERTY, AND ALSO THOSE WHO PURCHASE, MORTGAGE, OR GUARANTEE THE TITLE THERETO WITHIN ONE (1) YEAR FROM DATE HEREOF.

David F. Abell
DAVID F. ABELL
WISCONSIN REGISTERED LAND SURVEYOR, S-1596

December 23, 1988
DATE JOB NUMBER - 88281
NOTE: THIS IS NOT A CERTIFIED COPY UNLESS SEALED.