


DUNHAM SURVEYING, S.C.
SURVEYING & SUBDIVIDING
DELAVER, WISCONSIN 53115

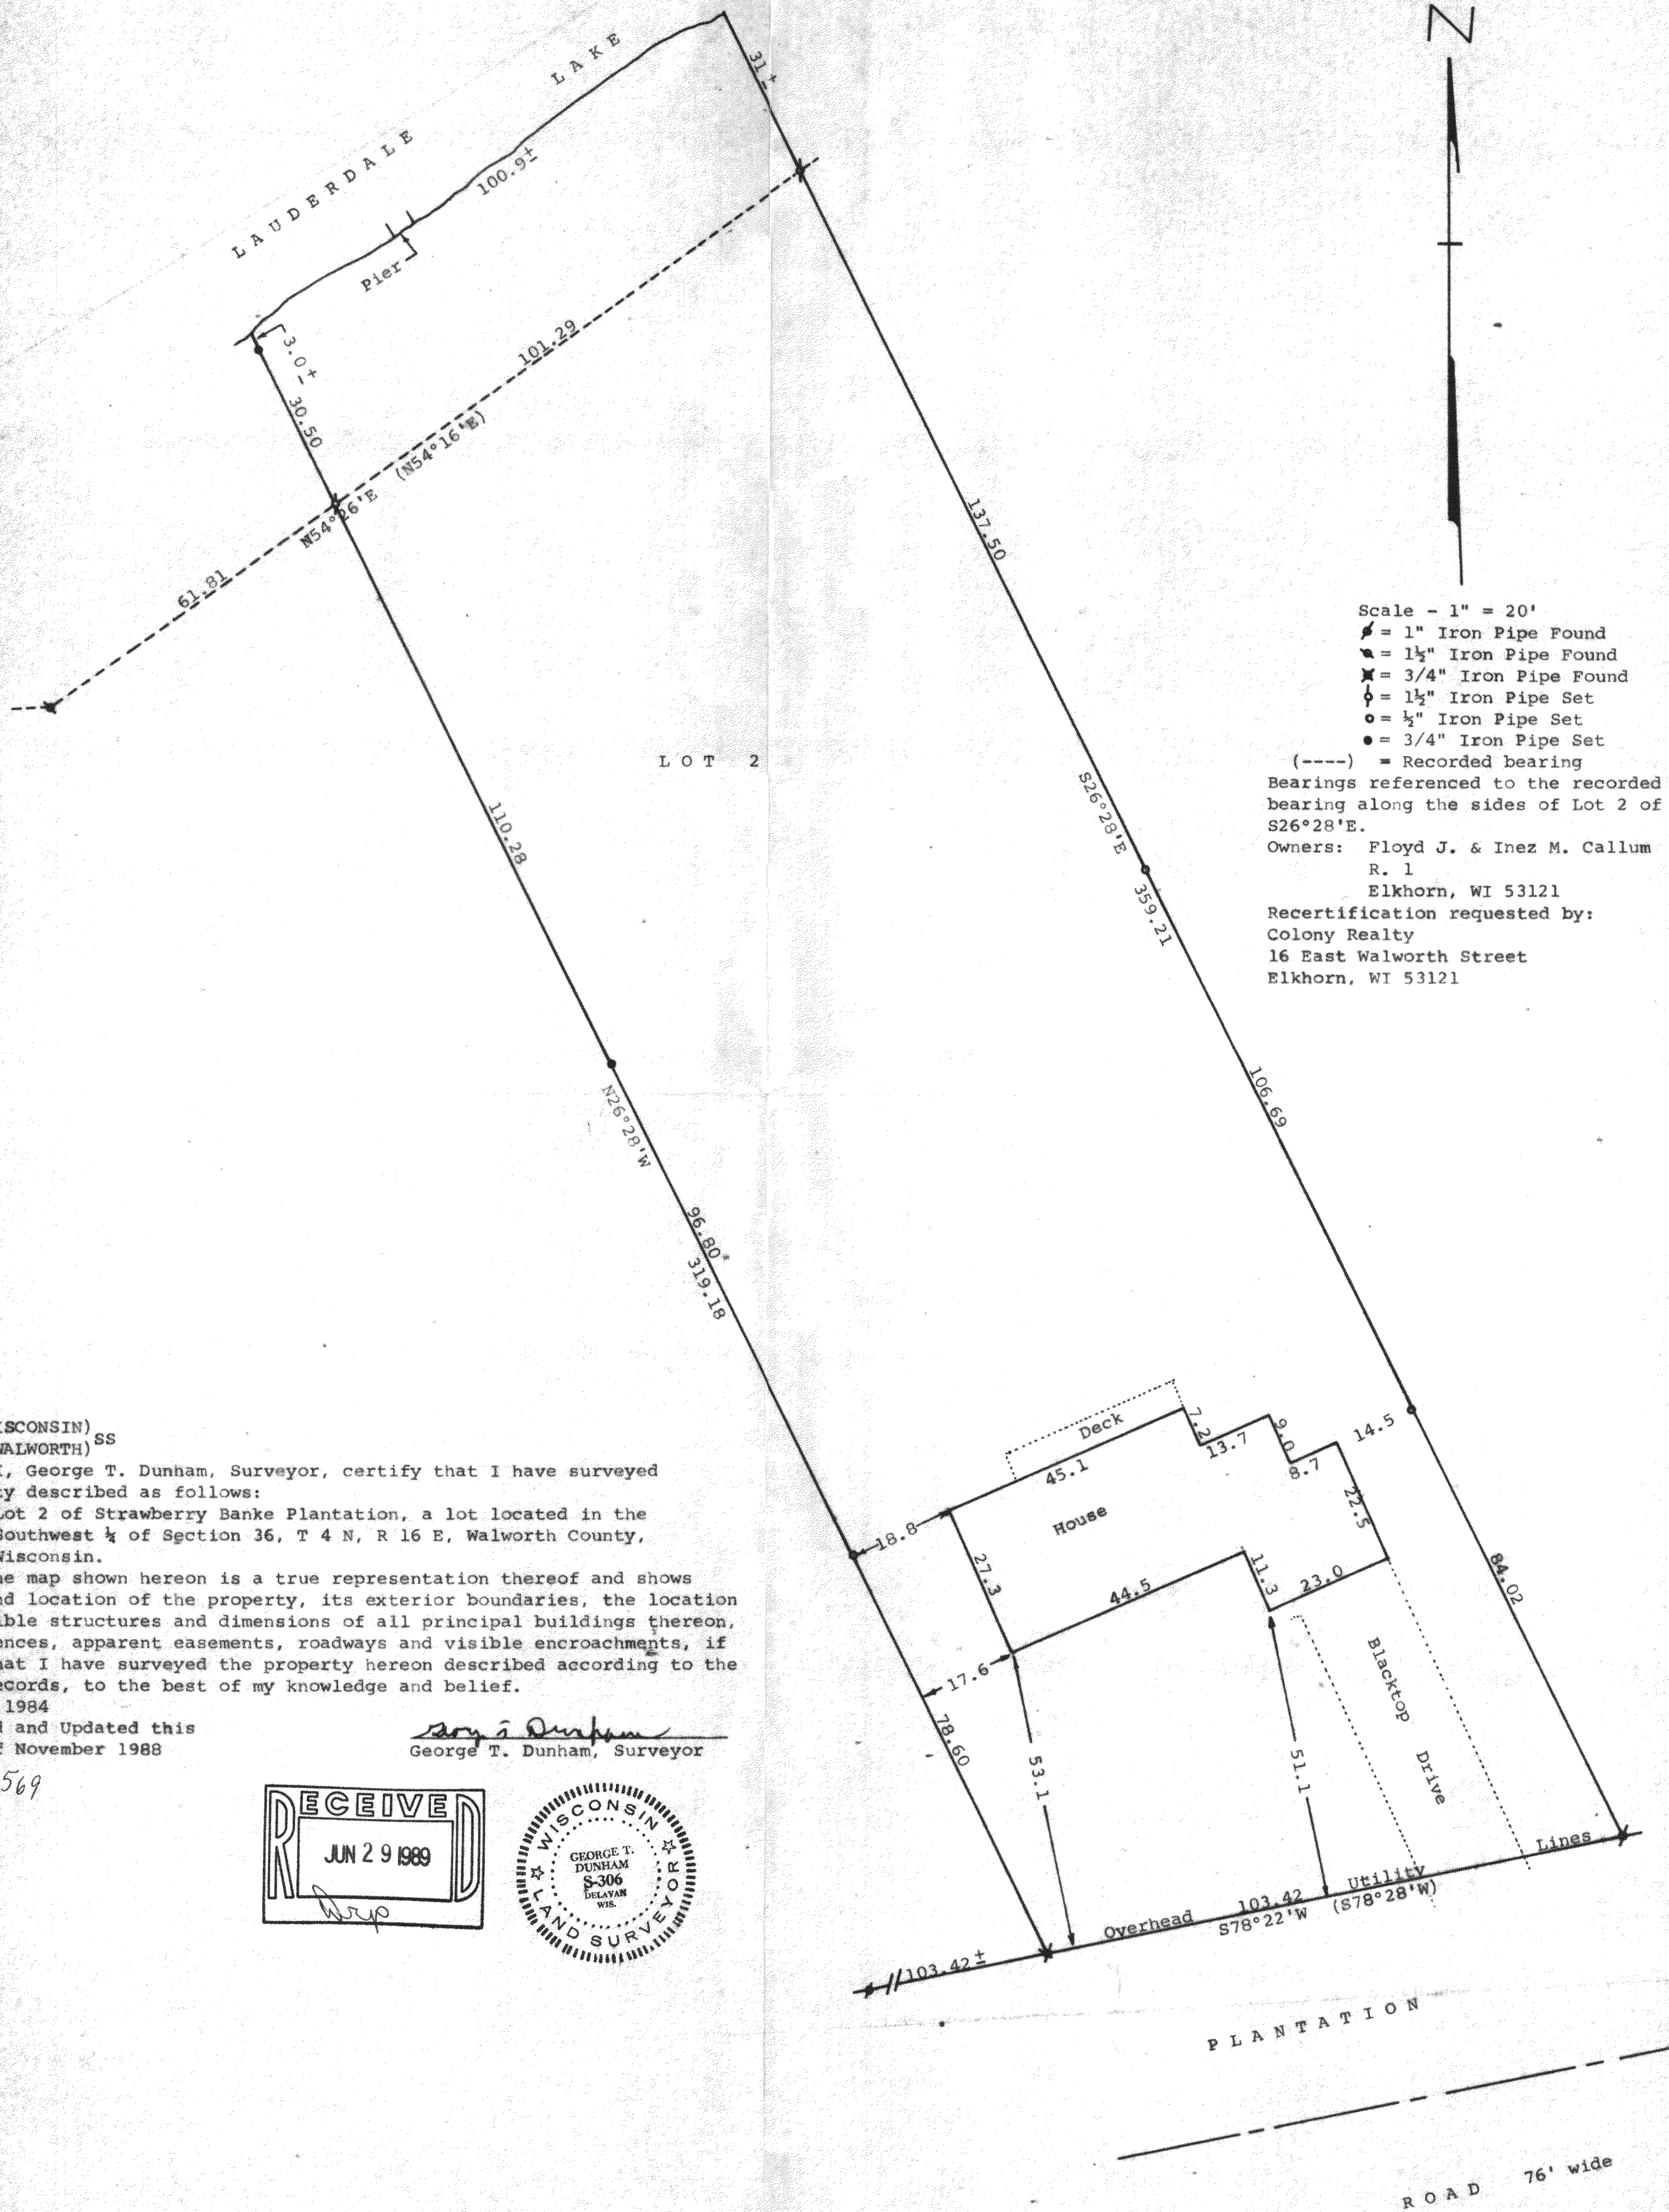

Scale - 1" = 20'

1" = 1" Iron Pipe Found

1 1/2" = 1 1/2" Iron Pipe Found

3/4" = 3/4" Iron Pipe Found

1 1/2" = 1 1/2" Iron Pipe Set

1/2" = 1/2" Iron Pipe Set

3/4" = 3/4" Iron Pipe Set

(---) = Recorded bearing

Bearings referenced to the recorded bearing along the sides of Lot 2 of S26°28'E.

Owners: Floyd J. & Inez M. Callum
R. 1
Elkhorn, WI 53121

Recertification requested by:
Colony Realty
16 East Walworth Street
Elkhorn, WI 53121

STATE OF WISCONSIN) SS
COUNTY OF WALWORTH)

I, George T. Dunham, Surveyor, certify that I have surveyed the property described as follows:

Lot 2 of Strawberry Banke Plantation, a lot located in the Southwest 1/4 of Section 36, T 4 N, R 16 E, Walworth County, Wisconsin.

and that the map shown hereon is a true representation thereof and shows the size and location of the property, its exterior boundaries, the location of all visible structures and dimensions of all principal buildings thereon, boundary fences, apparent easements, roadways and visible encroachments, if any, and that I have surveyed the property hereon described according to the official records, to the best of my knowledge and belief.

August 23, 1984

Recertified and Updated this
21st day of November 1988

George T. Dunham
George T. Dunham, Surveyor

