


ABELL
SURVEYING & MAPPING
DELAVER, WISCONSIN 53115
414-728-6737

DETAIL NOT TO SCALE

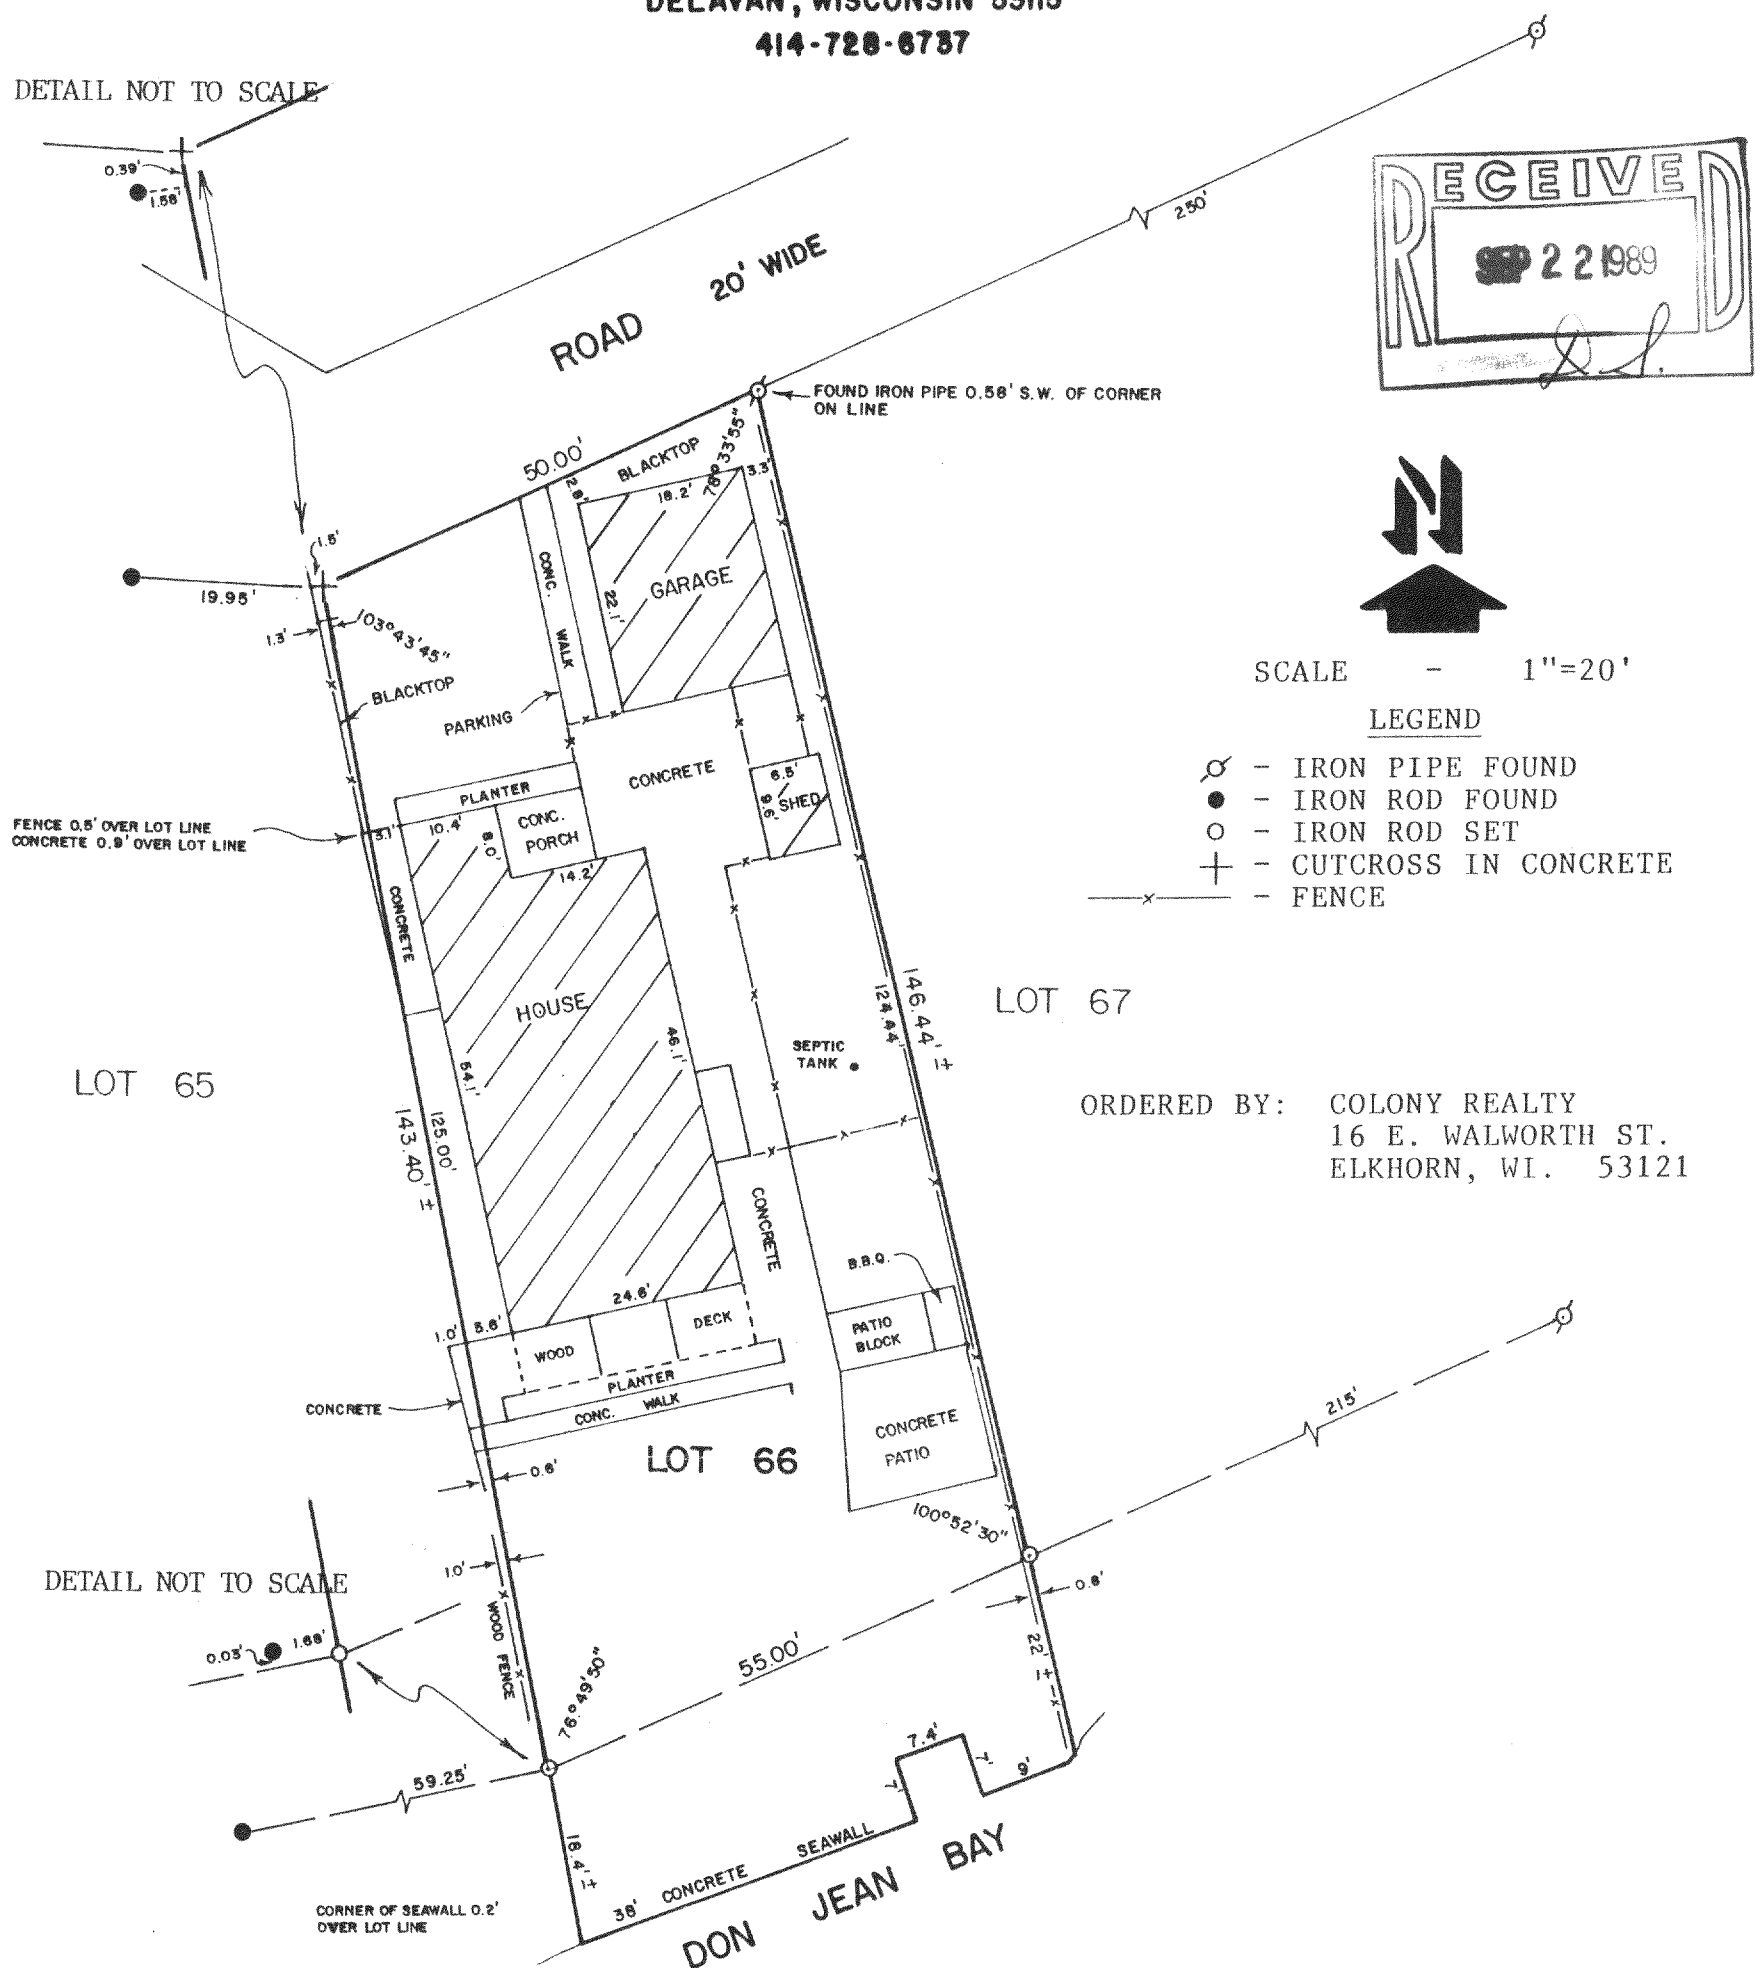

PLAT OF SURVEY OF

LOT 66 OF LAUDERDALE HEIGHTS SUBDIVISION AS PER THE PLAT
OF SAID TRACT RECORDED IN VOL. 8 OF PLATS ON PAGES 22 AND
23 IN THE OFFICE OF THE REGISTER OF DEEDS IN AND FOR
WALWORTH COUNTY, WISCONSIN. TAX NUMBER - HLH-27

I HEREBY CERTIFY THAT I HAVE SURVEYED THE ABOVE
DESCRIBED PROPERTY AND THAT THE ABOVE MAP IS A
TRUE REPRESENTATION THEREOF AND SHOWS THE SIZE
AND LOCATION OF THE PROPERTY, ITS EXTERIOR
BOUNDARIES, THE LOCATION OF ALL VISIBLE STRUCTURES
AND DIMENSIONS OF ALL PRINCIPAL BUILDINGS THEREON,
BOUNDARY FENCES, APPARENT EASEMENTS, ROADWAYS AND
VISIBLE ENCROACHMENTS, IF ANY, TO THE BEST OF MY
KNOWLEDGE AND BELIEF.
THIS SURVEY IS MADE FOR THE USE OF THE PRESENT
OWNERS OF THE PROPERTY, AND ALSO THOSE WHO
PURCHASE, MORTGAGE, OR GUARANTEE THE TITLE THERETO
WITHIN ONE (1) YEAR FROM THE DATE HEREOF.

David F. Abell

DAVID F. ABELL
WISCONSIN REGISTERED LAND SURVEYOR, S-1596

July 29, 1989

DATE: *July 29, 1989* JOB NUMBER - 89149
NOTE: THIS IS NOT A CERTIFIED COPY UNLESS SEALED.

1111-27

T-1111-27

416-571