


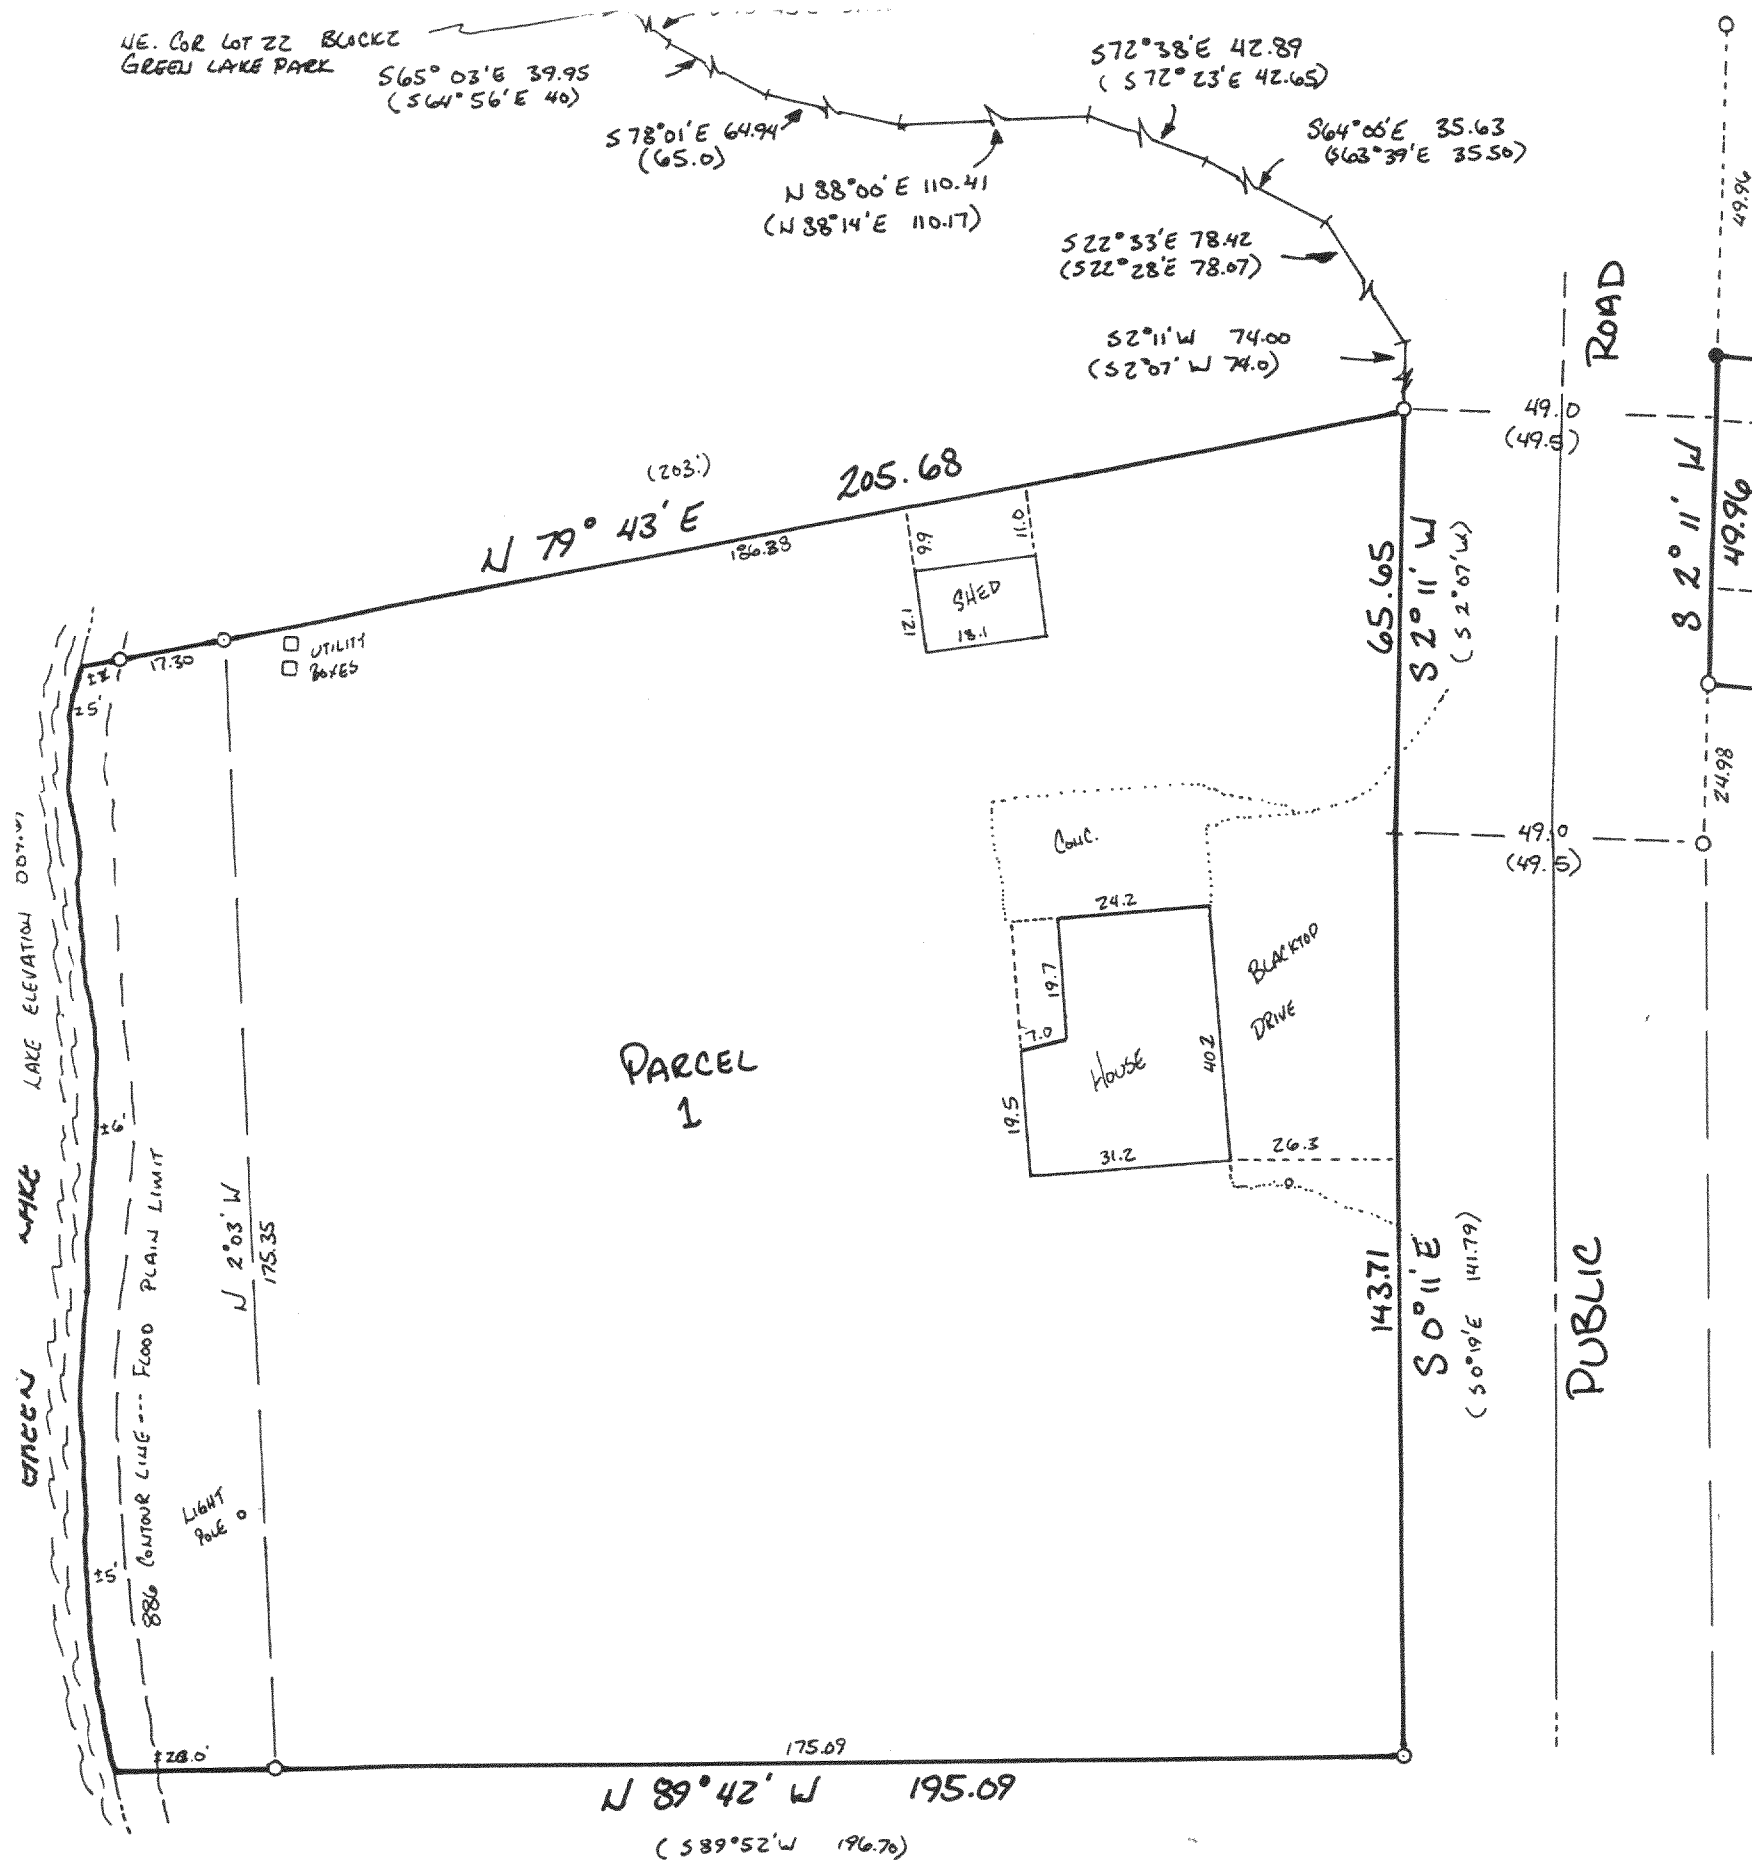

PLAT OF SURVEY
 of
 Parcels 1 and 2 as described below.

Surveyed for: Colony Realty
 16 East Walworth Street
 Elkhorn, Wisconsin. 53121

Surveyed by: Jensen Surveying & Mapping
 45 South Wisconsin Street
 Elkhorn, Wisconsin. 53121


Mapping date: June 28, 1989.

Bearings referenced to previous surveys

Scale: 1"=30'

Legend

- ~ Found iron pipe
- ~ Set iron pipe
- () ~ Recorded as dimension

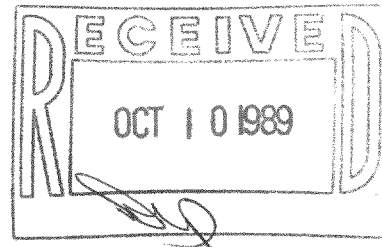

Tax parcels GP-18M & GP-41A1

Parcel 1
 Commencing at the N.E. corner of Lot 22 Block 2, Green Lake Park a sub-division in Section 26, T4N, R16E, Walworth County, Wisconsin; thence S. 48° 45' E., 39.90 feet to an iron stake, thence S. 64° 56' E., 40.0 feet to an iron stake, thence S. 78° 01' E., 65.0 feet to an iron stake thence N. 88° 14' E., 110.17 feet to an iron stake, thence S. 72° 23' E. 42.65 feet to an iron stake, thence S. 63° 39' E., 35.50 feet to an iron stake, thence S. 22° 28' E., 78.07 feet to an iron stake, thence S. 2° 07' W., 74.00 feet to the place of beginning of this description, thence S. 2° 07' W., 65.65 feet to a point, thence S. 0° 19' E., 141.79 feet to a point, thence S. 89° 52' W., 196.70 feet to the shore of Green Lake, thence N'ly along shore of Green Lake 175.0 feet more or less to a point that is 203.00 feet S. 79° 43' W., from the place of beginning, thence N. 79° 43' E., 203.00 feet to the place of beginning.

Parcel 2
 Commencing at the S 1/2 corner of Section 26, T. 4 N., R. 16 E., Walworth County, Wisconsin; thence N. 06° 32' E. 443.88 feet; thence N. 84° 32' W. 241.10 feet, thence N. 02° 11' E. 25.00 feet to the place of beginning of lands hereinafter described, to-wit: thence continue N. 02° 11' E. 50.00 feet, thence S. 84° 32' E. 100.00 feet, thence S. 02° 11' W. 50.00 feet, thence N. 84° 32' W. 100.00 feet to the place of beginning.

I, Thomas P.A. Jensen, Wisconsin Registered Land Surveyor, do hereby certify that this survey was performed by me, or under my direction, in full compliance with the owner's agent's instructions and Chapter A-E 7 of the Wisconsin Administrative Code "Minimum Standards For Property Surveys"; and that this map is an accurate representation thereof to the best of my knowledge and belief.

Note: This survey plat is not certified unless signed and sealed in red ink.

Thomas P.A. Jensen R.L.S-1084
 Jensen Surveying & Mapping S.C.

1989-073

Copyright © 1988 by Jensen Surveying & Mapping S.C.

All rights reserved. No part of this survey plat may be reproduced or transmitted in any form by any means - graphic, electronic, or mechanical, including photocopying, tracing, or information storage and retrieval systems - without permission in writing from Thomas P.A. Jensen, Jensen Surveying & Mapping S.C.

HEP-18M & HEP-41A1