

Farris, Hansen & Associates, Inc.

7 RIDGEWAY COURT, P.O. BOX 437, ELKHORN, WISCONSIN

TEL. 414-723-2098

LOCATION: LOT 17, BLOCK 1, PEBBLE BEACH SUB., IN NW 1/4
SEC. 25, T4N, R16E, WALWORTH CO., WISCONSIN


WORK ORDERED BY: FRANK & GLADYS JACKLIN

MAP SCALE IN FEET

10 0 10 20 30 40 50 60 70 80 90 100
ORIGINAL SCALE: 1"=30'

MAP LEGEND

- = IRON PIPE STAKE FOUND
- = IRON PIPE STAKE SET
- = IRON ROD STAKE FOUND
- = IRON ROD STAKE SET
- = CONCRETE MONUMENT FOUND
- (XXXXX) = RECORD DIMENSION
- ✱ = SPIKE NAIL FOUND

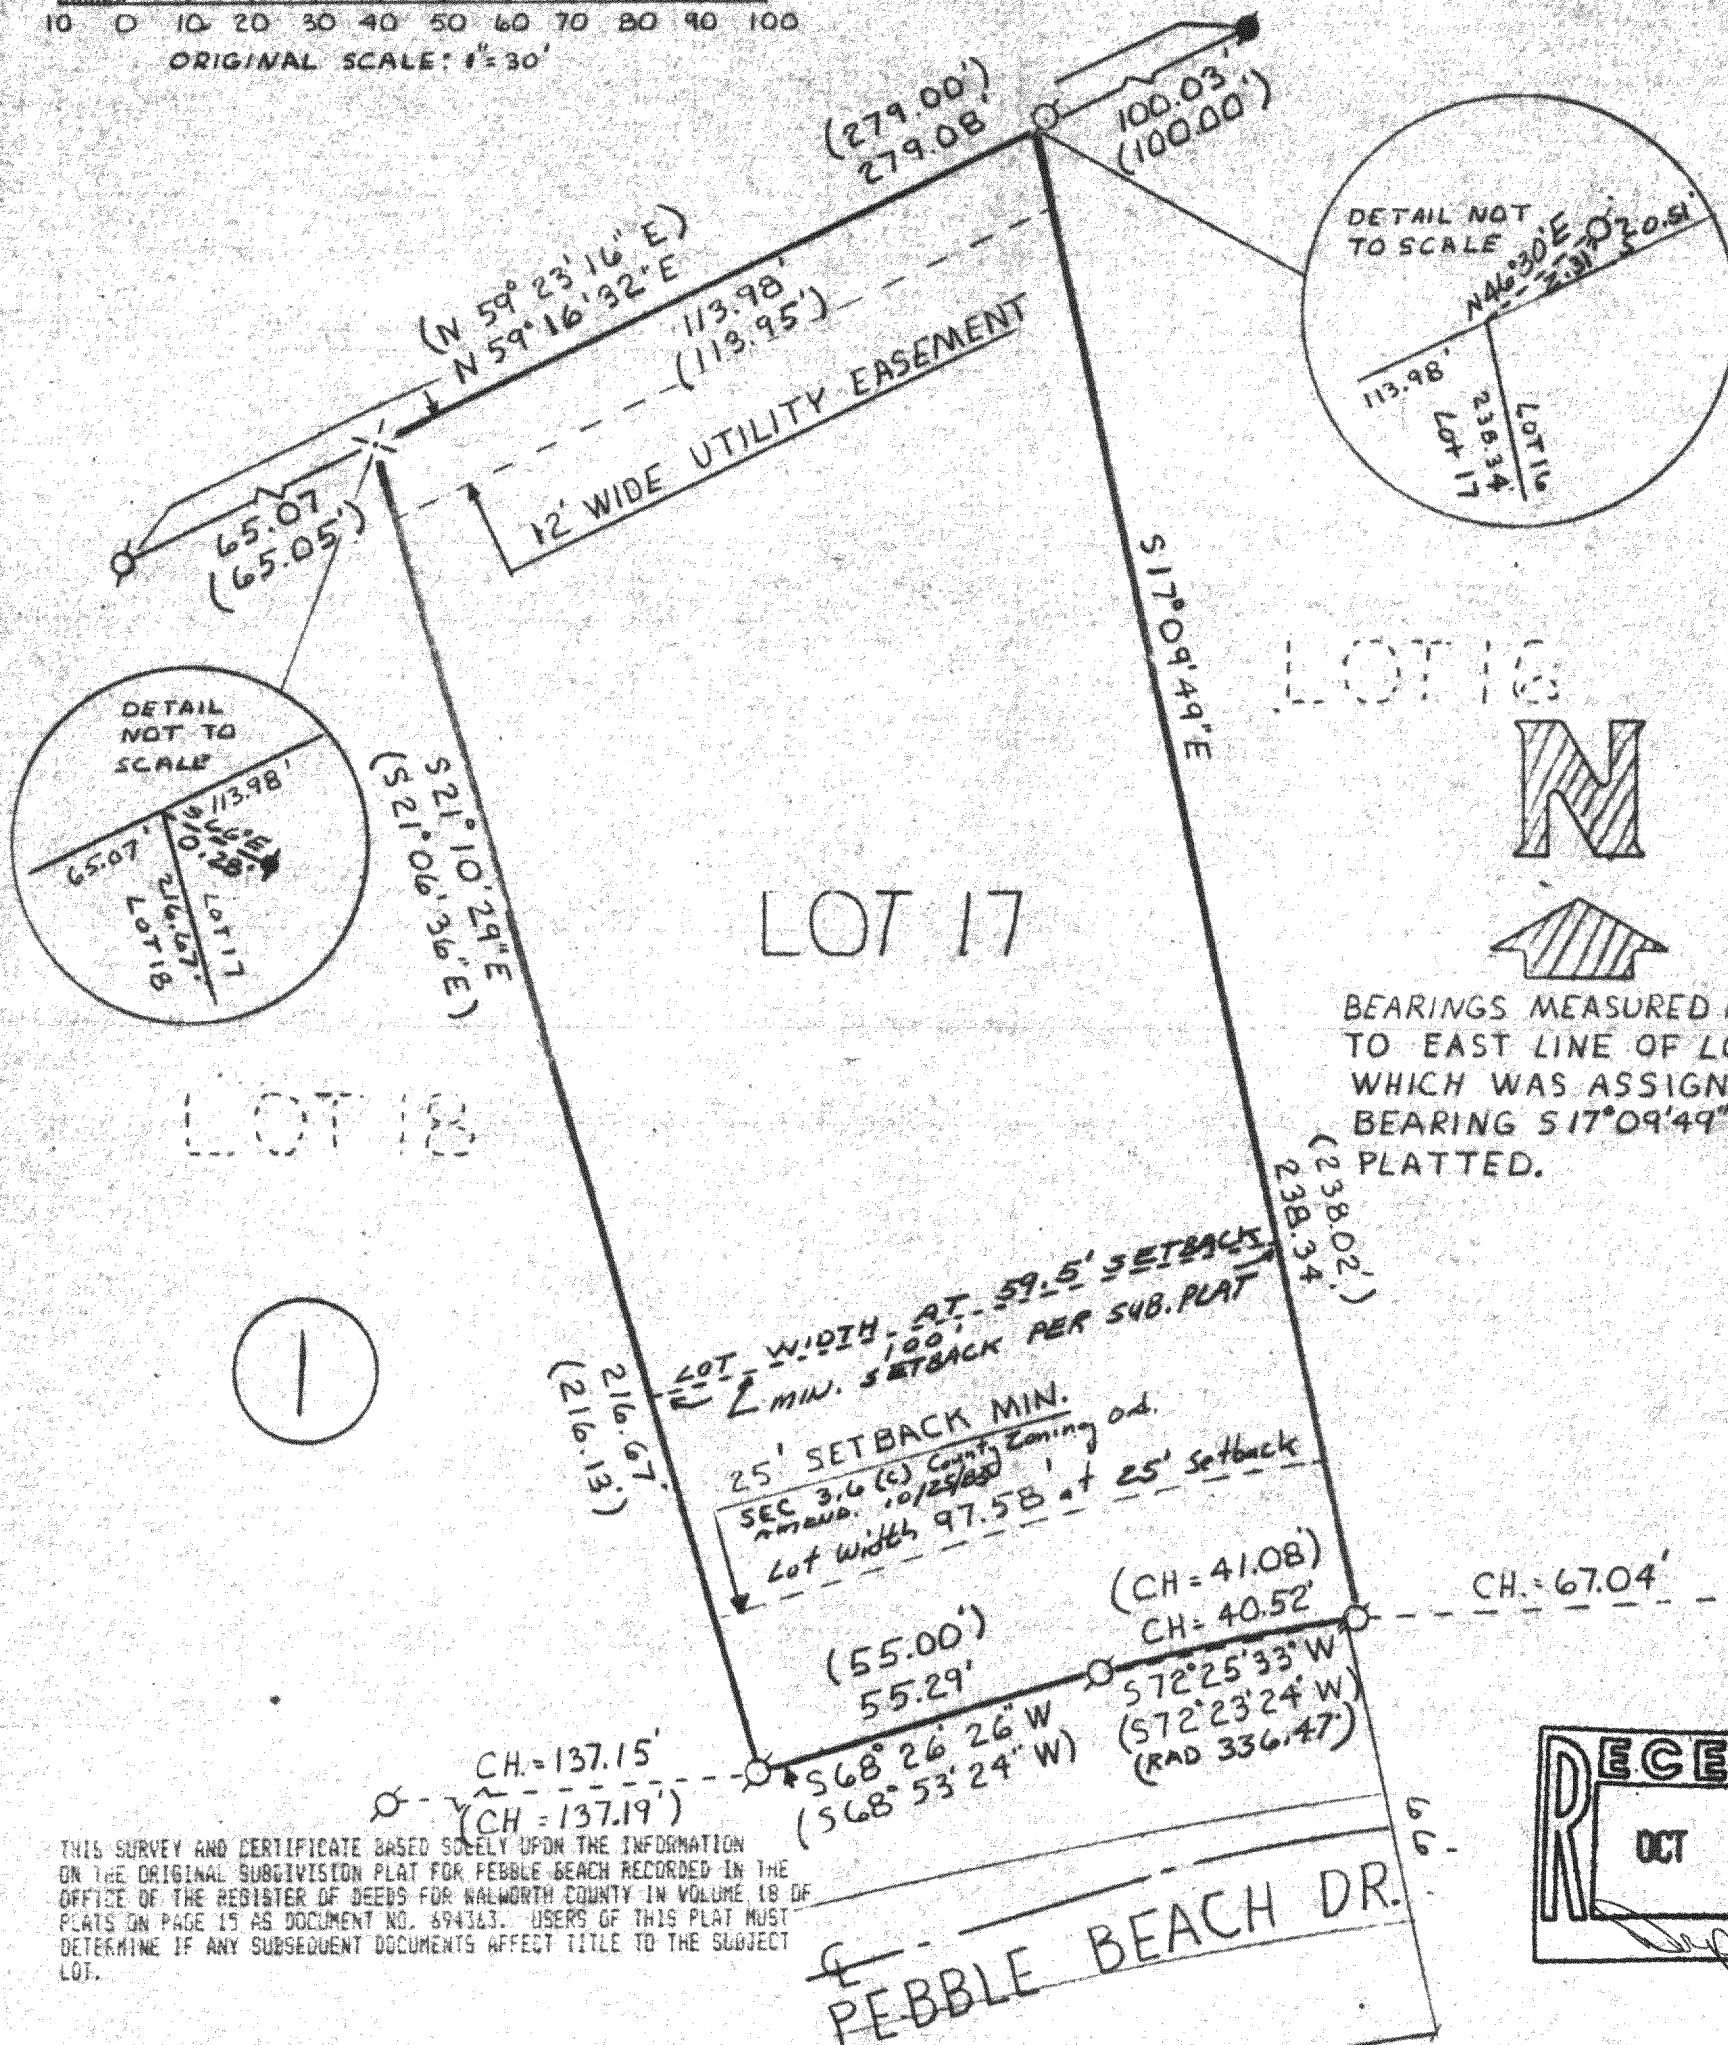

THIS SURVEY AND CERTIFICATE BASED SOLELY UPON THE INFORMATION ON THE ORIGINAL SUBDIVISION PLAT FOR PEBBLE BEACH RECORDED IN THE OFFICE OF THE REGISTER OF DEEDS FOR WALWORTH COUNTY IN VOLUME 18 OF PLATS ON PAGE 15 AS DOCUMENT NO. 894363. USERS OF THIS PLAT MUST DETERMINE IF ANY SUBSEQUENT DOCUMENTS AFFECT TITLE TO THE SUBJECT LOT.


NOTE: COPIES OF THIS MAP TO WHICH THE FOLLOWING CERTIFICATE WILL APPLY ARE BLUE LINE PRINTS SHOWING SURVEYOR'S SEAL AND SIGNATURE IN BLACK INK. COPIES BY ANY OTHER MEANS MAY HAVE ALTERATIONS WHICH DO NOT REPRESENT THE SURVEYOR'S WORK PRODUCT.

I hereby certify that the above described property has been surveyed under my direction and that the above map is a true representation thereof and shows the size and location of the property and its exterior boundary dimensions and monuments. This survey is made for the use of the present owners of the property, and also those who purchase, mortgage, or guarantee the title thereto within one year from the date hereof.

DATED: 7/25/89

BASED ON FIELD MEAS. ON 6/29/89

HPE-17

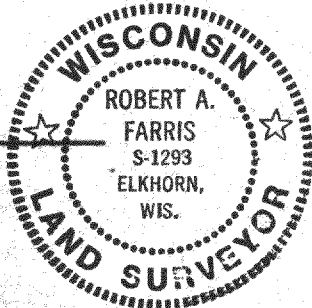

PROJ. NO. 3251

