



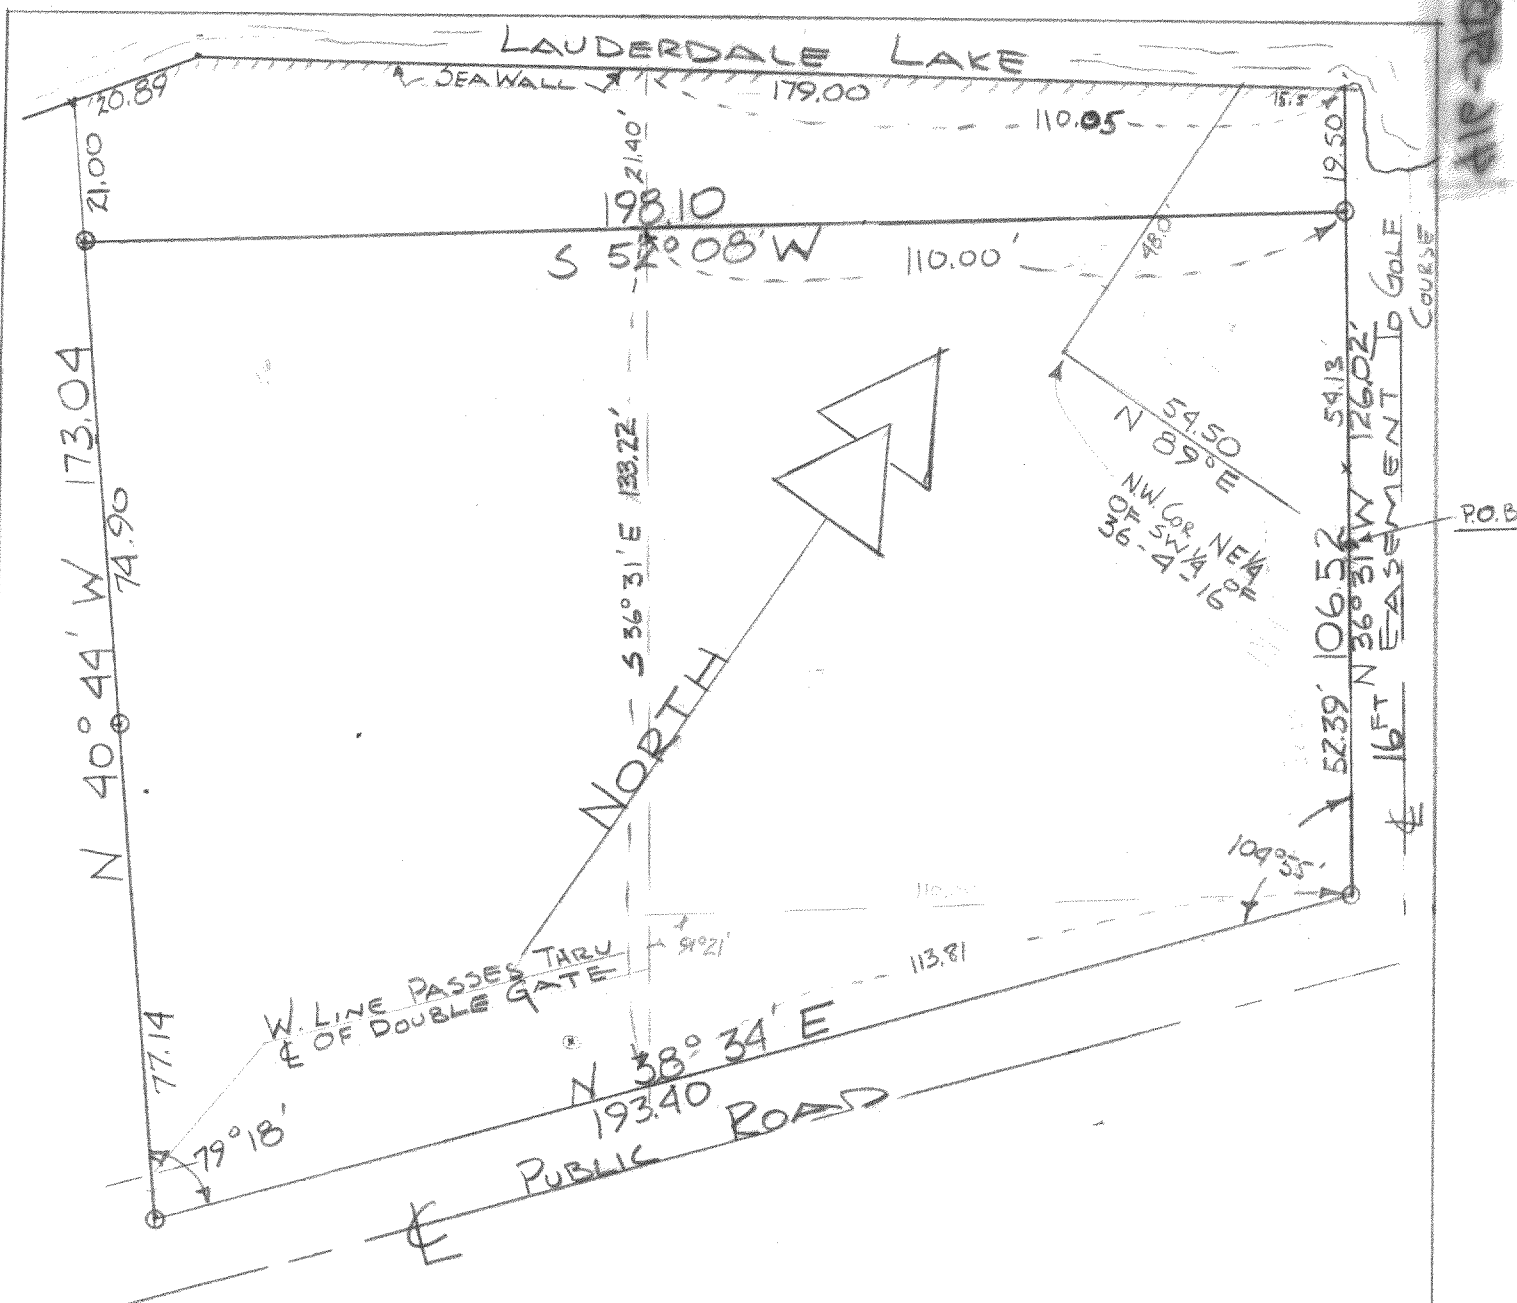

DESCRIPTION: Commencing at a point that is 54.50 feet N 89° E of the N.W. corner of the NE 1/4 of the SW 1/4 of Section 36, Town 4 North, Range 16 East, Walworth County Wisconsin; thence N 36° 31' W 73.63 feet to the shore line of Lauderdale Lake, thence SW'ly along said shore line 199.89 feet to a point, thence S 40° 44' E. 173.04 feet to an iron stake, thence N 38° 34' E 193.40 feet to an iron stake, thence N 36° 31' W 52.39 feet to the place of beginning.

CERTIFICATE: I, James F. Biagi, Surveyor, do hereby certify that I have surveyed the property described on this 15th day of April, 1961.

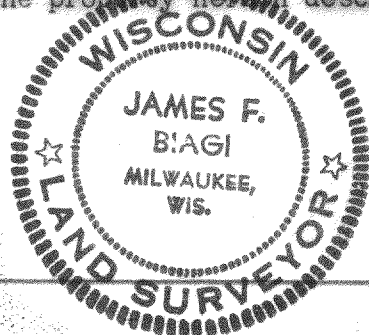

James F. Biagi
James F. Biagi RLS 272

416-596