

Plat of Survey of a parcel of land located in the SE 1/4 of Fractional Section 26, T4N, R16E, Walworth County, Wisconsin and described as follows: Beginning at the Northeast corner of Lot 12 of the recorded Plat of LaSelva Subdivision; thence N10°E 85.00 feet; thence West 154 feet to the Shore of Green Lake; thence Southerly along the Shore 100.0 feet to the Northwest corner of said lot 12; thence Easterly on the North line of said lot 139 feet to the point of beginning.

Bearings referenced to other survey on record in the County Surveyors office. Westerly line of Solid Confort Drive assumed to Bear N08°52'E

TAX PARCEL LG 26-32A

SCALE 1"=20'

100' ALONG SHORE LINE

CONCRETE WALK

CONCRETE WALL - SEA WALL
DRAINAGE WAY
OVER LINE

SET 1" X 24" IRON PIPE

EXISTING BOAT HOUSE

EXISTING DECK
EXISTING RESIDENCE
PROPOSED DECK ADDITION

ADJOINING OWNERS
LANDSCAPING
OVER LINE IN
THIS AREA
139.00'

FOUND IRON PIPE

LOT 12 LA SELVA

RR LANDSCAPING
TIES OVER LINE

NAIL SET IN
RR TIE RETAINING
WALL

COMFORT DRIVE



SOLID

I hereby certify that I have surveyed the property described hereon and that the map shown hereon is a true and accurate representation thereof to the best of my professional knowledge and belief.

dated this 1 day of JUNE, 1990

Daniel D. Cooper, RLS No. S-1464

Survey ordered by
Russel Schelkopf
229 Somonauk
Sycamore Ill 60178

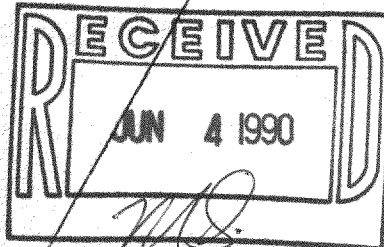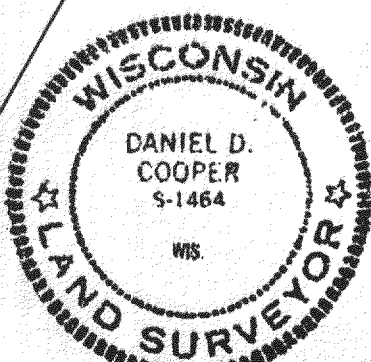

D. D. COOPER & CO., INC.
Daniel D. Cooper
Rt. 4 Box 508B
Elkhorn, WI 53121

TAX # HLG-26-31
PT. OF HLG-26-32A

Drawing No. 3637-20
416-1074