


○-INDICATES IRON PIPE FOUND
●-INDICATES IRON PIPE SET

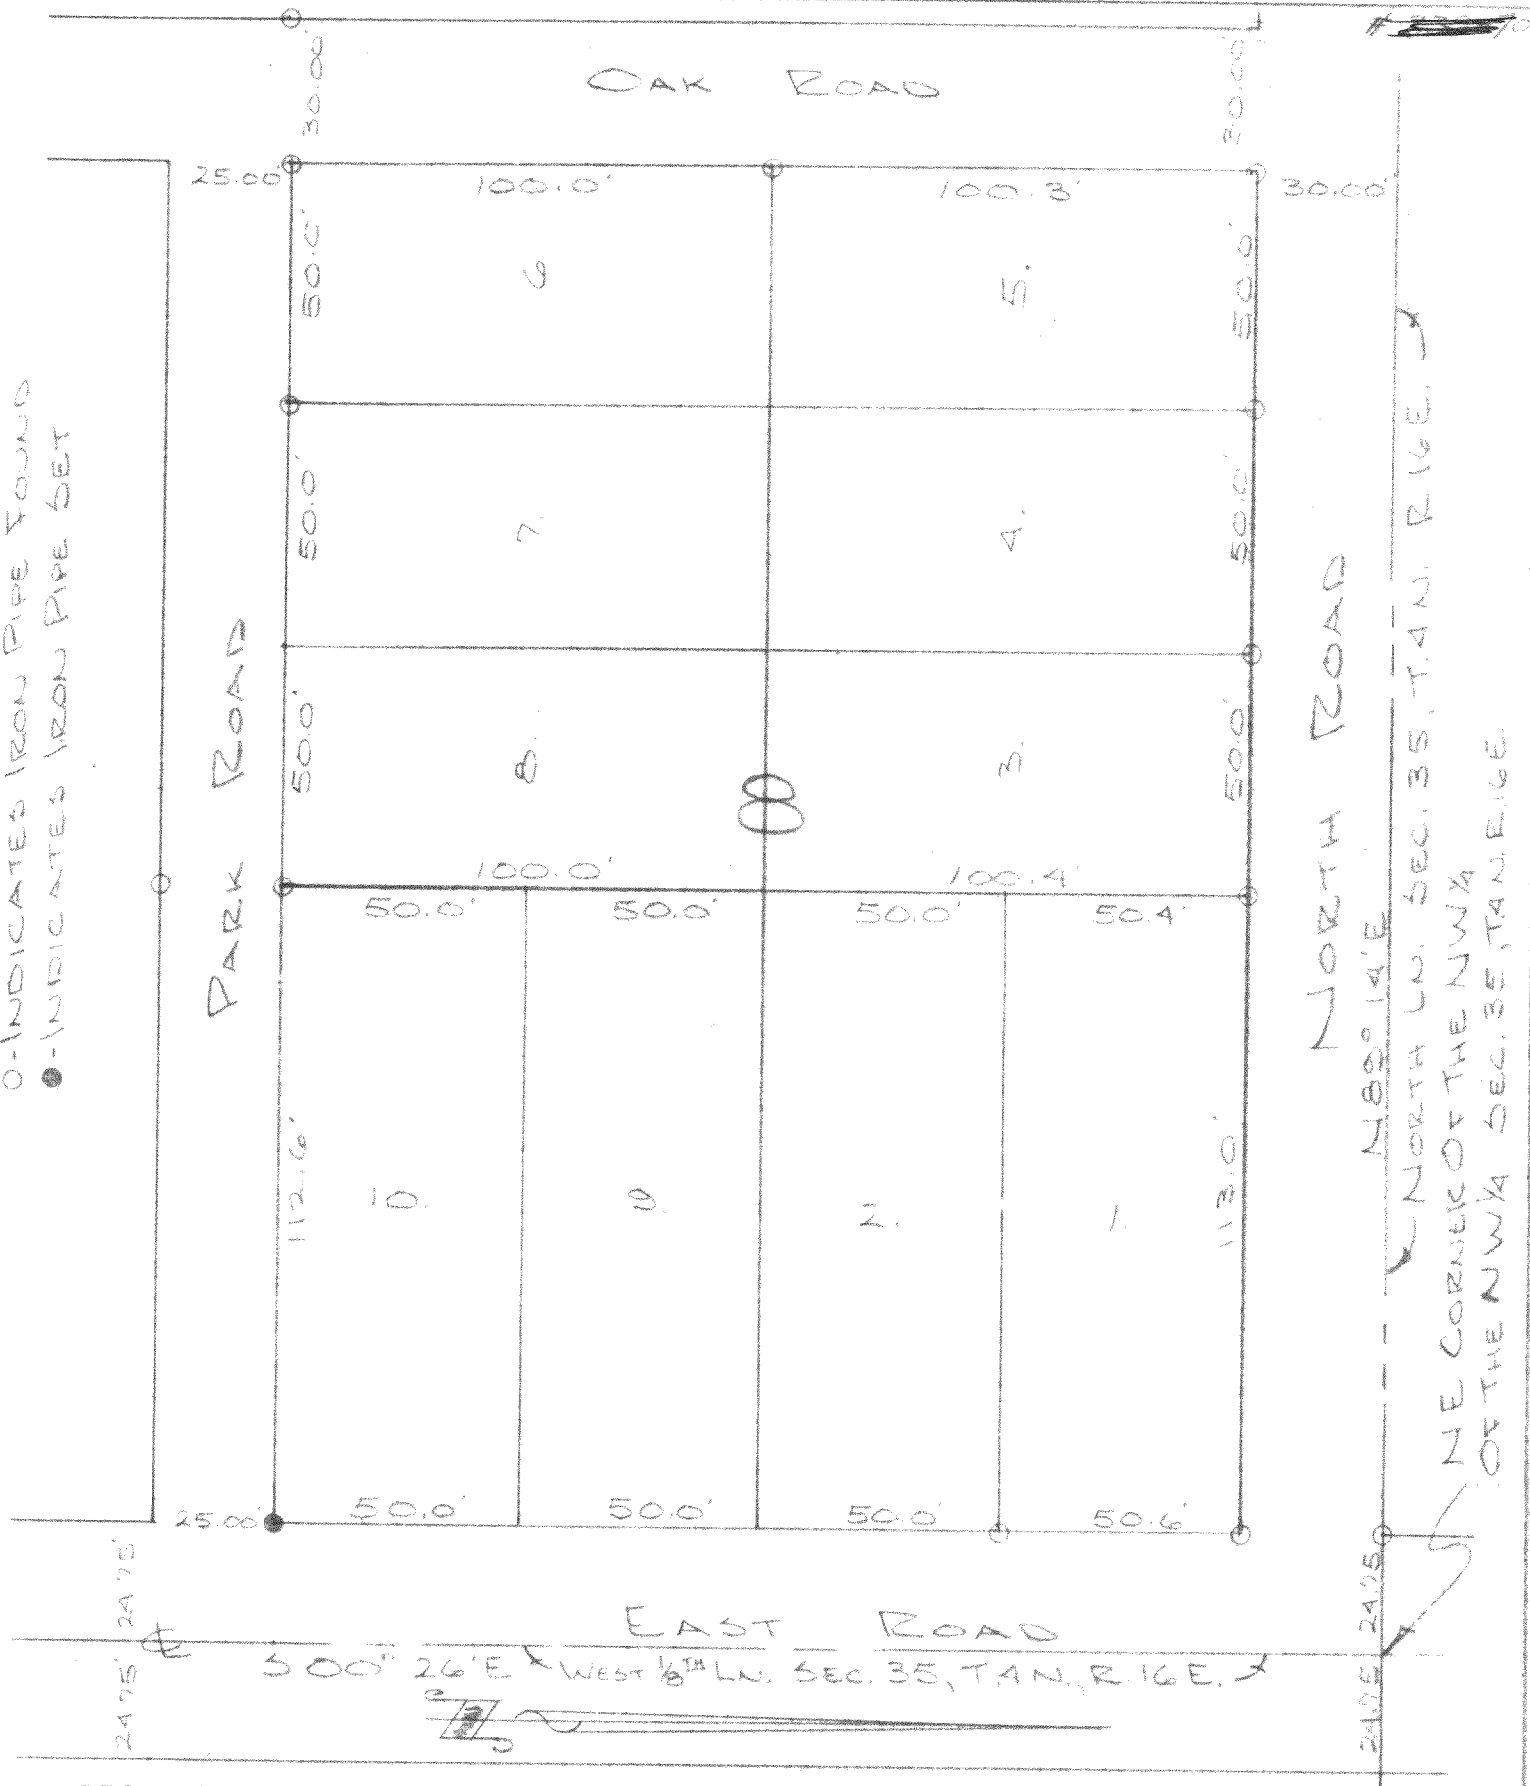

DESCRIPTION:

BLOCK 8, COOPERS MID LAKES SUBDIVISION
SECTION 35, T4N, R16E

CERTIFICATE:

I, James F. Biagi, surveyor,
do hereby certify that I have
surveyed the lands hereon
described,

James F. Biagi

R.L.S. 272

4/6-61