


ABELL
SURVEYING & MAPPING
DELAVER, WISCONSIN 53115
414-728-6737

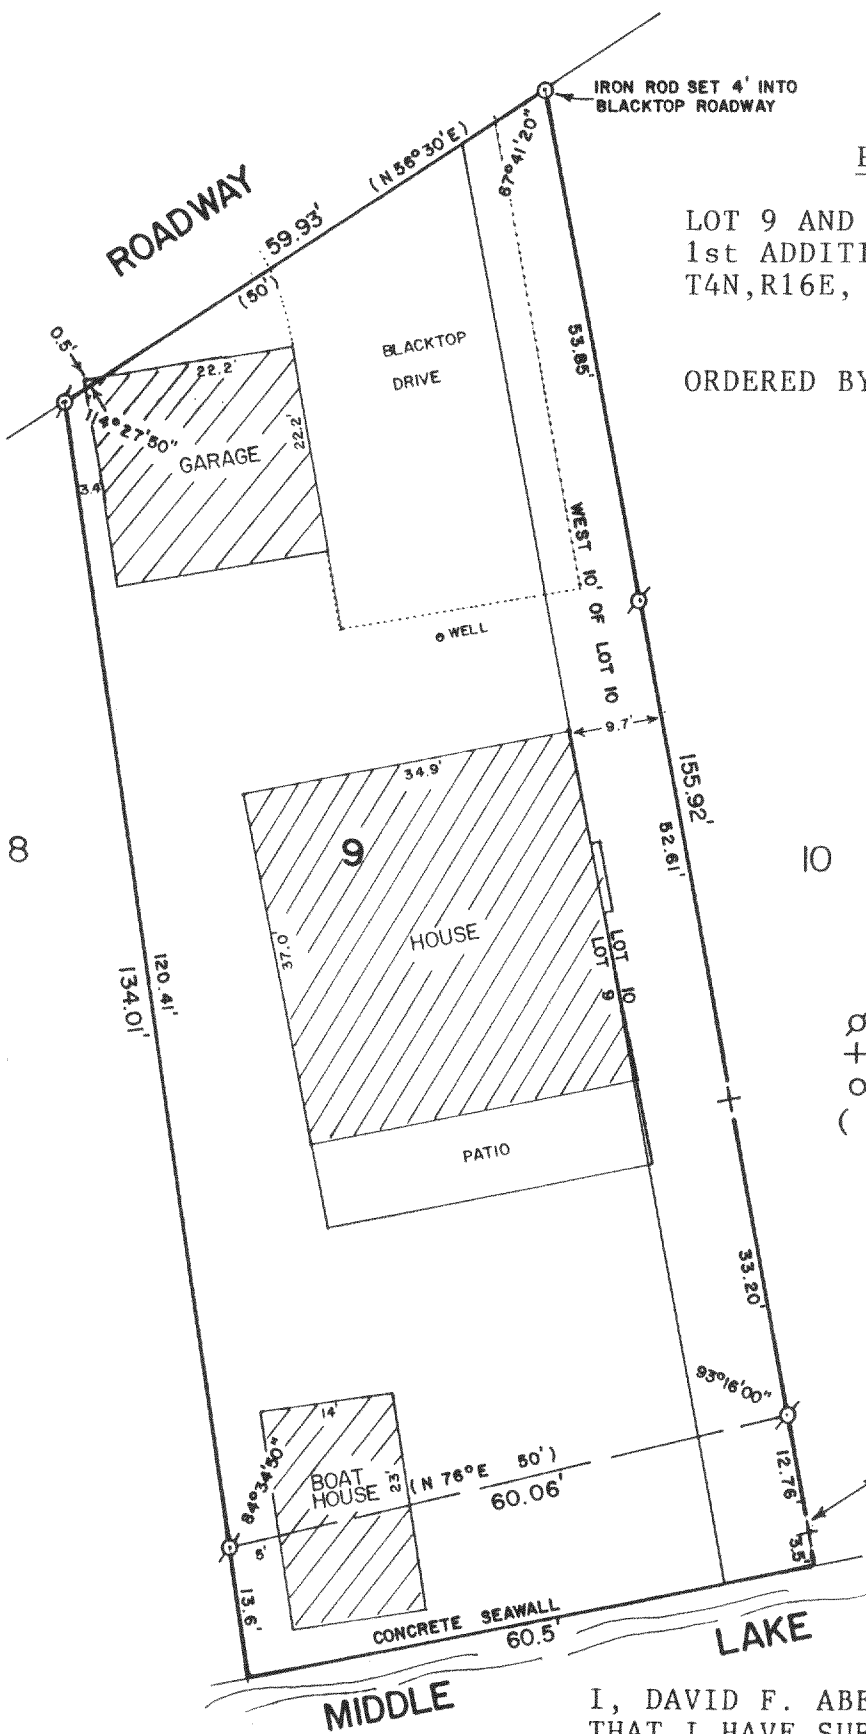

PLAT OF SURVEY OF

LOT 9 AND THE WEST 10 FEET OF LOT 10,
1st ADDITION TO LAUDERDALE PARK,
T4N, R16E, WALWORTH COUNTY, WISCONSIN.

ORDERED BY: WALLEY BUSH
DATA DIMENSIONS CORP.
P.O. BOX 1465
JANESVILLE, WI. 53547




SCALE - 1"=20'

LEGEND

- ⊗ - IRON PIPE FOUND
- + - CUTCROSS IN CONCRETE FOUND
- - IRON ROD SET
- () - RECORDED AS

INSERT NOT TO SCALE

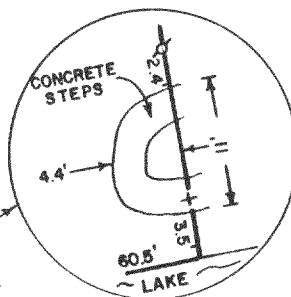

I, DAVID F. ABELL, DO HEREBY CERTIFY
THAT I HAVE SURVEYED THE PROPERTY
HEREON DESCRIBED ACCORDING TO THE
OFFICIAL RECORDS AND THAT THE PLAT
HEREON IS A CORRECT REPRESENTATION
OF THE PROPERTY LINES TO THE BEST OF
MY KNOWLEDGE AND BELIEF.

David F. Abell


DAVID F. ABELL
WISCONSIN REGISTERED LAND SURVEYOR, S-1596

October 6, 1988

DATE

JOB NUMBER - 88232

NOTE: THIS IS NOT A CERTIFIED COPY UNLESS SEALED.

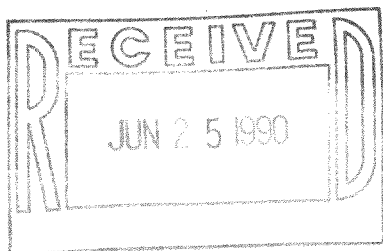

REVISED: MARCH 21, 1990

Tax # HLP A-2

416-611