
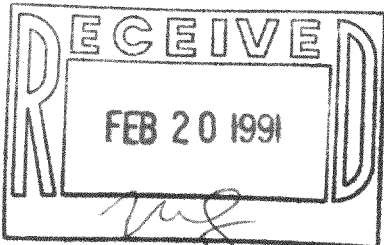


BAY SHORE DRIVE

Plat of Survey of Lot 13, Block 1 of
Bay View Manor Subdivision, being located
in Section 36, T4N, R16E, Walworth County,
Wisconsin.

Bearing reference: Westerly line
of Bay Shore Drive assumed to
bear N9°07'E as recorded
on the original plat

Scale 1" = 20'

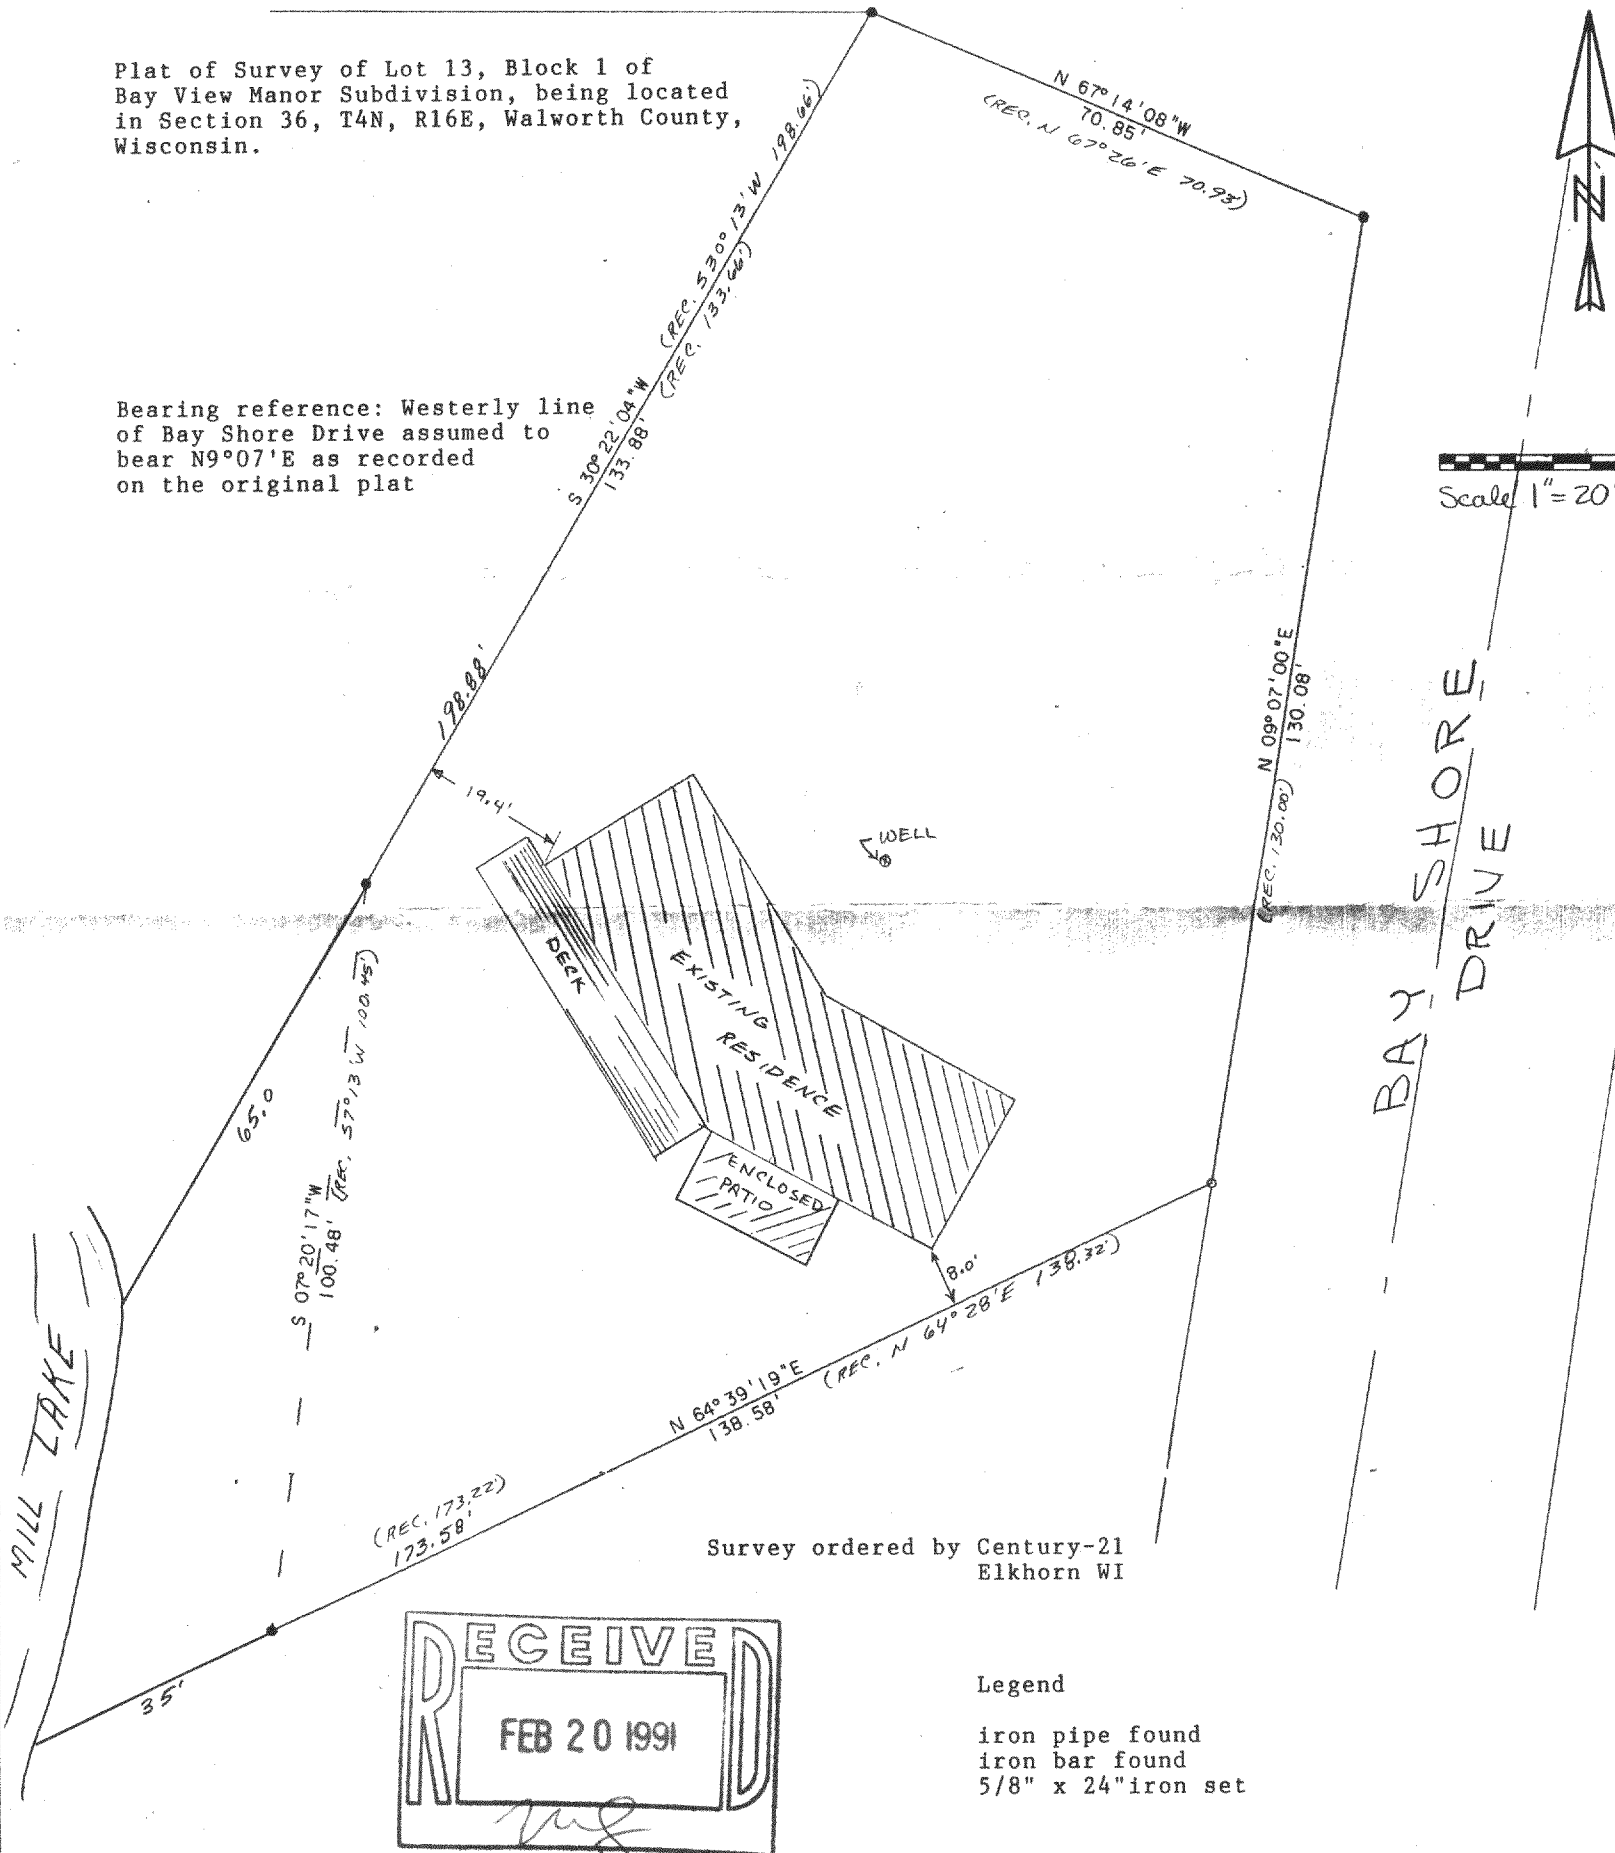

Legend


- iron pipe found
- iron bar found
- 5/8" x 24" iron set

I hereby certify that I have surveyed the
property described hereon and that the
map shown hereon is a true and accurate
representation thereof to the best of my
professional knowledge and belief.

Dated this 27th day of April, 1990

Daniel D Cooper

Daniel D. Cooper, RLS No. S-1464

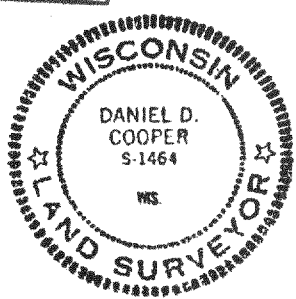

Reduced

DRAWING #3606

TAX KEY # HB 00013

416-643