



Plat of Survey of Lot 122
MARINER HILLS, Being a Subdivision
Located in the Town of LAGRANGE,
WALWORTH COUNTY WI.

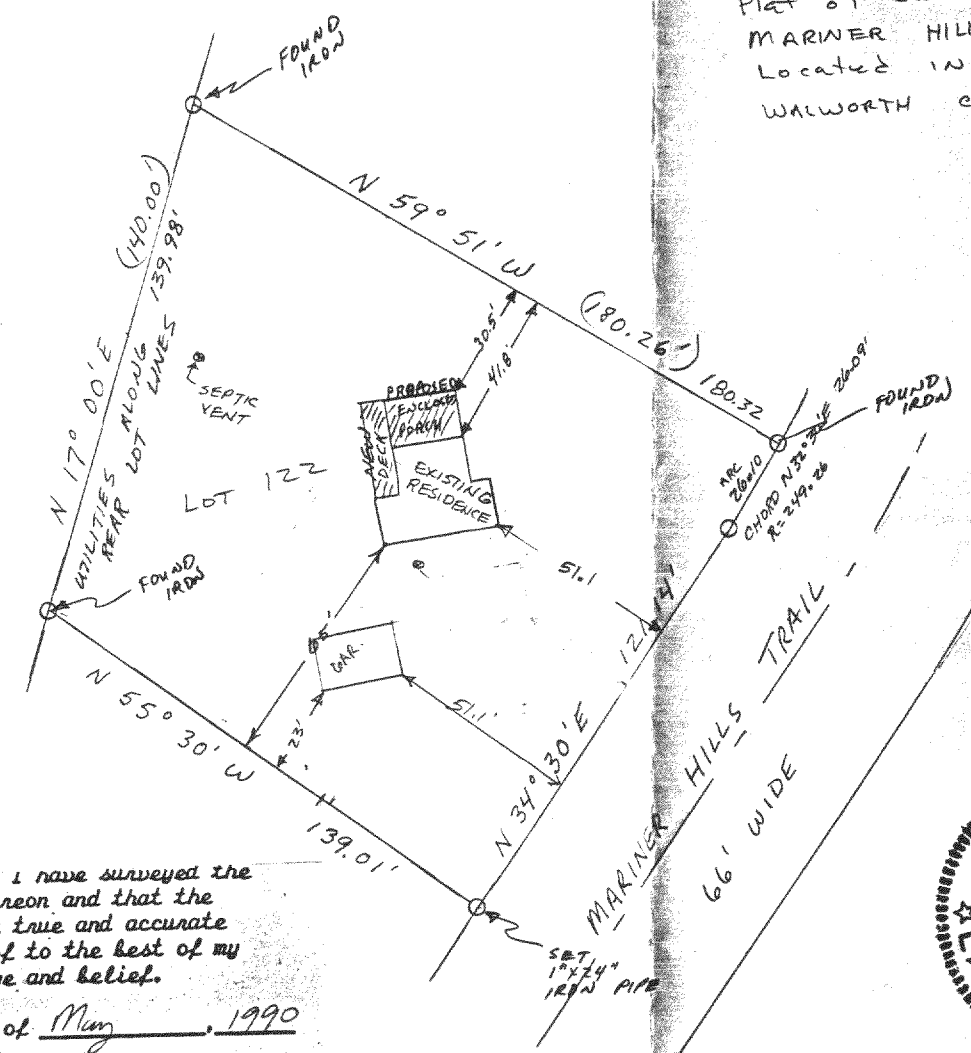

SURVEY ORDERED BY:
JIM KENT - ELKHORN WI.

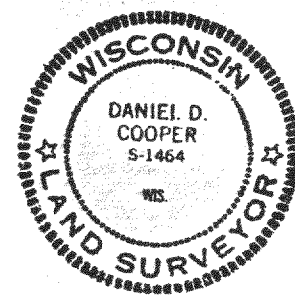


I hereby certify that I have surveyed the property described hereon and that the map shown hereon is a true and accurate representation thereof to the best of my professional knowledge and belief.

Dated this 25 day of May, 1990

Daniel D. Cooper
Daniel D. Cooper, RLS No. S-1464

1" = 40'
MAY 25, 1990
3631-20-110

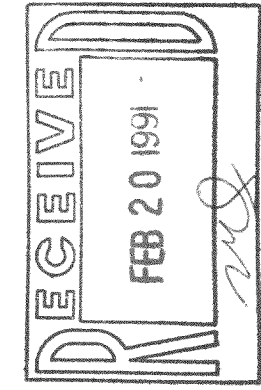

Reduced

TAX KEY #
HMH 00122

416-645