


**ABELL
SURVEYING & MAPPING
DELAVER, WISCONSIN 53115
414-728-8737**

DETAIL NOT TO SCALE

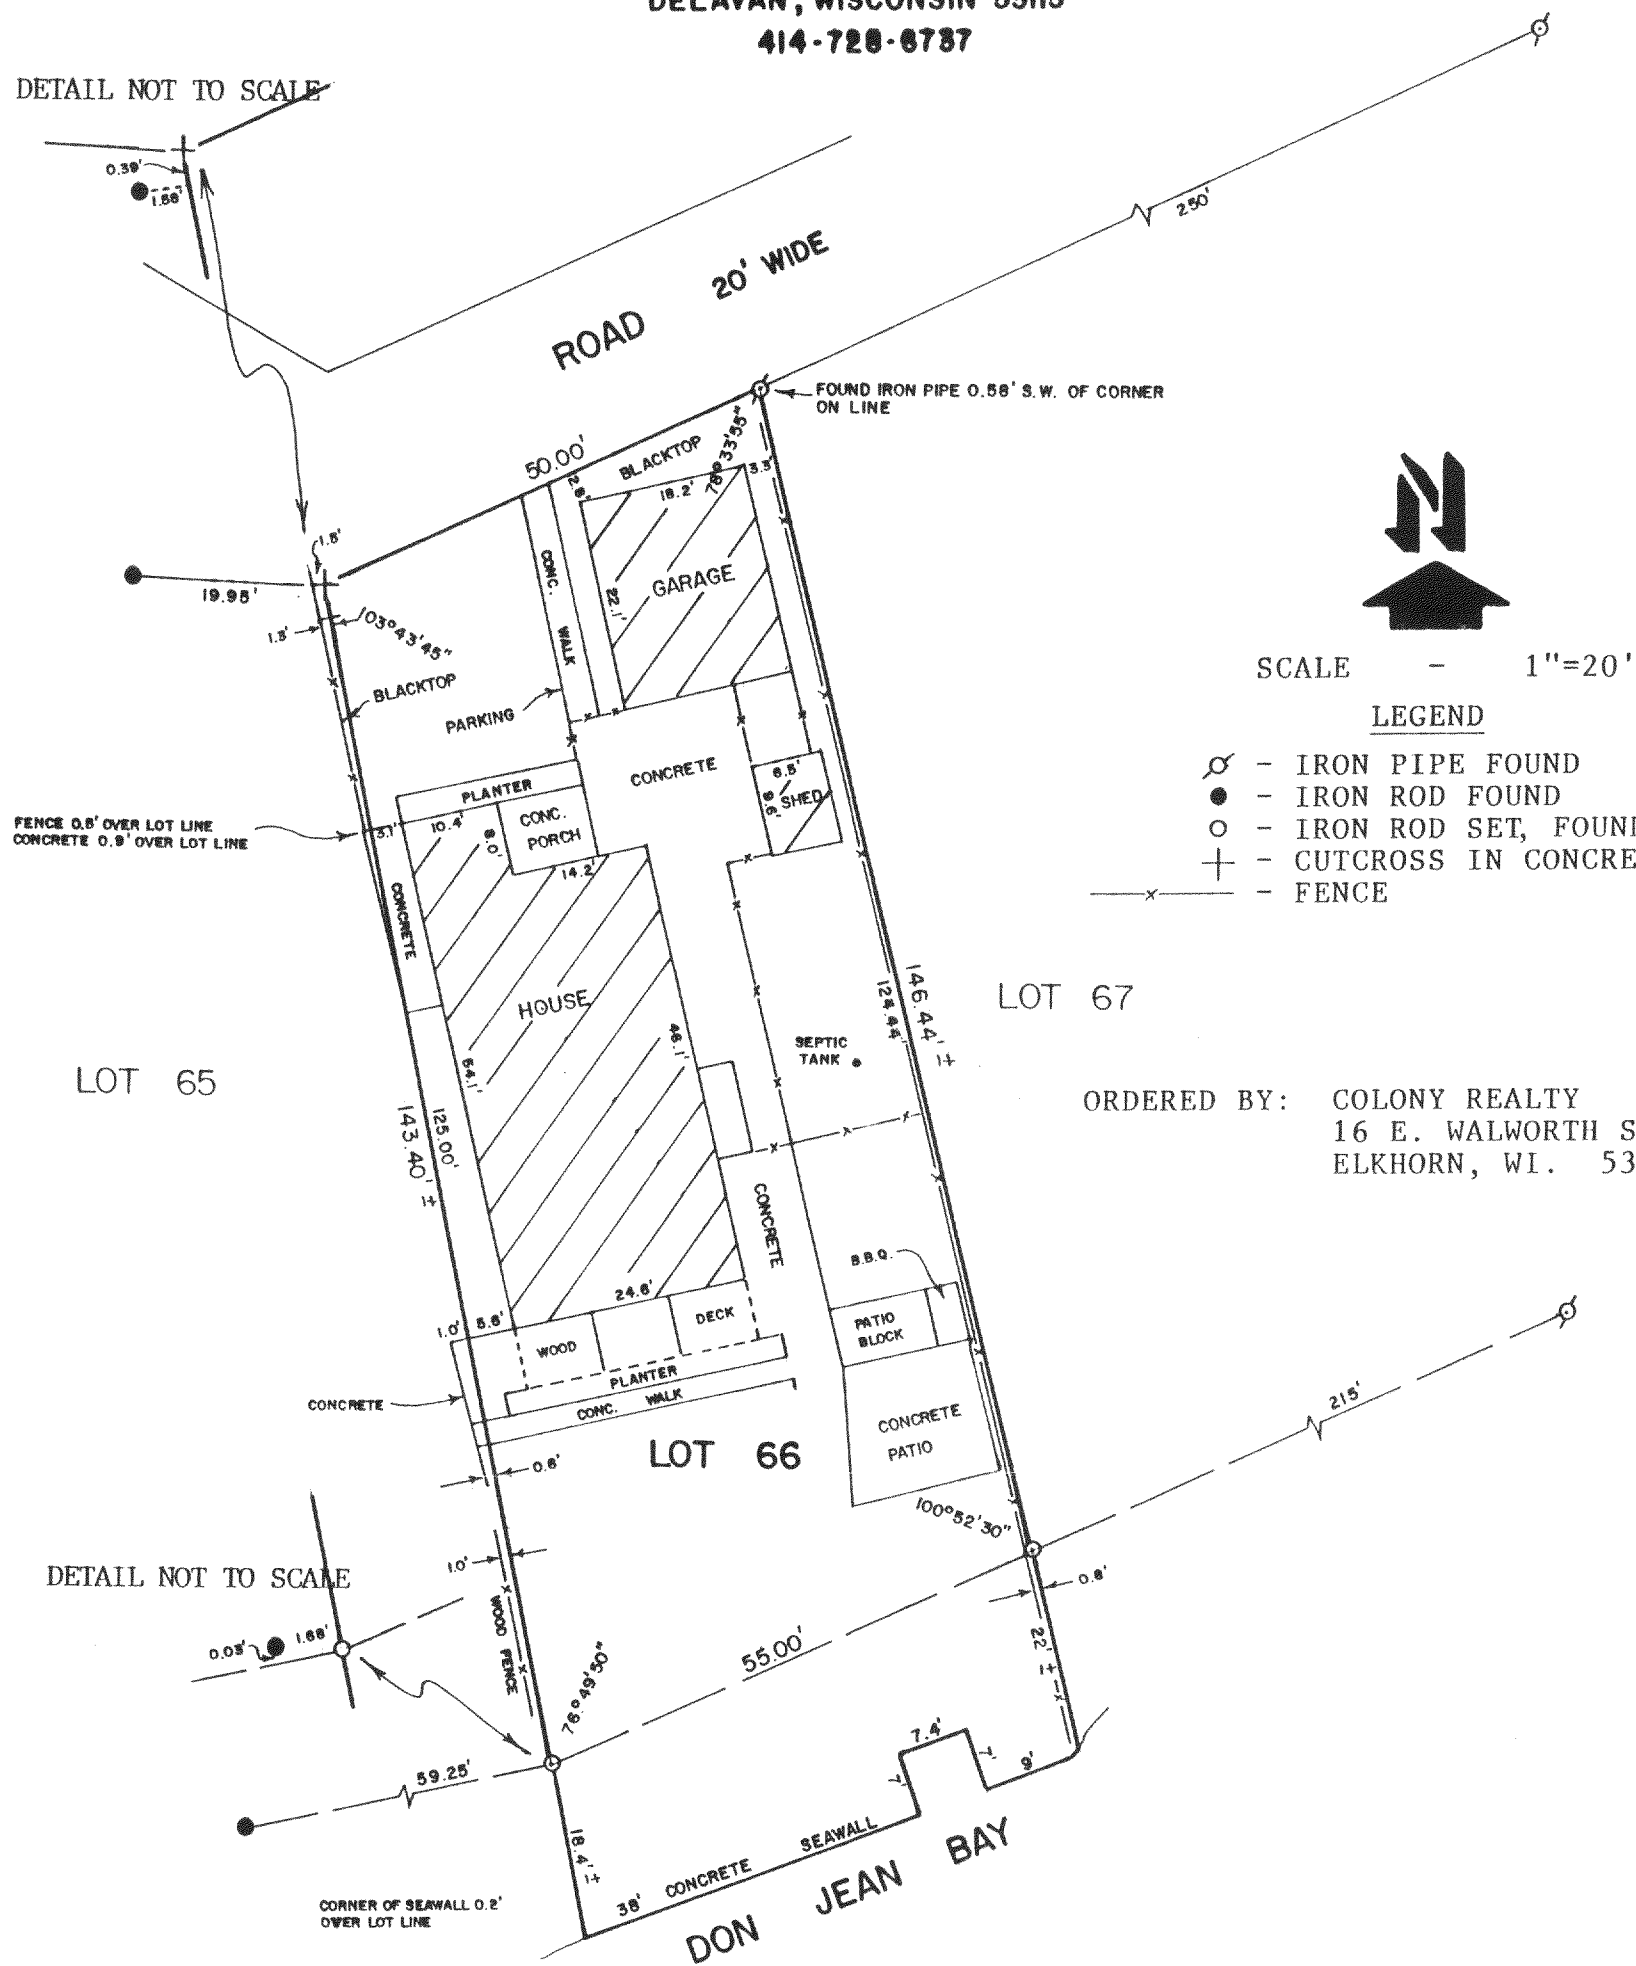

SCALE - 1"=20'

LEGEND


- ⊗ - IRON PIPE FOUND
- - IRON ROD FOUND
- - IRON ROD SET, FOUND 6-15-90
- ⊕ - CUTCROSS IN CONCRETE
- x— - FENCE

ORDERED BY: COLONY REALTY
16 E. WALWORTH ST.
ELKHORN, WI. 53121

PLAT OF SURVEY OF

LOT 66 OF LAUDERDALE HEIGHTS SUBDIVISION AS PER THE PLAT OF SAID TRACT RECORDED IN VOL. 8 OF PLATS ON PAGES 22 AND 23 IN THE OFFICE OF THE REGISTER OF DEEDS IN AND FOR WALWORTH COUNTY, WISCONSIN. TAX NUMBER - HLH-27

I HEREBY CERTIFY THAT I HAVE SURVEYED THE ABOVE DESCRIBED PROPERTY AND THAT THE ABOVE MAP IS A TRUE REPRESENTATION THEREOF AND SHOWS THE SIZE AND LOCATION OF THE PROPERTY, ITS EXTERIOR BOUNDARIES, THE LOCATION OF ALL VISIBLE STRUCTURES AND DIMENSIONS OF ALL PRINCIPAL BUILDINGS THEREON, BOUNDARY FENCES, APPARENT EASEMENTS, ROADWAYS AND VISIBLE ENCROACHMENTS, IF ANY, TO THE BEST OF MY KNOWLEDGE AND BELIEF.
THIS SURVEY IS MADE FOR THE USE OF THE PRESENT OWNERS OF THE PROPERTY, AND ALSO THOSE WHO PURCHASE, MORTGAGE, OR GUARANTEE THE TITLE THERETO WITHIN ONE (1) YEAR FROM THE DATE HEREOF.

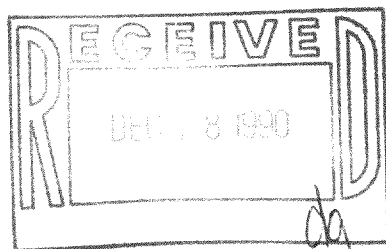

David F. Abell
DAVID F. ABELL
WISCONSIN REGISTERED LAND SURVEYOR, S-1596

REVISED: JUNE 16, 1990

July 29, 1989
DATE: *July 29, 1989* JOB NUMBER - 89149
NOTE: THIS IS NOT A CERTIFIED COPY UNLESS SEALED.

416-679

HLH 00027