


Plat of Survey

of

Lot 4 of Dunbar Estates Subdivision, located in Section 36, Town 4 North
Range 16 East, Town of Sugar Creek, Walworth County, Wisconsin.

Surveyed for: Mike O'Donell
Rt. 5 Lot 26 Evergreen
Elkhorn, Wisconsin. 53121

Bearings referenced to the
Subdivision Plat.

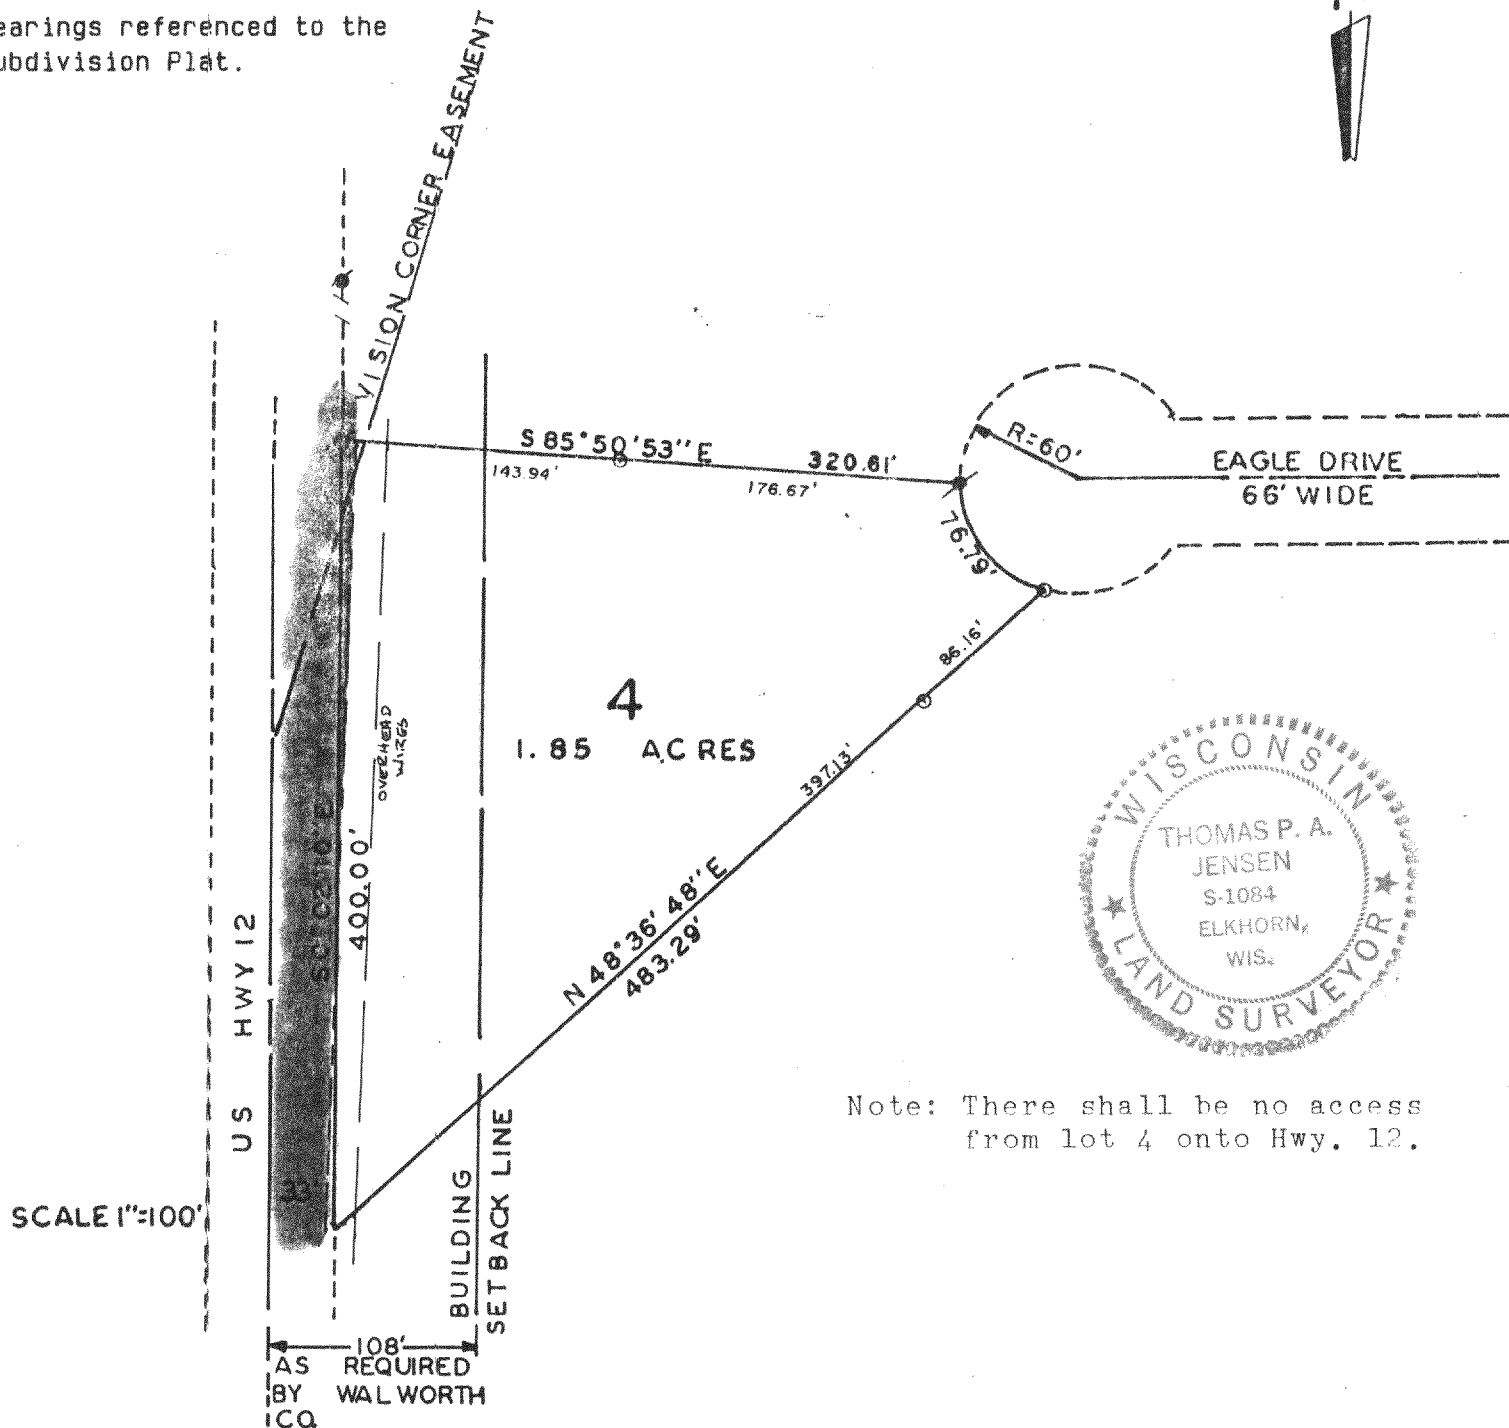


Copyright © 1990 by Jensen Surveying & Mapping S.C.

All rights reserved. No part of this survey plat may be reproduced or transmitted in any form by any means - graphic, electronic, or mechanical, including photocopying, tracing, or information storage and retrieval systems - without permission in writing from Thomas P.A. Jensen.

I, Thomas P.A. Jensen, Wisconsin Registered Land Surveyor, do hereby certify that this survey was performed by me, or under my direction, in full compliance with the owner's/agent's instructions and Chapter A-E 7 of the Wisconsin Administrative Code 'Minimum Standards For Property Surveys', and that this map is an accurate representation thereof to the best of my knowledge and belief.

Note: This survey plat is not
certified unless signed
and sealed in red ink.

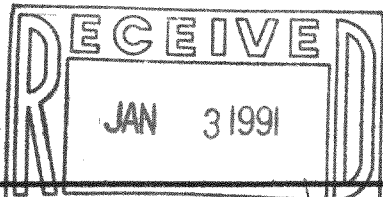

Thomas P.A. Jensen
Thomas P.A. Jensen R.L.S. 1084

Legend

- Found iron rod
- Set iron rod 3/4 dia.
- ⊗ Set iron rod 1 3/16 dia.
- () Recorded as dimension
- Blacktop surface

Jensen Surveying & Mapping S.C.


45 South Wisconsin Street P.O. Box 322
Elkhorn, Wisconsin. 53121.
(414) 723-3434

Mapping date: May 3, 1990

Revisions: _____

Sheet 1 of 2 Sheets

Job reference number:

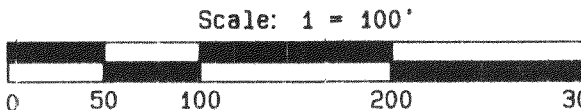

300 HRS 04/4 1990.047

416-685