


Lot 9 of Farm Village Subdivision, located in the SE $\frac{1}{4}$ of the SW $\frac{1}{4}$
and the SW $\frac{1}{4}$ of the SE $\frac{1}{4}$ and the SE $\frac{1}{4}$ of the SE $\frac{1}{4}$ of Section 25,
T4N, R16E, Walworth County, Wisconsin

I certify that I have Surveyed the above described property according to the recorded subdivision plat.
September 30, 1977

Revised:
June 25, 1990

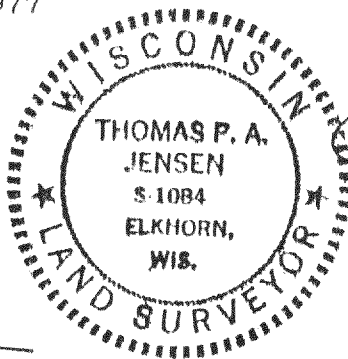

Thomas P.A. Jensen S-1084

Note; All lot corners monumented as required by Chapter 236 Wis. Statutes.
Zoning A-2.

Zoning yard requirements;

Rear	Min.	100	feet
Side	Min.	20	feet

Buildings housing animals must be 100 feet from lot lines. Subdivision minimum building setback line, 100 feet from streets.


Class (1) soils. Septic seepage area for the house must go in the boring area.

CURVE DATA

	Delta	Radius	Chord	Chord Bearing
(A)	55°54'00"	128.00	119.99	S60°50'23"W
(B)	4°57'24"	915.70	79.19	N74°31'37"W

LEGEND

- Found concrete monument
- Found iron pipe
- Found 1 3/16" iron rod
- Found 3/4" iron rod

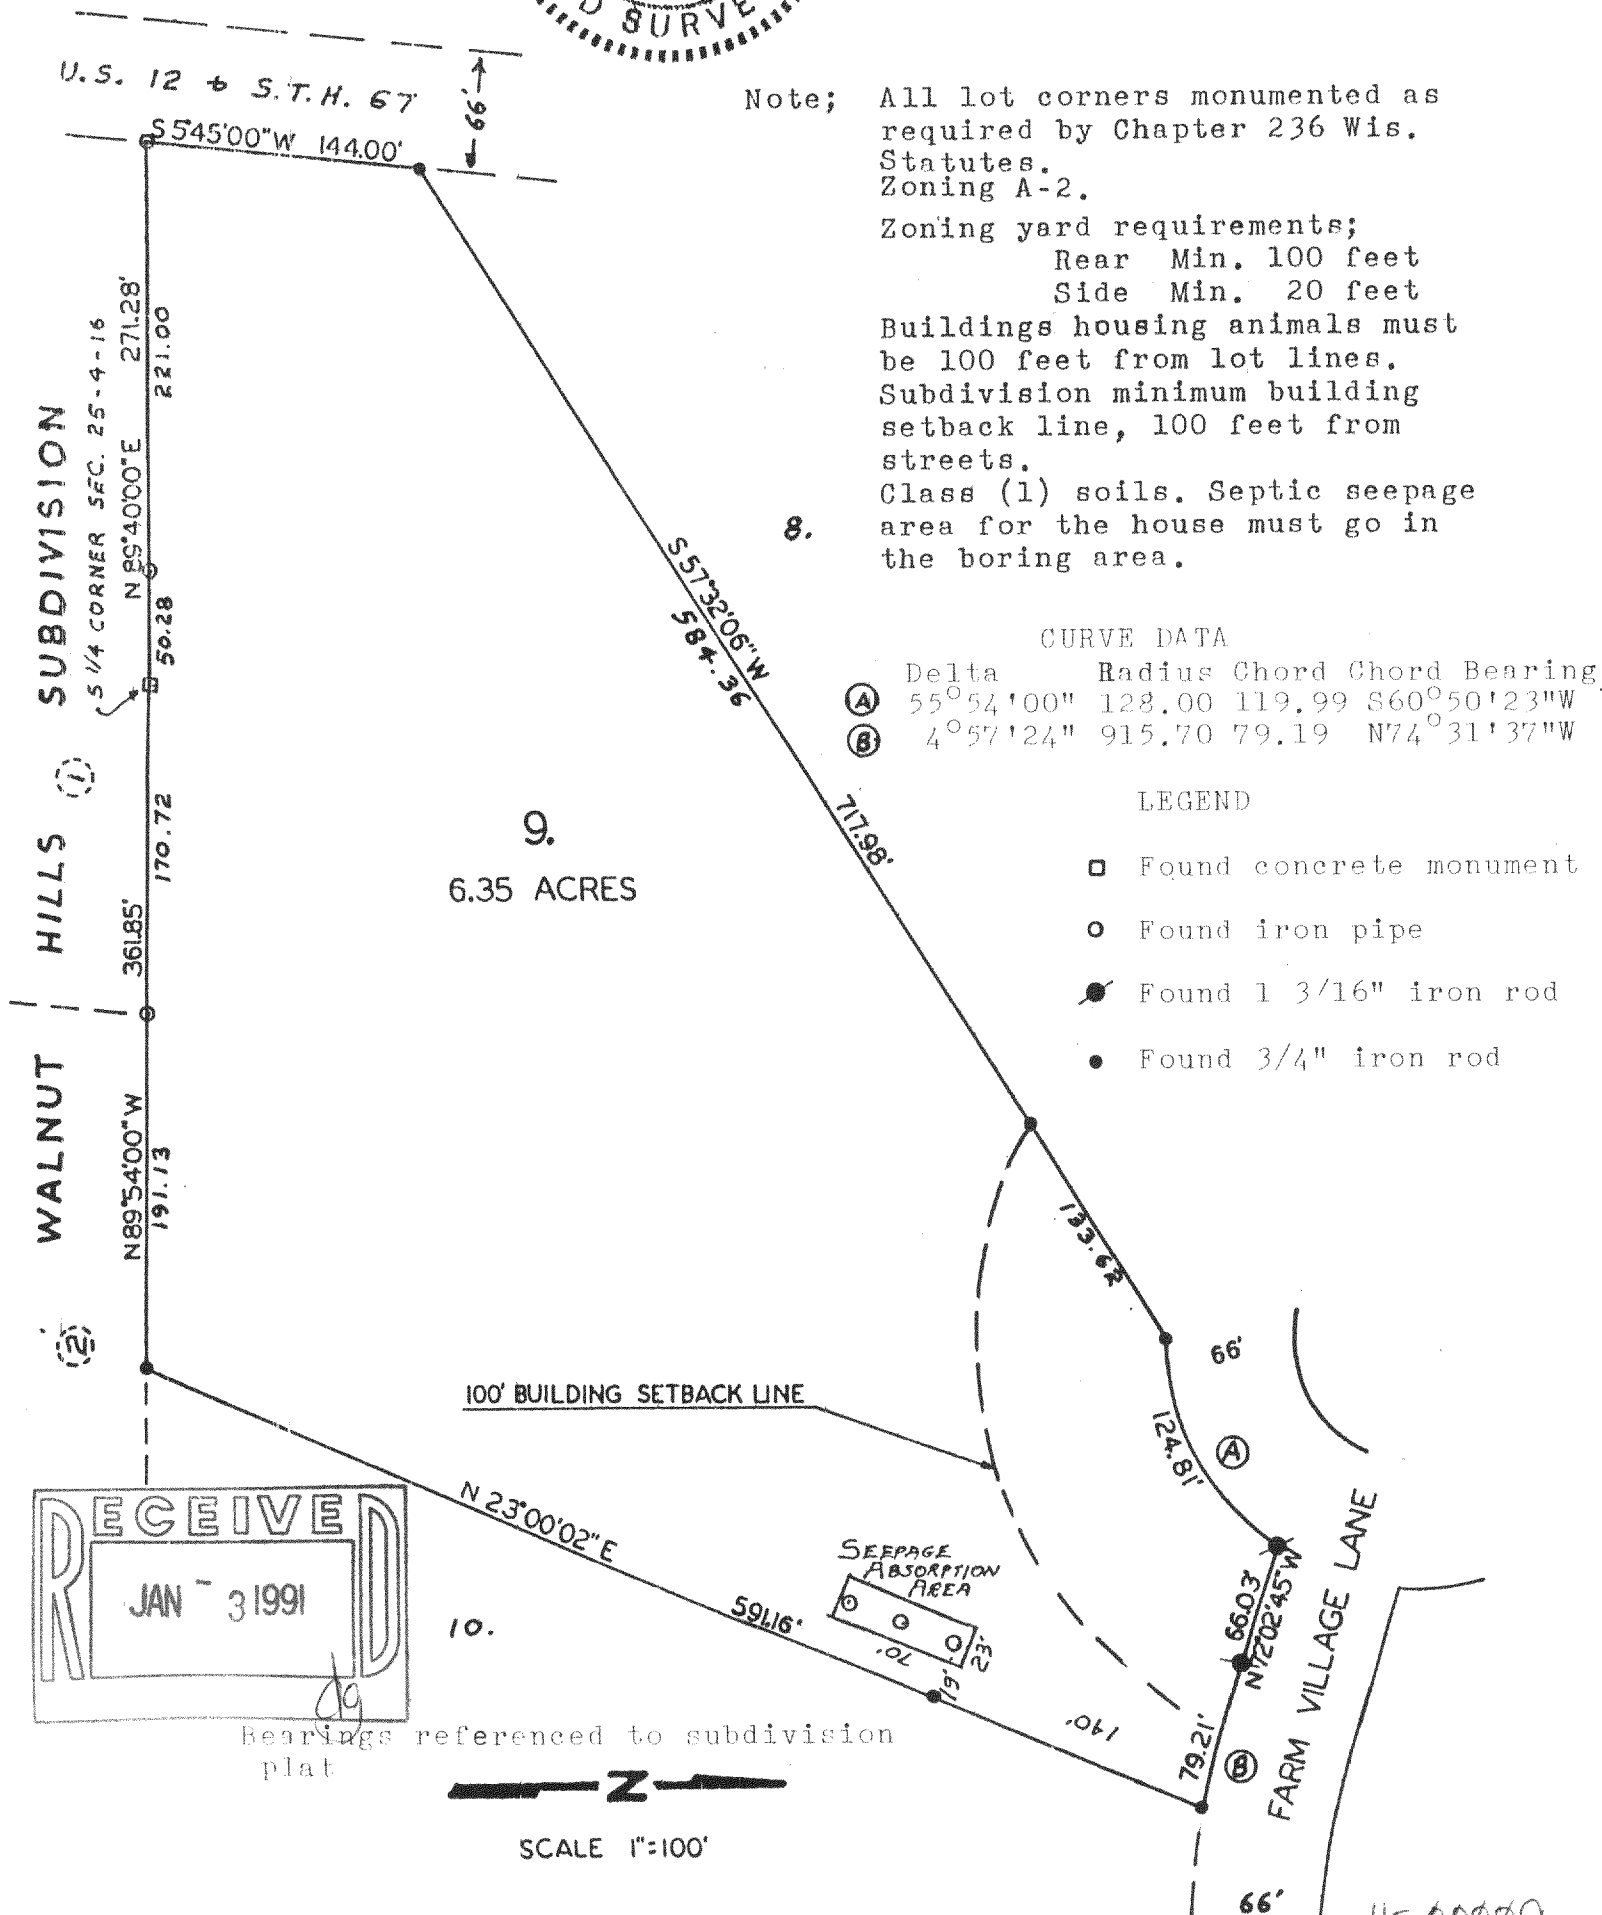

Bearings referenced to subdivision
plat

SCALE 1"=100'

HF 00009
1990.084

416-687