

PLAT OF SURVEY

Block 2 of Pebble Beach Subdivision
 Located in Sections 25 & 26, T.4N., R.16E.,
 Barrage Township, Walworth County, Wisconsin.

SURVEYED BY: Jensen Surveying & Mapping S.C.
 45 South Wisconsin Street
 Elkhorn, Wisconsin 53121
 (414) 723-3434

PREPARED BY: Tom Wellnitz
 1001 Highway 14
 Janesville, WI 53545


SCALE- 1" = 30'

Bearings are referenced to
 the recorded subdivision plat

Mapping Date: 10/04/90


SURVEY DATA TABLE (Recorded)

Line No.	Bearing	Dist.	Chd. Br.	Chd. Per.	Con. Ang.
1	N 34° 47' 05" E	220.00'	N 49° 53' 24" W	180° 00' 00"	180° 00' 00"
2	N 55° 44' 28" W	99.35'	N 55° 40' 12" W	180° 00' 00"	180° 00' 00"

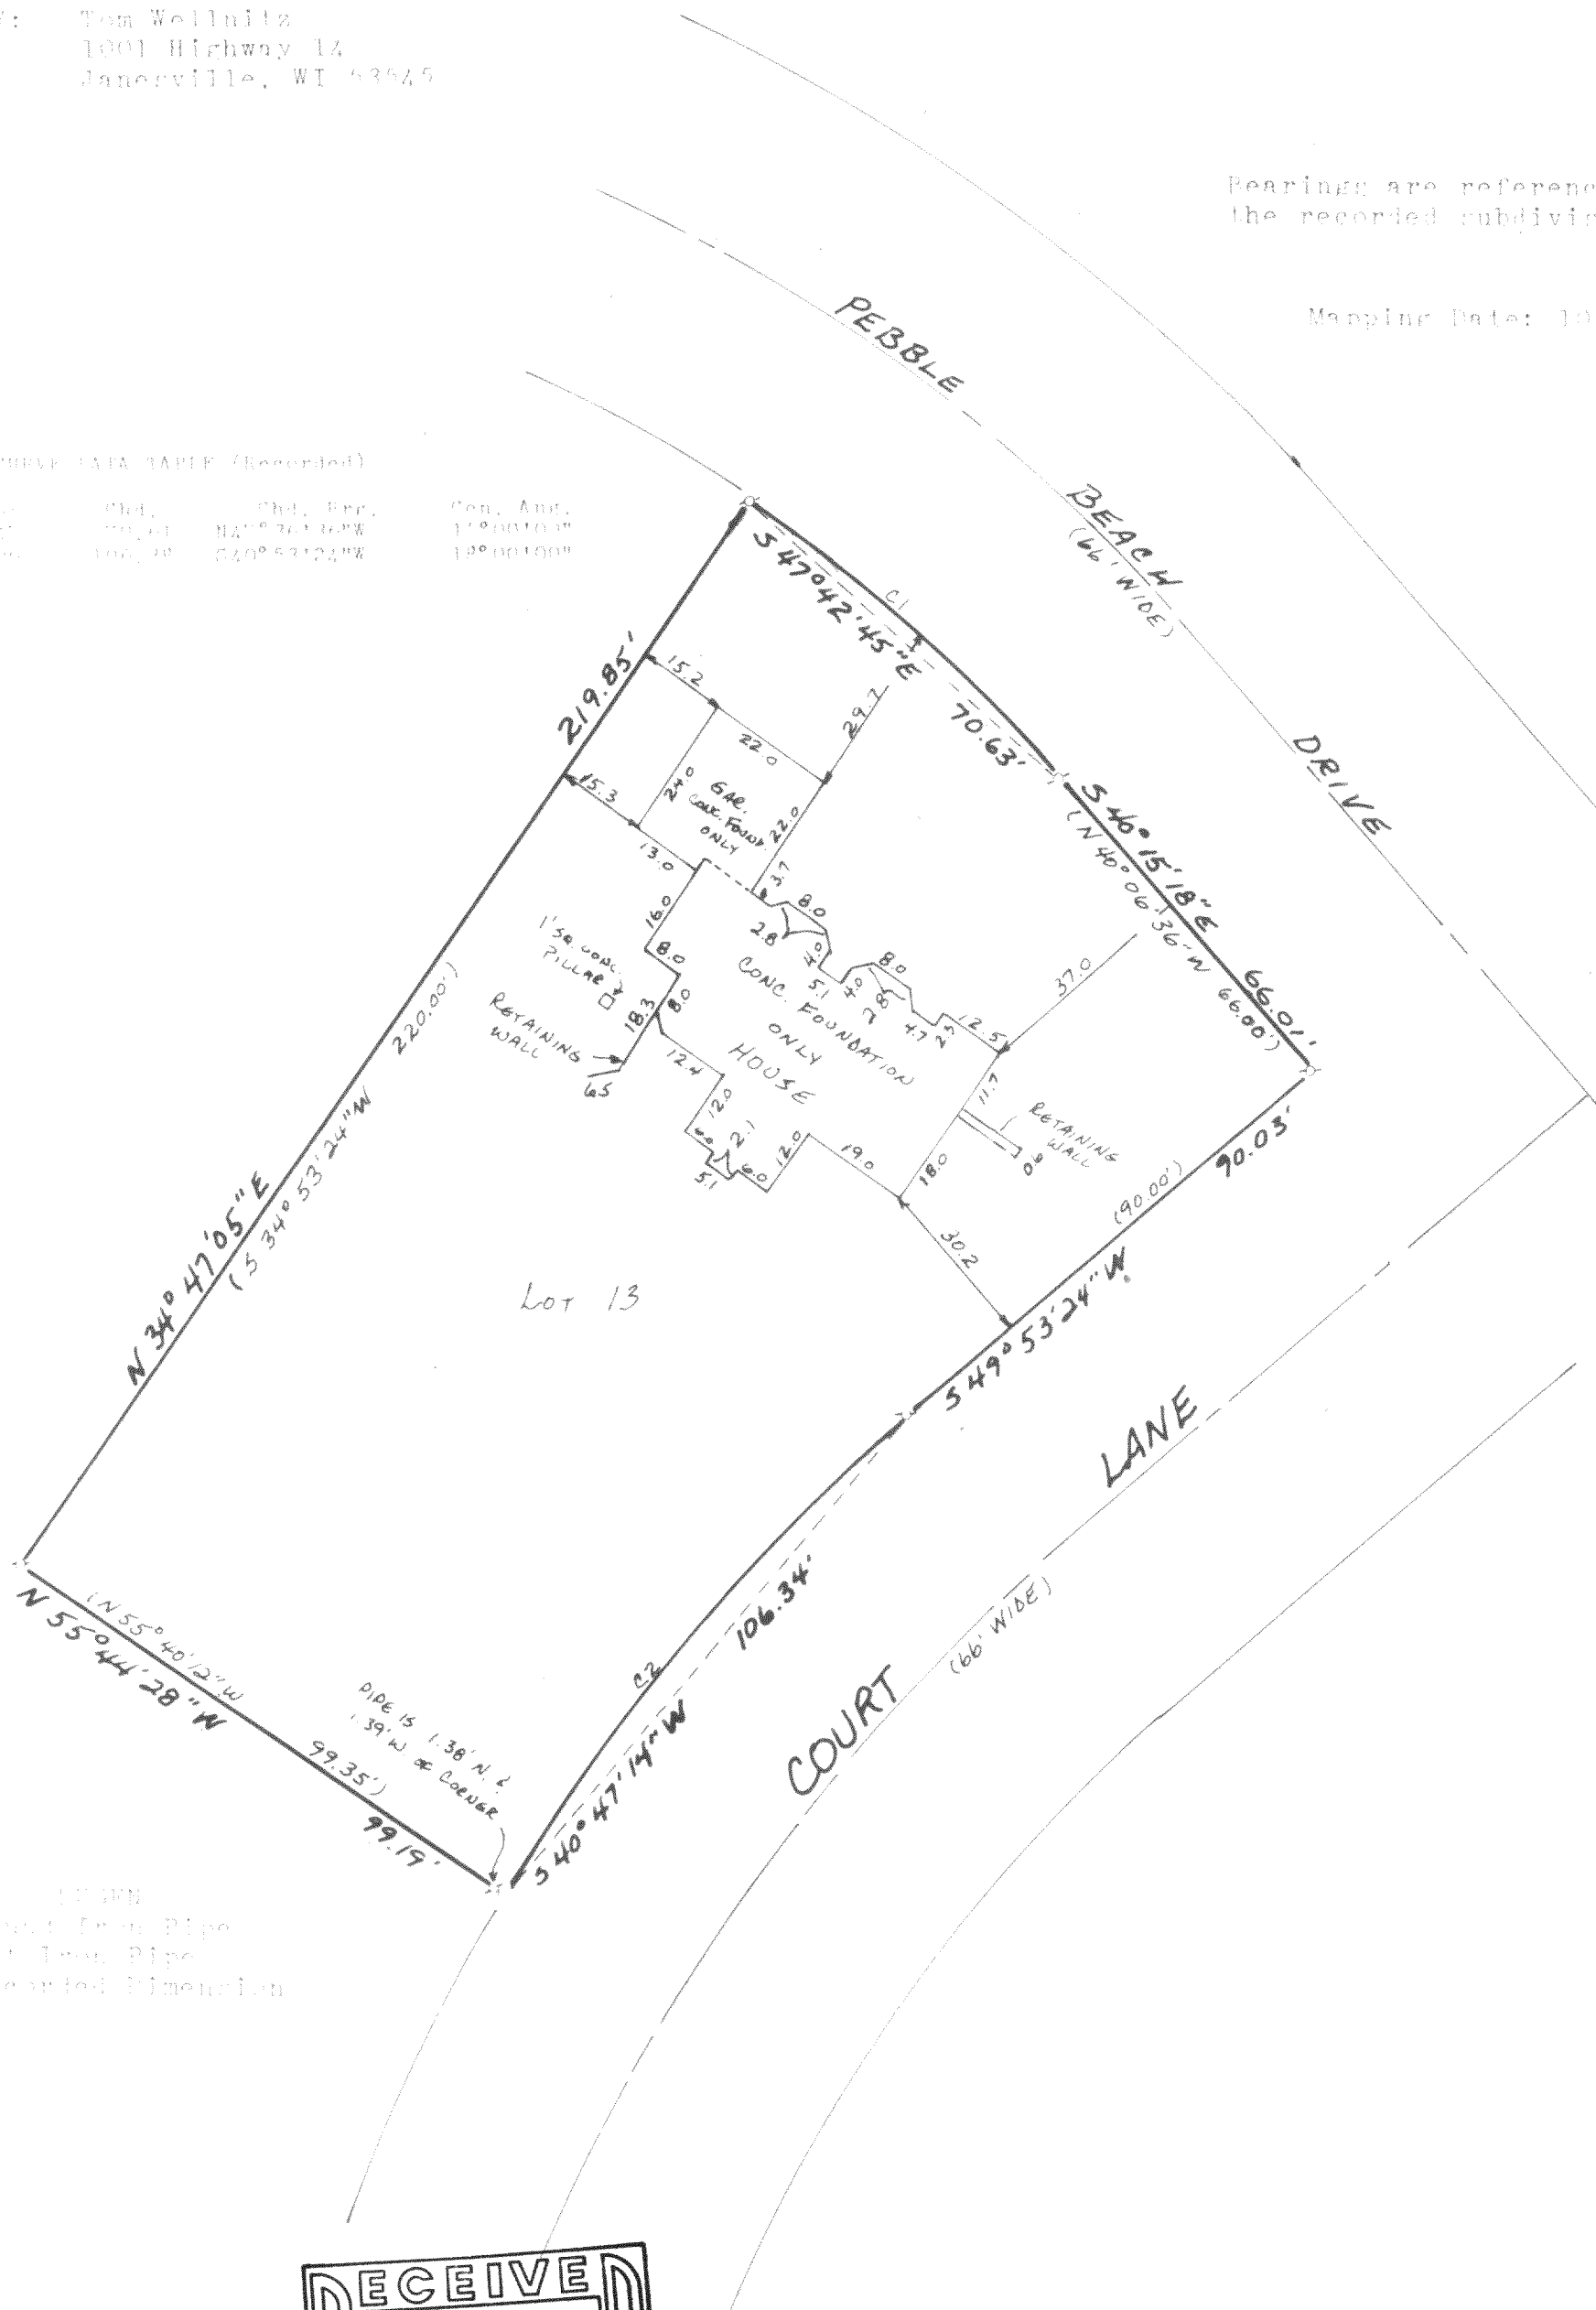

- 1" Iron Pipe
- 4" Iron Pipe
- () Recorded Dimension

Note: This survey plat is not
 certified unless signed
 and sealed in red ink.

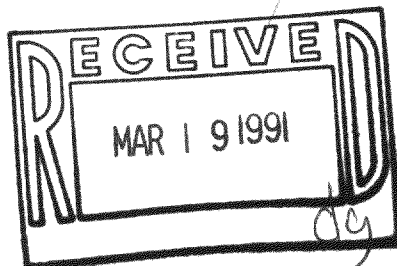

I, Thomas P.A. Jensen, Wisconsin Registered Land Surveyor,
 do hereby certify that this survey was performed by me, or under
 my direction, in full compliance with the owner's/agent's instru-
 ctions and Chapter 98.17 of the Wisconsin Administrative Code
 "Minimum Standards for Property Surveys"; and that this map is
 an accurate representation thereof to the best of my knowledge
 and belief.

Copyright © 1990 by Jensen Surveying & Mapping S.C.

All rights reserved. No part of this survey plat may be
 reproduced or transmitted in any form by any means - graphic,
 electronic, or mechanical, including photocopying, tracing, or
 information storage and retrieval systems without permission in
 writing from Thomas P.A. Jensen, Jensen Surveying & Mapping S.C.

Thomas P.A. Jensen R.L.S. 1084
 Jensen Surveying & Mapping S.C.