

Farris, Hansen & Associates, Inc.

7 RIDGEWAY COURT, P.O. BOX 437, ELKHORN, WISCONSIN

TEL. 414-723-2098

LOCATION: THE SOUTHWESTERLY 24 FEET OF LOT 10 AND ALL OF LOT 11, BLOCK NO. 2 IN GREEN LAKE PARK, A SUBDIVISION IN WALWORTH COUNTY, WISCONSIN, AS RECORDED IN VOL. 5 OF PLOTS, PAGE 58, TOWN OF LAGRANGE

WORK ORDERED BY:

JAMES SHAFFER

MAP LEGEND

- IRON PIPE STAKE FOUND
- IRON PIPE STAKE SET
- IRON ROD STAKE FOUND
- ⦿- IRON ROD STAKE SET
- CONCRETE MONUMENT FOUND

(XXXXX) = RECORD DIMENSION ORIG. PLAT
OR REED

MAP SCALE IN FEET




PLAT OF SURVEY OF

LANDS DESCRIBED IN
VOL. 331, PG. 256 DOC. 107343

TIPPLE → SHAFFER

REC. SEP. 20, 1984

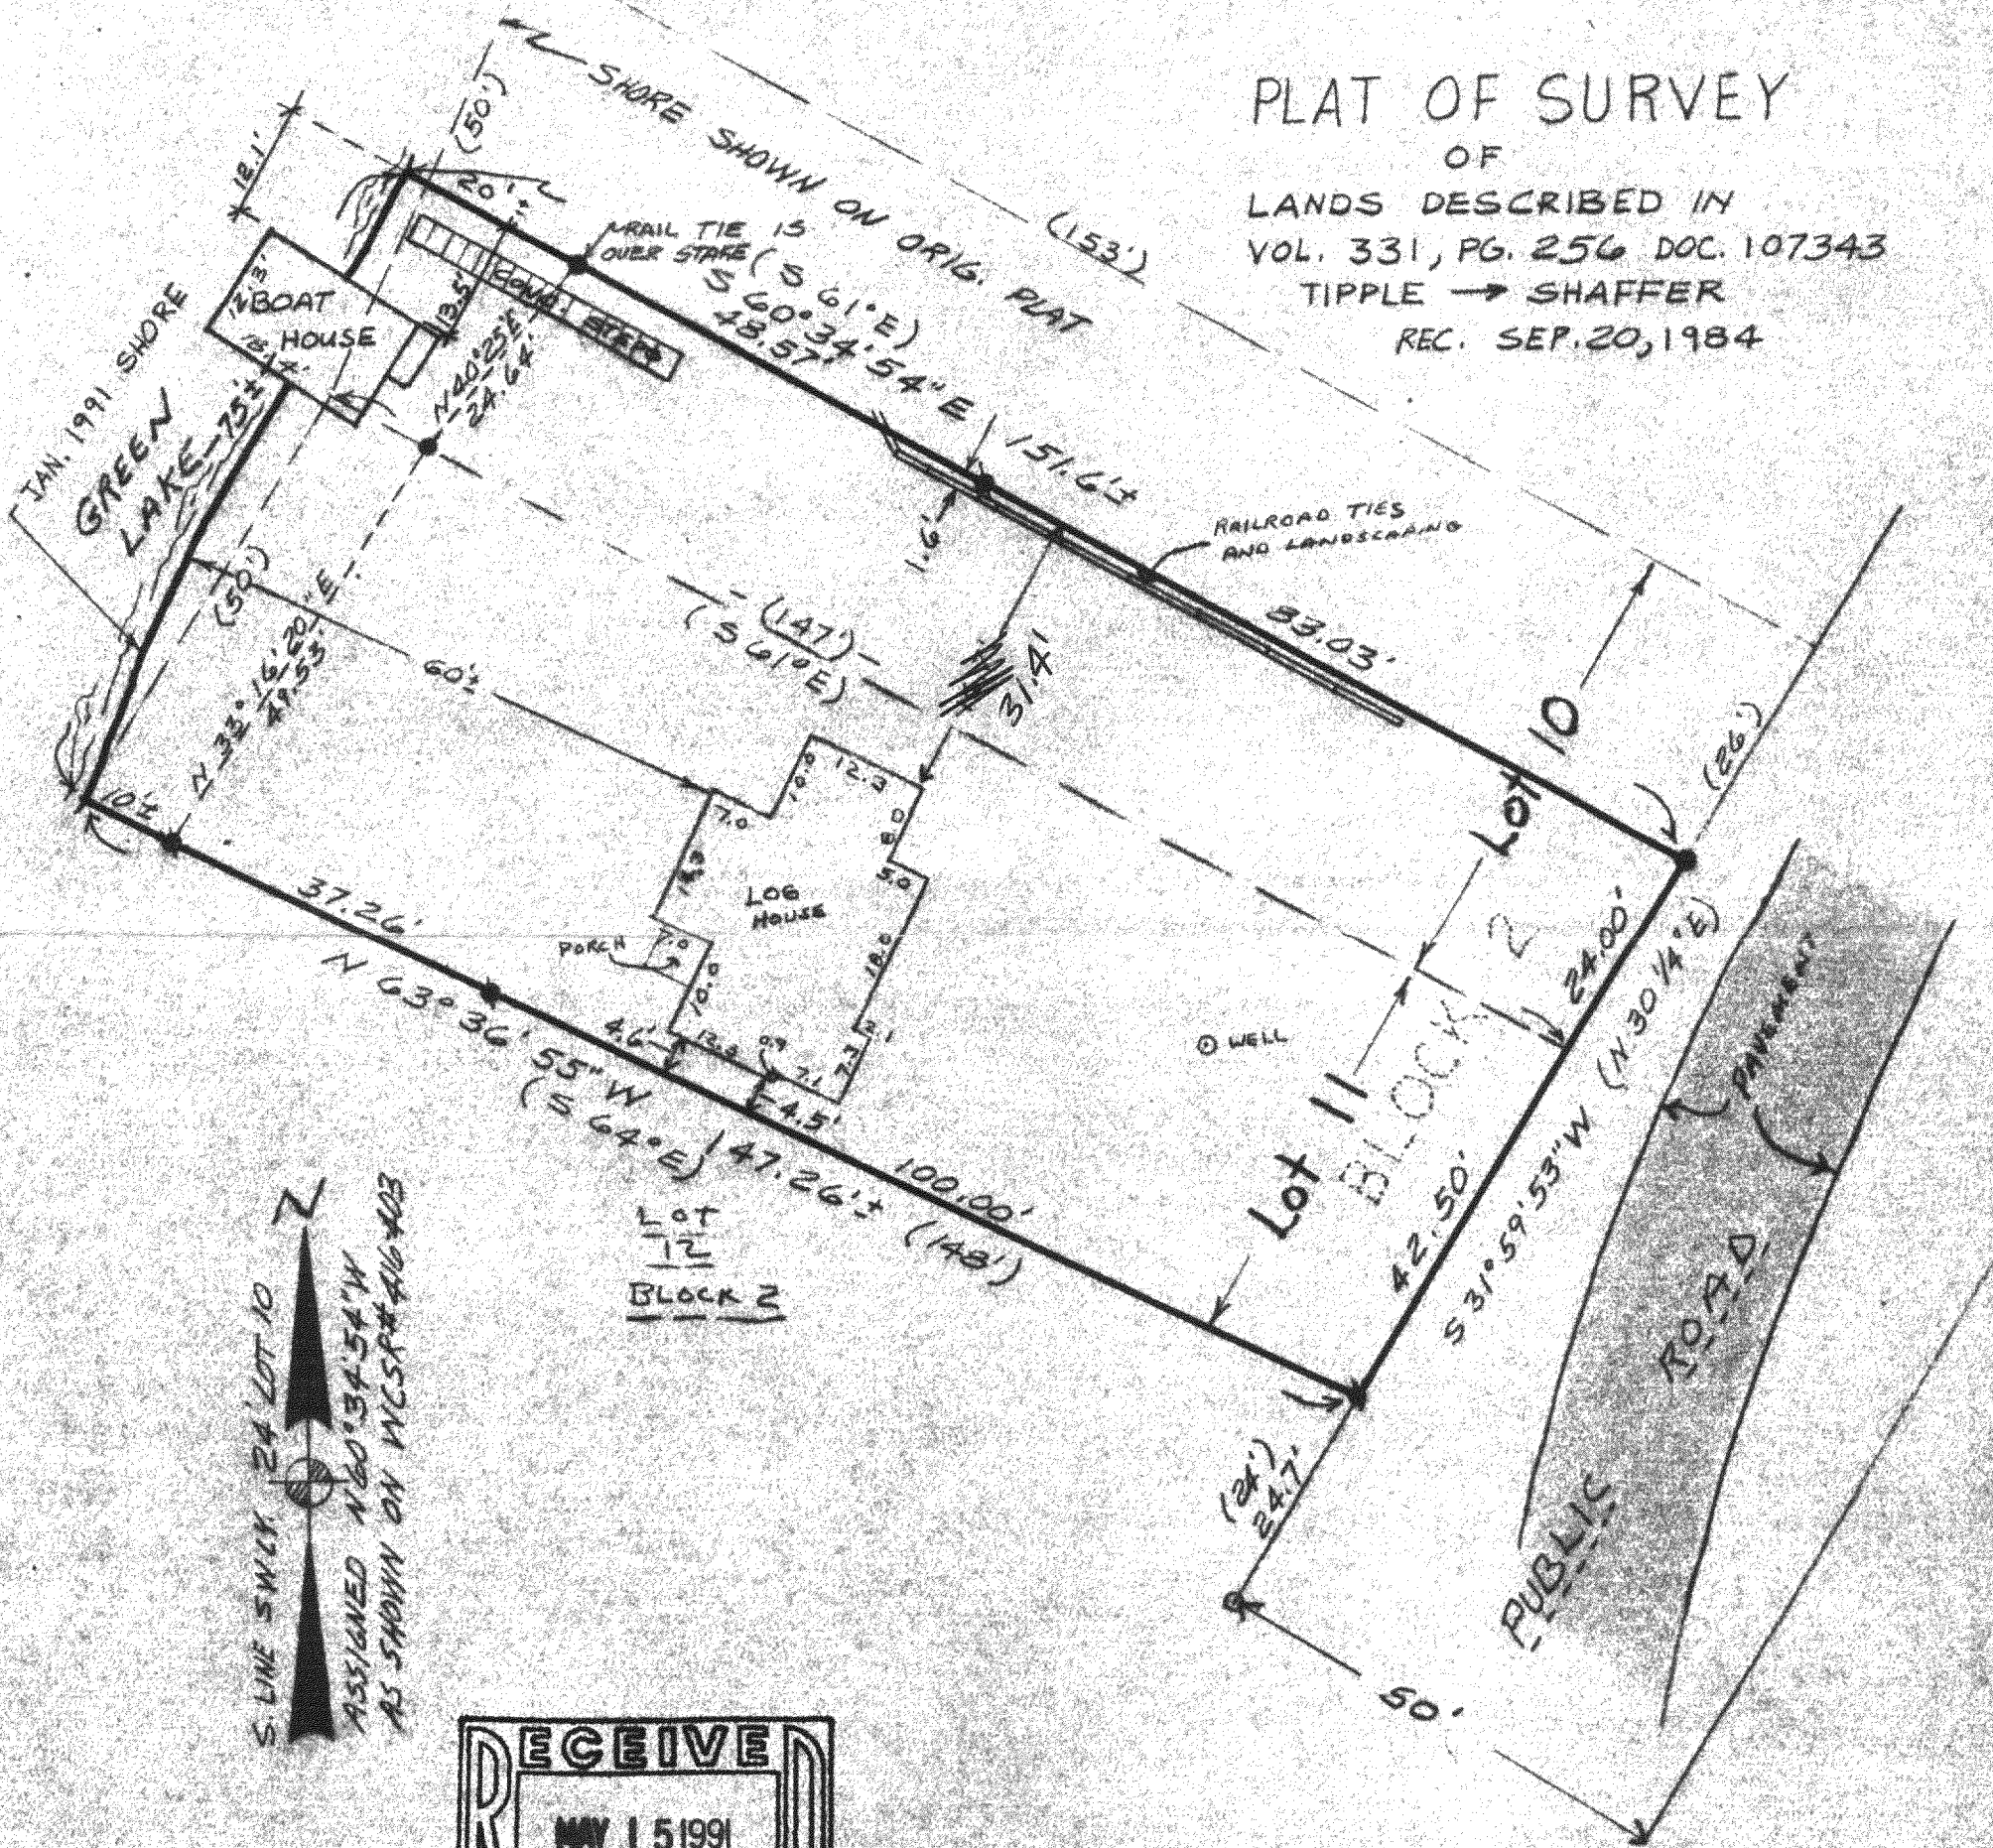

NOTE: COPIES OF THIS MAP TO WHICH THE FOLLOWING CERTIFICATE WILL APPLY ARE BLUE LINE PRINTS SHOWING SURVEYOR'S SEAL AND SIGNATURE IN BLACK INK. COPIES BY ANY OTHER MEANS MAY HAVE ALTERATIONS WHICH DO NOT REPRESENT THE SURVEYOR'S WORK PRODUCT.

I hereby certify that the above described property has been surveyed under my direction and that the above map is a true representation thereof and shows the size and location of the property, its exterior boundaries, the location of all visible structures and dimensions of all principal buildings thereon, boundary fences, apparent easements, roadways and visible encroachments, if any. This survey is made for the use of the present owners of the property, and also those who purchase, mortgage or guarantee the title thereto within one year from the date hereof.

DATED : JAN. 31, 1991

A circular seal for a Wisconsin Land Surveyor. The outer ring contains the text "WISCONSIN" at the top and "LAND SURVEYOR" at the bottom, separated by two five-pointed stars. The center of the seal contains the text "ROBERT A. FARRIS", "S-1293", "ELKHORN,", and "WIS." in a stacked arrangement. The seal has a dotted border.

PROJ. NO. 3436

416-716

HGP 00015