
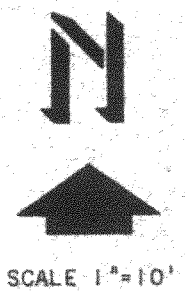


ABELL
SURVEYING & MAPPING
DELAVER, WISCONSIN 53115
414-728-6737

PLAT OF SURVEY OF

A PARCEL OF LAND LOCATED IN BLOCK 4 OF GREEN LAKE PARK SUBDIVISION WHICH IS LOCATED IN THE SOUTHWEST 1/4 OF SECTION 26, T4N, R16E, WALWORTH COUNTY, WISCONSIN, AS DESCRIBED IN VOL. 460 PAGE 546 AS DOCUMENT NO. 179731, TAX PARCEL NO. HGP-38.

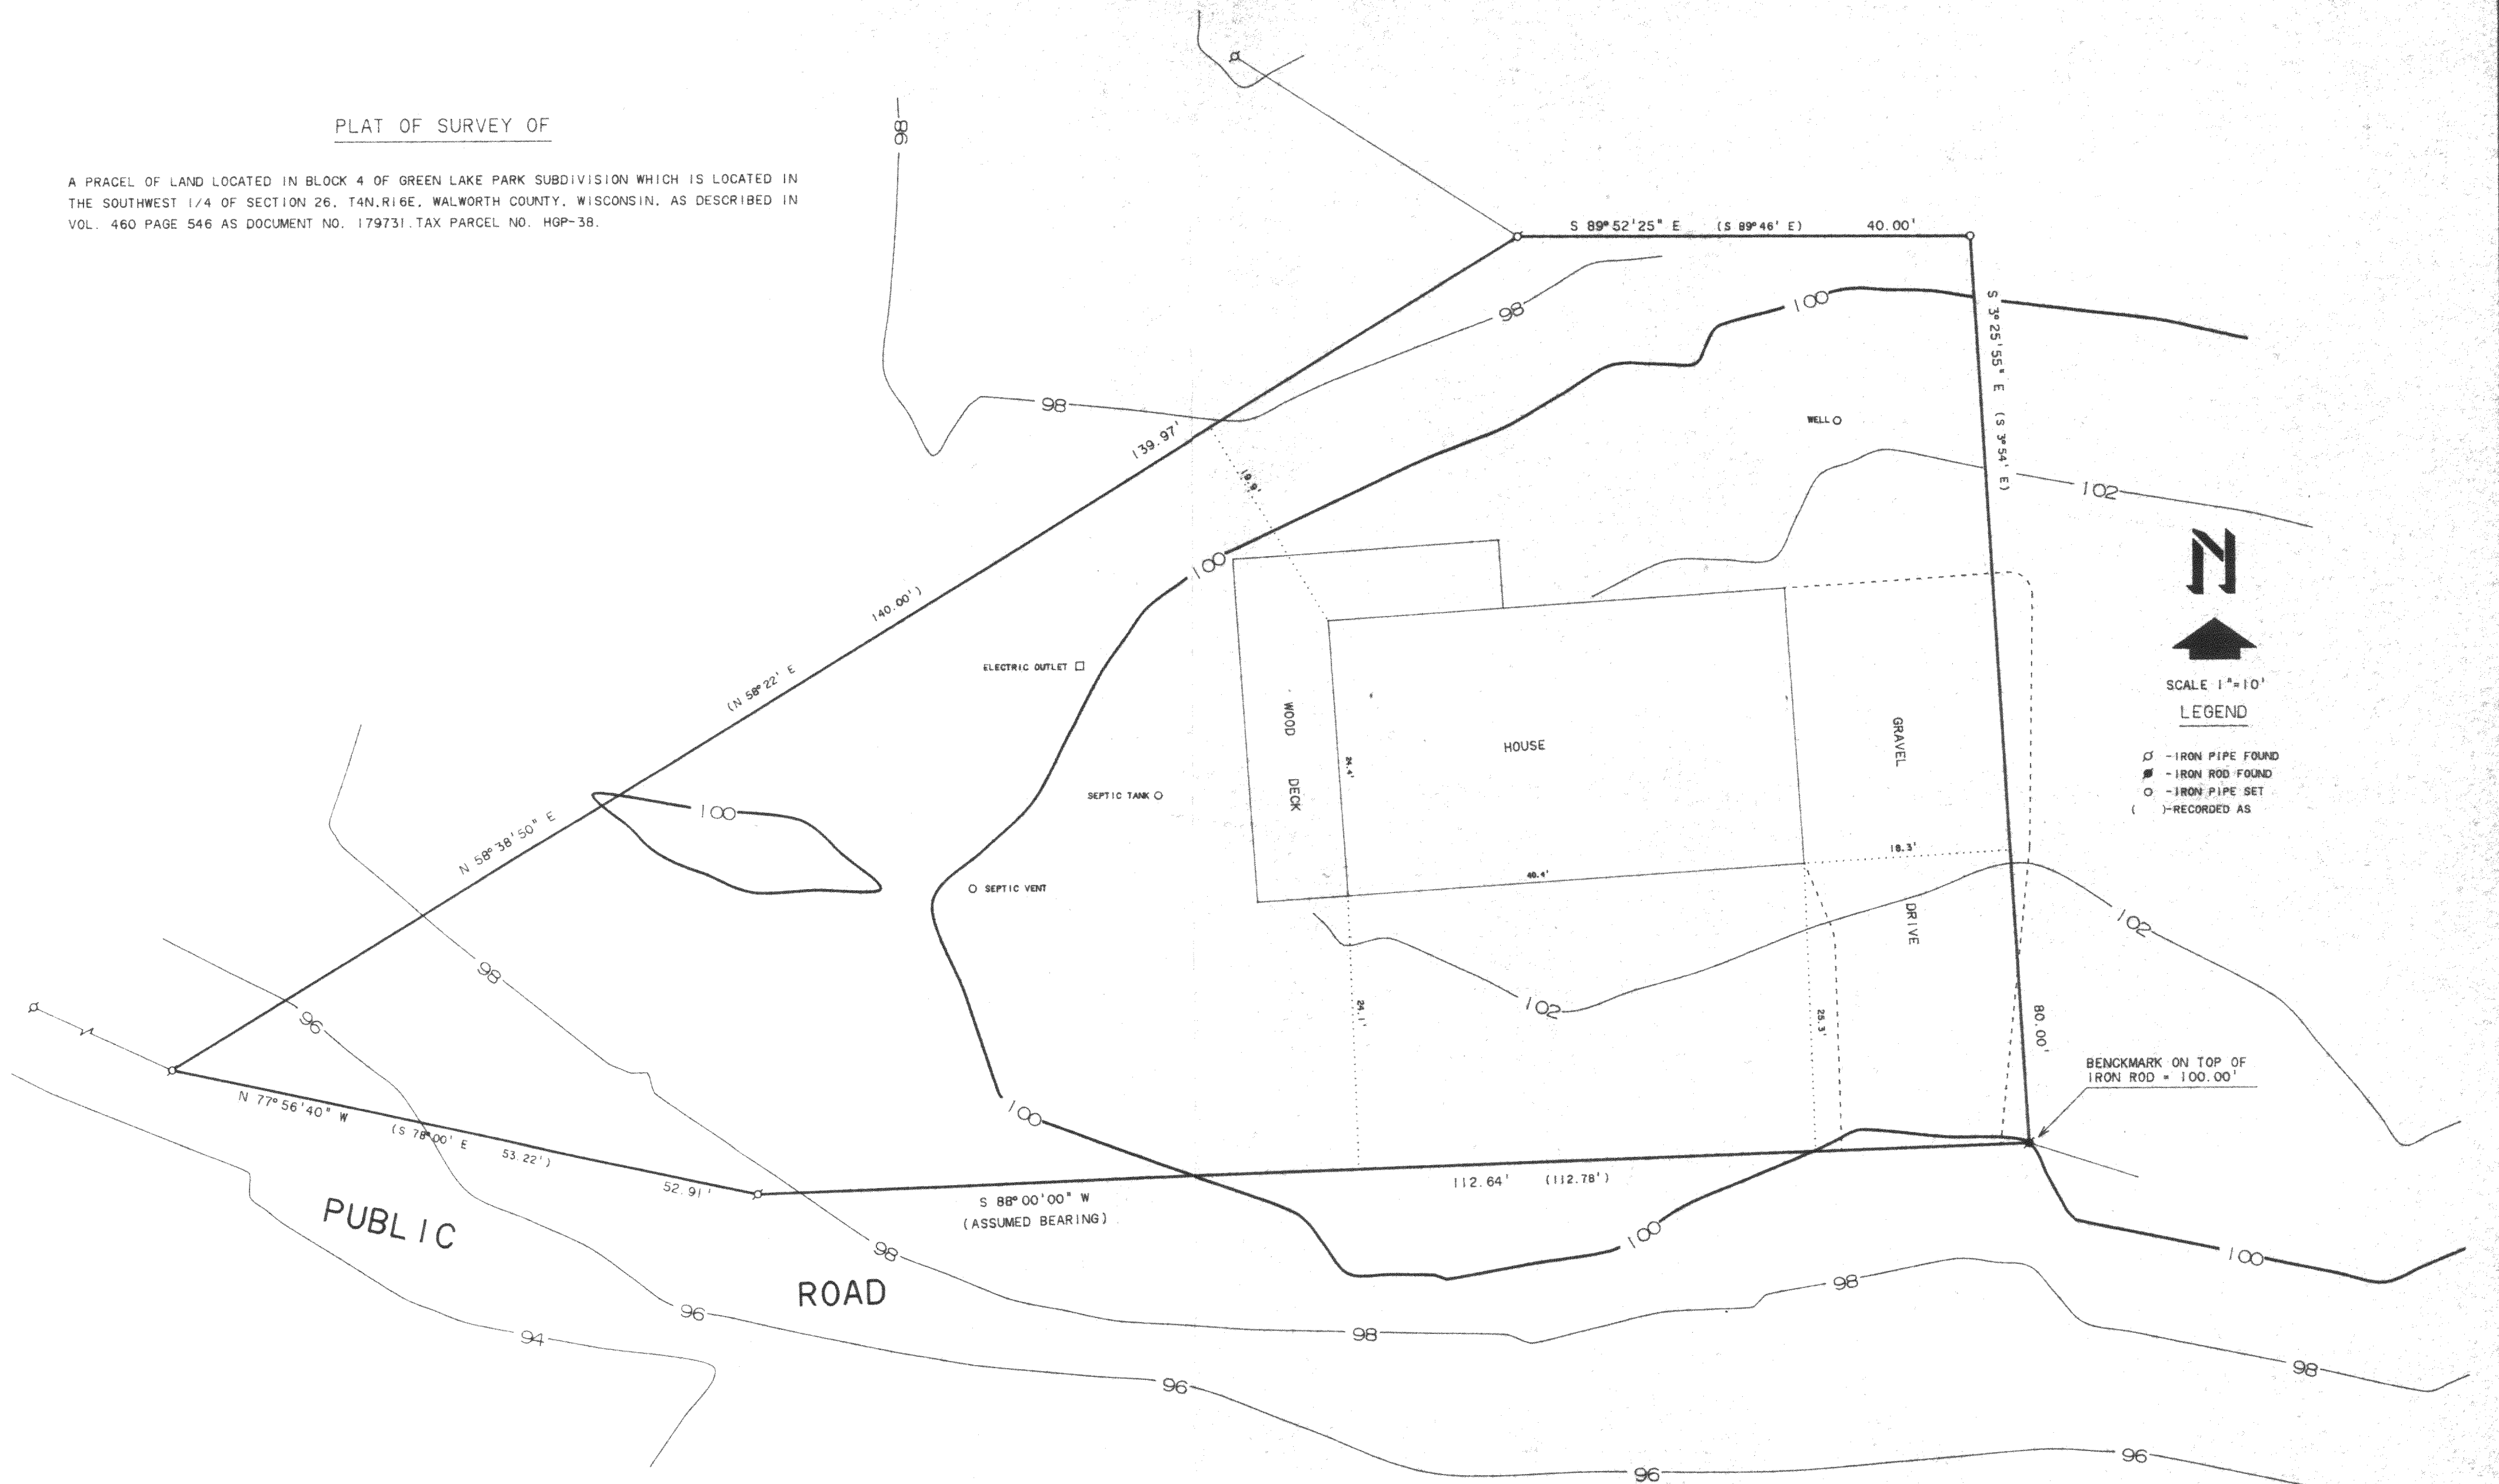


LEGEND

- - IRON PIPE FOUND
- - IRON ROD FOUND
- - IRON PIPE SET
- () - RECORDED AS

BENCHMARK ON TOP OF
IRON ROD = 100.00'

ORDERED BY: DON HANSEN
320 MARGATE TERRACE
DEERFIELD, IL. 60015

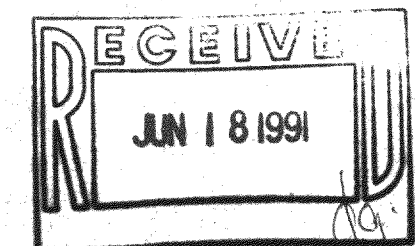

I, DAVID F. ABELL, DO HEREBY CERTIFY THAT I HAVE SURVEYED THE PROPERTY HEREON DESCRIBED ACCORDING TO THE OFFICAL RECORDS AND THAT THE PLAT HEREON IS A CORRECT REPRESENTATION OF THE PROPERTY LINES TO THE BEST OF MY KNOWLEDGE AND BELIEF.

David F. Abell
DAVID F. ABELL
WISCONSIN REGISTERED LAND SURVEYOR, S-1596

March 25, 1991
DATE JOB NUMBER - 91039
NOTE: THIS IS NOT A CERTIFIED COPY UNLESS SEALED.