


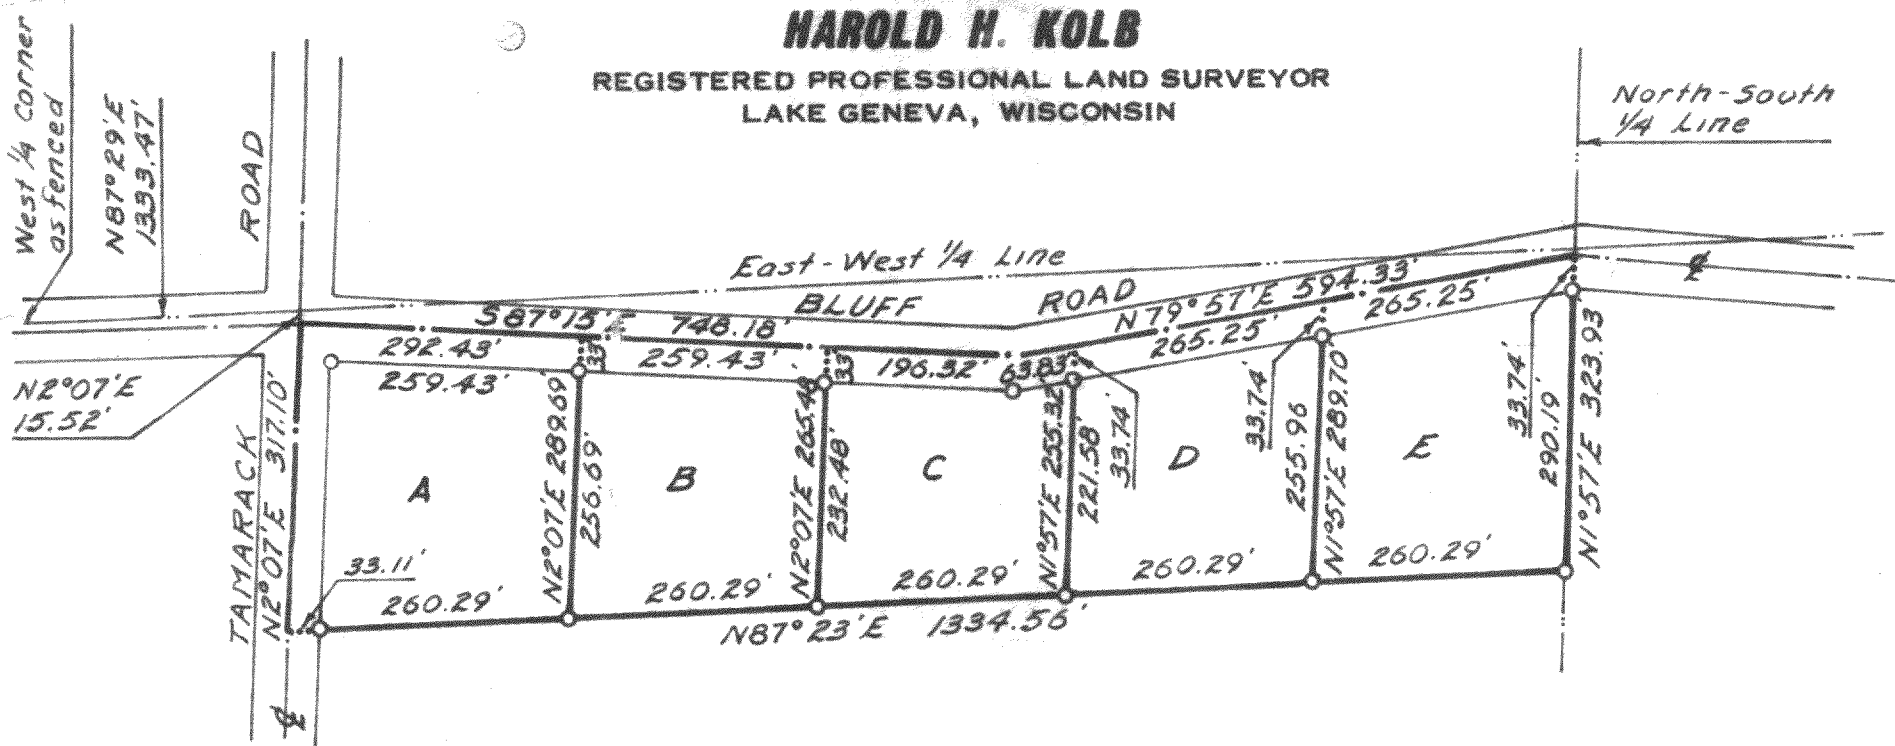

Plat of Survey of

Five parcels of land located in the Northeast 1/4 of the Southwest 1/4 of Section 2, T 4 N, R 16 E, Walworth County, Wisconsin and described as follows; towit:

Parcel A

Commencing at the West 1/4 corner of said Section 2, as fenced; thence N 87° 29' E 1333.47 feet; thence S 2° 07' W 15.52 feet to the place of beginning; thence S 87° 15' E 292.43 feet; thence S 2° 07' W 289.69 feet; thence S 87° 23' W 293.40 feet; thence N 2° 07' E 317.10 feet to the place of beginning.

Containing 2.04 acres.

Parcel B

Commencing at the West 1/4 corner of said Section 2, as fenced; thence N 87° 29' E 1333.47 feet; thence S 2° 07' W 15.52 feet; thence S 87° 15' E 292.43 feet to the place of beginning; thence continue S 87° 15' E 259.43 feet; thence S 2° 07' W 265.48 feet; thence S 87° 23' W 260.29 feet; thence N 2° 07' E 289.69 feet to the place of beginning.

Containing 1.65 acres.

Parcel C

Commencing at the West 1/4 corner of said Section 2, as fenced; thence N 87° 29' E 1333.47 feet; thence S 2° 07' W 15.52 feet; thence S 87° 15' E 551.86 feet to the place of beginning; thence continue S 87° 15' E 196.32 feet; thence N 79° 57' E 63.83 feet; thence S 1° 57' W 255.32 feet; thence S 87° 23' W 260.29 feet; thence N 2° 07' E 265.48 feet to the place of beginning.

Containing 1.52 acres.

Parcel D

Commencing at the West 1/4 corner of said Section 2, as fenced; thence N 87° 29' E 1333.47 feet; thence S 2° 07' W 15.52 feet; thence S 87° 15' E 748.18 feet; thence N 79° 57' E 63.83 feet to the place of beginning; thence continue N 79° 57' E 265.25 feet; thence S 1° 57' W 289.70 feet; thence S 87° 23' W 260.29 feet; thence N 1° 57' E 255.32 feet to the place of beginning.

Containing 1.62 acres.

Parcel E


Commencing at the West 1/4 corner of said Section 2, as fenced; thence N 87° 29' E 1333.47 feet; thence S 2° 07' W 15.52 feet; thence S 87° 15' E 748.18 feet; thence N 79° 57' E 329.08 feet to the place of beginning; thence continue N 79° 57' E 265.25 feet; thence S 1° 57' W 323.93 feet; thence S 87° 23' W 260.29 feet; thence N 1° 57' E 289.70 feet to the place of beginning.

Containing 1.83 acres.

N
↑
SCALE: 1" = 200'

LEGEND

- ⊕ - IRON PIPE FOUND
- - IRON PIPE PLACED
- - CONCRETE MONUMENT
- x - SPIKE

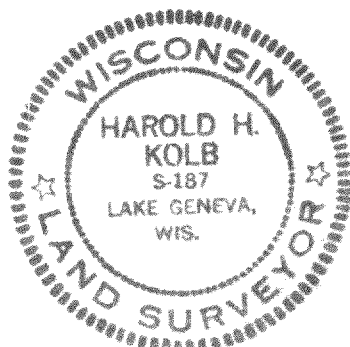

I, HAROLD H. KOLB, DO HEREBY CERTIFY THAT I HAVE SURVEYED THE PROPERTY HEREON DESCRIBED ACCORDING TO THE OFFICIAL RECORDS, AND THAT THE PLAT HEREON IS A CORRECT REPRESENTATION OF THE LOT LINES.

Harold H. Kolb

HAROLD H. KOLB
WISCONSIN REGISTERED LAND SURVEYOR, S-187
DATE August 4, 1969

416-24A2, 4A3
C 5 84

416-744