



PLAT OF SURVEY

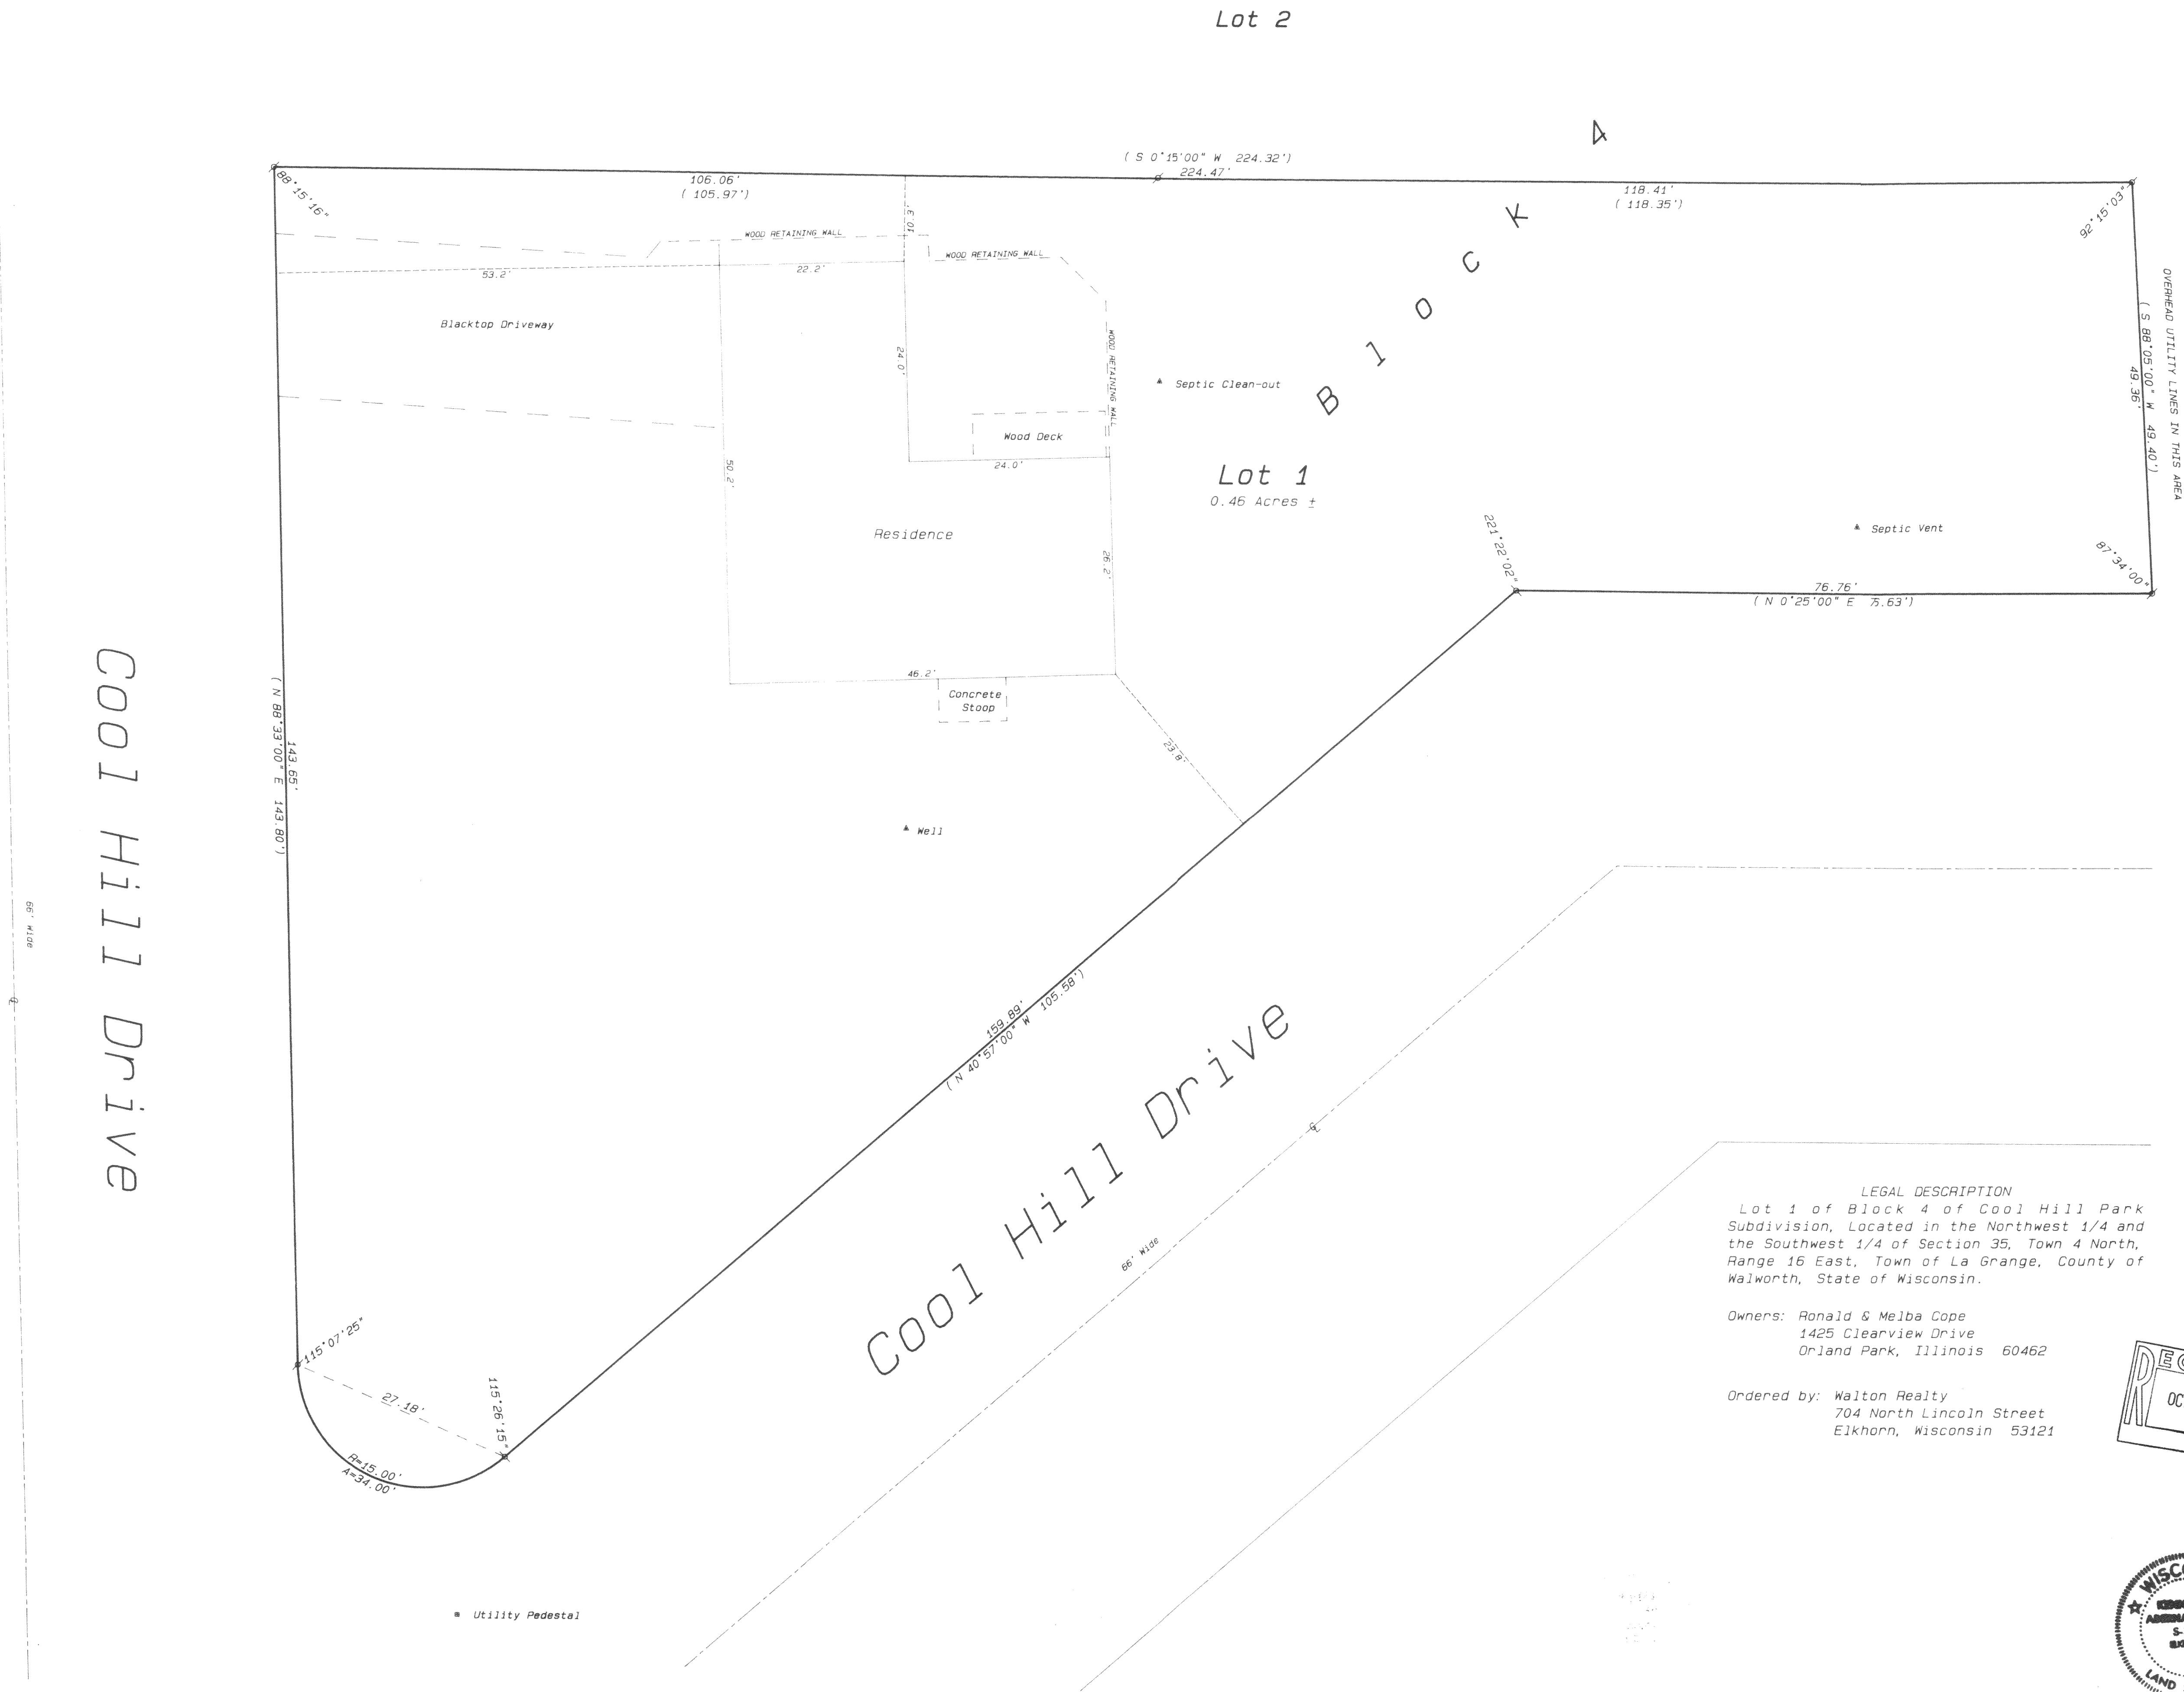

LEGAL DESCRIPTION
Lot 1 of Block 4 of Cool Hill Park
Subdivision, Located in the Northwest 1/4 and
the Southwest 1/4 of Section 35, Town 4 North,
Range 16 East, Town of La Grange, County of
Walworth, State of Wisconsin.


Owners: Ronald & Melba Cope
1425 Clearview Drive
Orland Park, Illinois 60462

Ordered by: Walton Realty
704 North Lincoln Street
Elkhorn, Wisconsin 53121

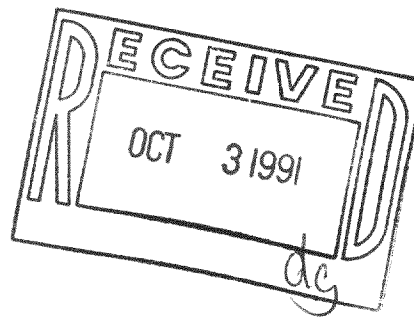

- Legend
- FOUND IRON PIPE
 - FOUND IRON ROD
 - FOUND BRASS-CAPPED MONUMENT
 - FOUND CONCRETE MONUMENT
 - CHISEL CUT IN CONCRETE
 - SET IRON ROD, 34" LONG, WEIGHING 1.5 LBS./LINEAL FT., 3/8" DIA.
 - SET IRON ROD, 30" LONG, WEIGHING 4.5 LBS./LINEAL FT., 1-11/16" DIA.
 - RECORDED AS DIMENSION
 - EXISTING FENCE

SCALE: 1"= 10 FEET

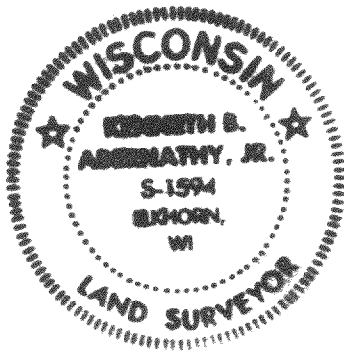

"I hereby certify that I have surveyed the above described property and that the above map is a true representation thereof and shows the size and location of the property, its exterior boundaries, the location of all visible structures and dimensions of all principal buildings thereon, boundary fences, apparent easements, roadways and visible encroachments, if any."

"This survey is made for the use of the present owners of the property, and also those who purchase, mortgage, or guarantee the title thereto within one year from date hereof."

Kenneth B. Abernathy, Jr.

KENNETH B. ABERNATHY, JR.
WISCONSIN REGISTERED LAND SURVEYOR,
S-1594

Date: August 26, 1994 Job No. 1991.814