


Plat of Survey

of



LOT 8 OF CLOVERLEAF ACRES, A SUBDIVISION LOCATED IN THE SW 1/4 OF THE NW
1/4 OF SECTION 18, T 4 N, R 16 E, WALWORTH COUNTY, WISCONSIN

Surveyed for: EGNOSKI CONSTRUCTION
377 ANN ST.
WHITEWATER, WI 53190

BEARINGS REFERENCED TO
THE SUBDIVISION PLAT

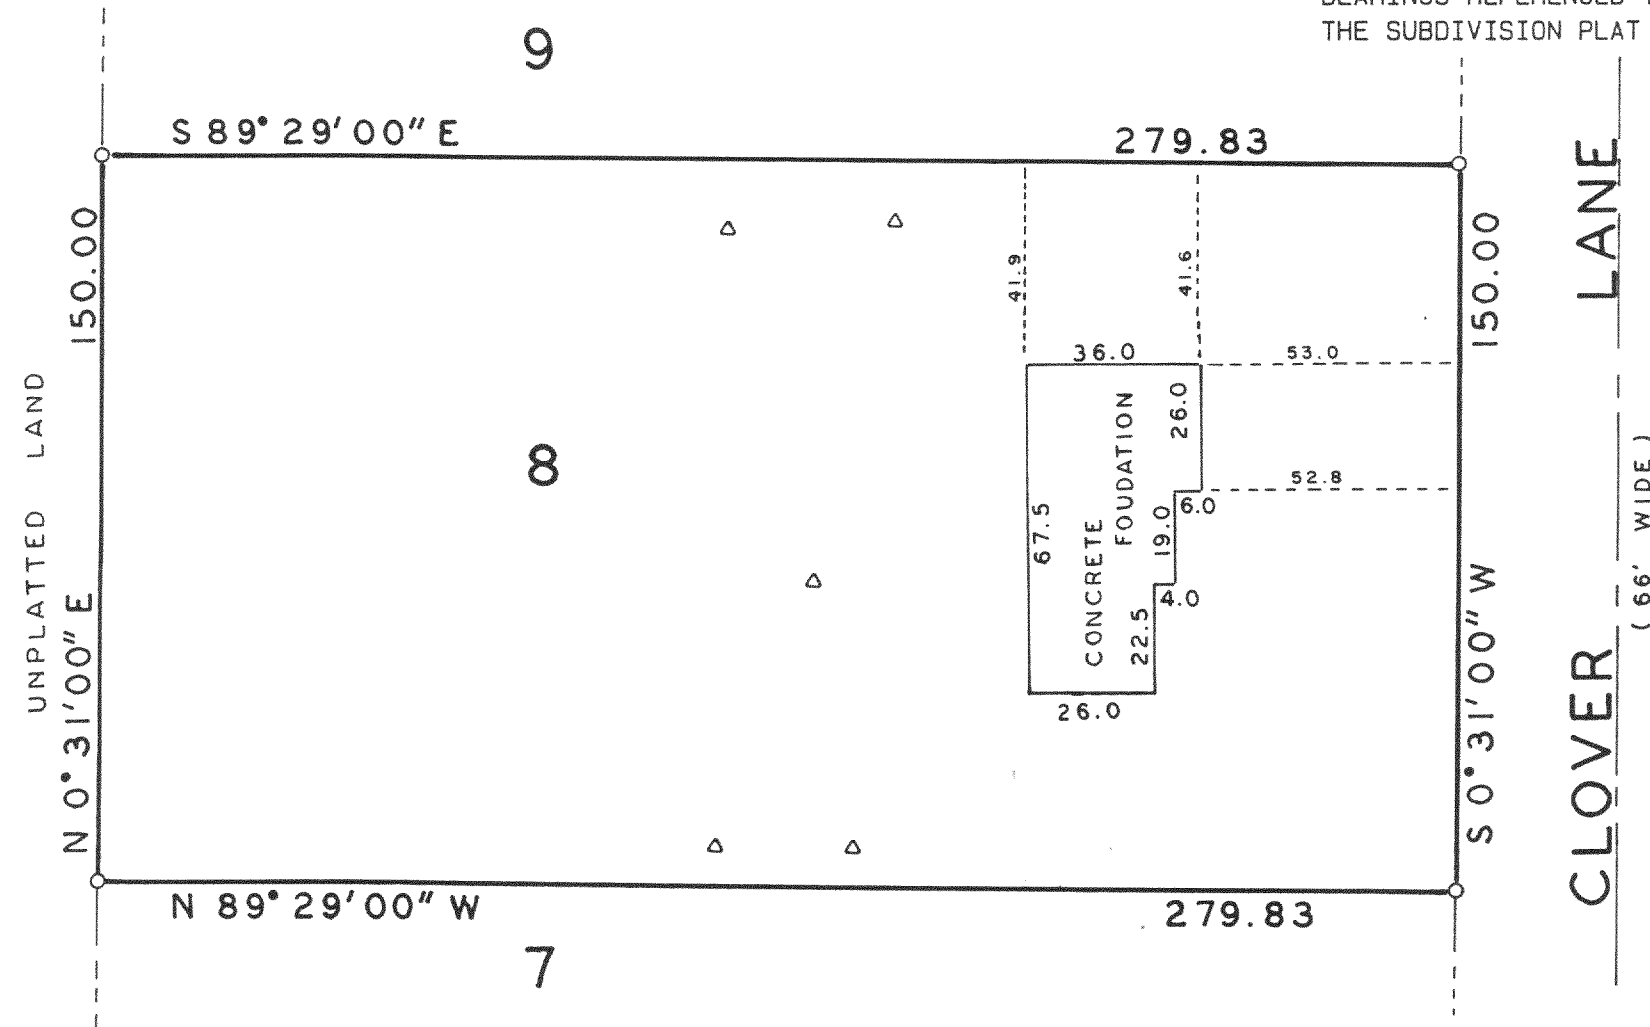

CLOVER LANE
(66' WIDE)

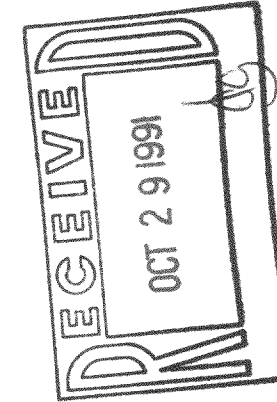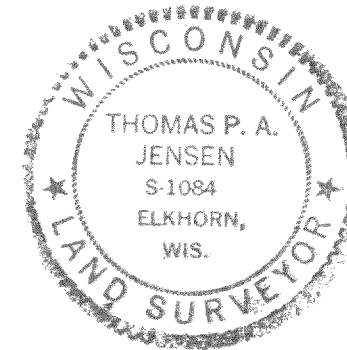

Copyright © 1991 by Jensen Surveying & Mapping S.C.

All rights reserved. No part of this survey plat may be reproduced or transmitted in any form by any means - graphic, electronic, or mechanical, including photocopying, tracing, or information storage and retrieval systems - without permission in writing from Thomas P.A. Jensen.

I, Thomas P.A. Jensen, Wisconsin Registered Land Surveyor, do hereby certify that this survey was performed by me, or under my direction, in full compliance with the owner's/agent's instructions and Chapter A-E 7 of the Wisconsin Administrative Code ' Minimum Standards For Property Surveys ', and that this map is an accurate representation thereof to the best of my knowledge and belief.

Note: This survey plat is not
certified unless signed
and sealed in red ink.

Thomas P.A. Jensen
Thomas P.A. Jensen R.L.S. 1084


Legend

- Found iron pipe, 1" dia.
- Wood stake set by builder

stakes

- △ Soil boring

Scale: 1" = 40'

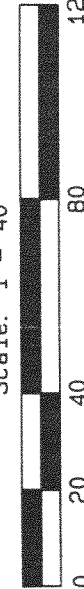

Sheet 1 of 1 Sheets

Job reference number:

1991.148 *416-756*

Jensen Surveying & Mapping S.C.

45 South Wisconsin Street P.O. Box 322
Elkhorn, Wisconsin. 53121.

(414) 723-3434

Mapping date: AUGUST 26, 1991

Revisions: OCTOBER 2, 1991