



# Plat of Survey

LOT 58 - 1ST ADDITION TO BUBBLING SPRINGS SUBDIVISION LOCATED IN THE SE 1/4 OF SECTION 34 AND IN THE SW 1/4 AND NW 1/4 OF SECTION 35, T 4 N, R 16 E WALWORTH COUNTY, WISCONSIN

Surveyed for: JAMES SENDT  
RT 1 BOX 448M  
ELKHORN, WI 53121

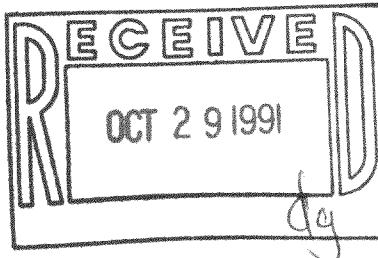


BEARINGS REFERENCE TO THE SOUTH LINE OF RIDGE ROAD RECORDED AS N45°18'E IN THE SUBDIVISION PLAT

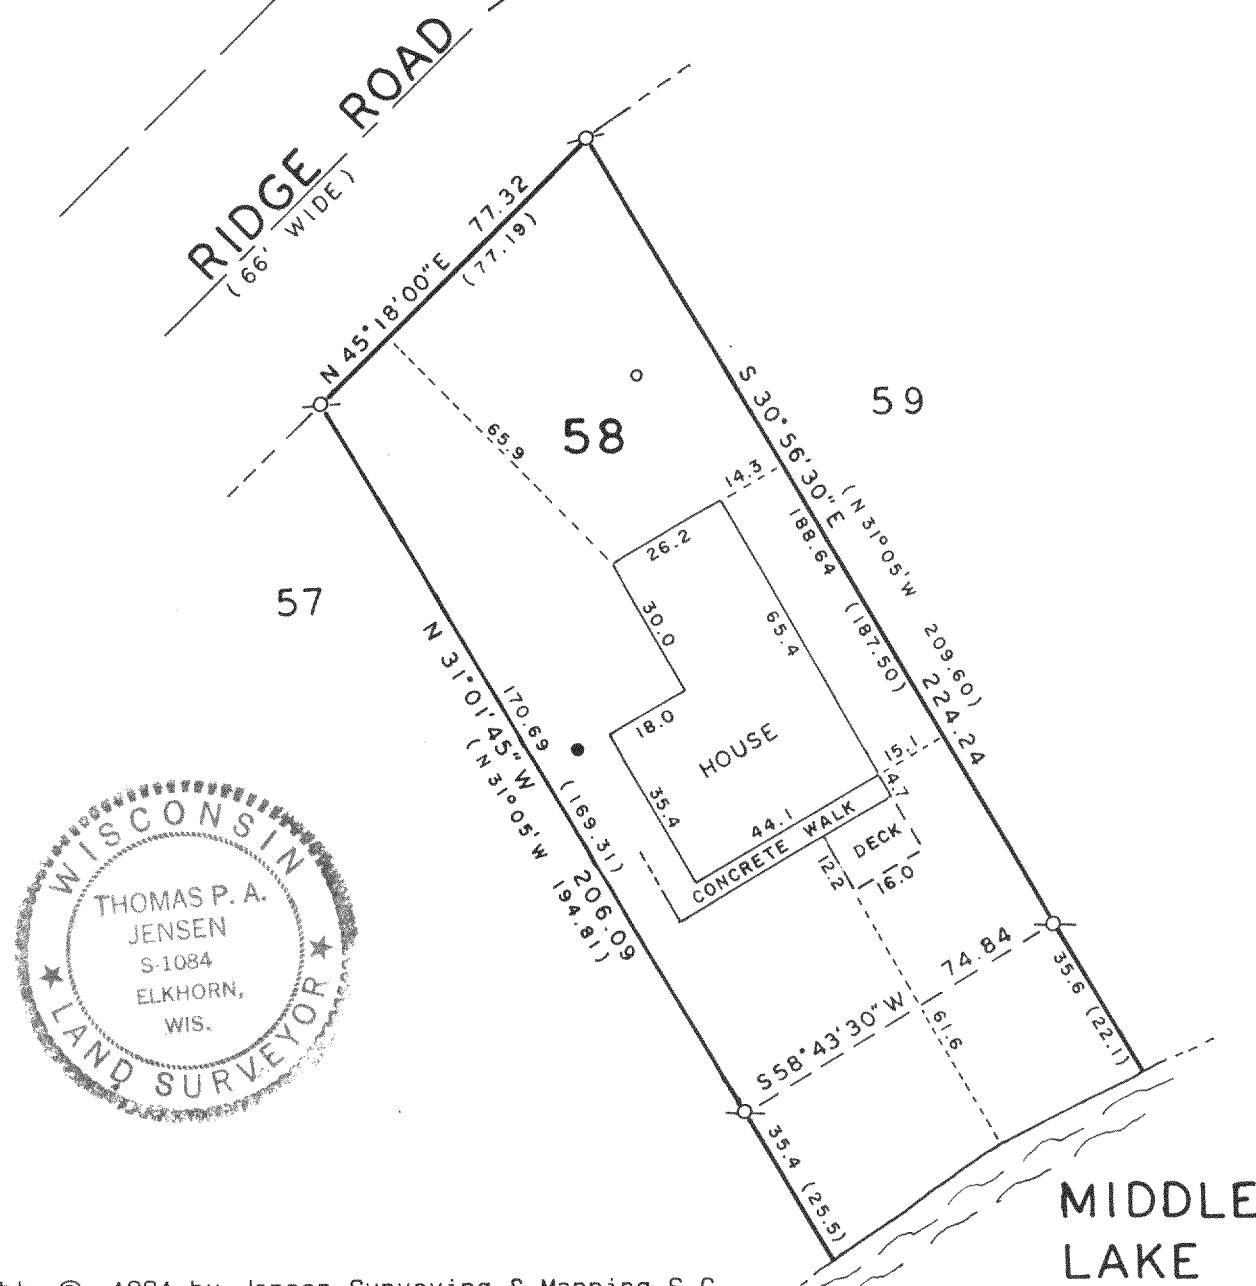

Copyright © 1991 by Jensen Surveying & Mapping S.C.  
All rights reserved. No part of this survey plat may be reproduced or transmitted in any form by any means - graphic, electronic, or mechanical, including photocopying, tracing, or information storage and retrieval systems - without permission in writing from Thomas P.A. Jensen.

I, Thomas P.A. Jensen, Wisconsin Registered Land Surveyor, do hereby certify that this survey was performed by me, or under my direction, in full compliance with the owner's/agent's instructions and Chapter A-E 7 of the Wisconsin Administrative Code ' Minimum Standards For Property Surveys ', and that this map is an accurate representation thereof to the best of my knowledge and belief.

Note: This survey plat is not certified unless signed and sealed in red ink.

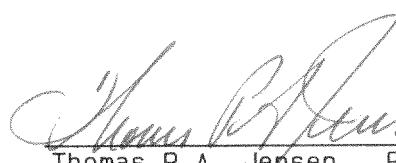  
Thomas P.A. Jensen R.L.S. 1084

## Legend

- o- Found iron pipe
- ( ) Recorded as dimension
- Well
- o Septic vent

**Jensen Surveying & Mapping S.C.**

Mapping date: OCTOBER 3, 1991

45 South Wisconsin Street P.O. Box 322  
Elkhorn, Wisconsin 53121.  
(414) 723-3434

Revisions: \_\_\_\_\_

Sheet 1 of 1 Sheets

Scale: 1 = 40'

Job reference number:

1991.178



416-760

0 20 40 80 120

NBS1 00027